RASTER

PARENT PARCEL: 15-00-096-000-003
CHILD PARCEL: --SAME--
STARTING POINT: INT WEBSTER RD AND S.R. 301

06-01348-C

N
W E
S

AC. CORR. PER DEED

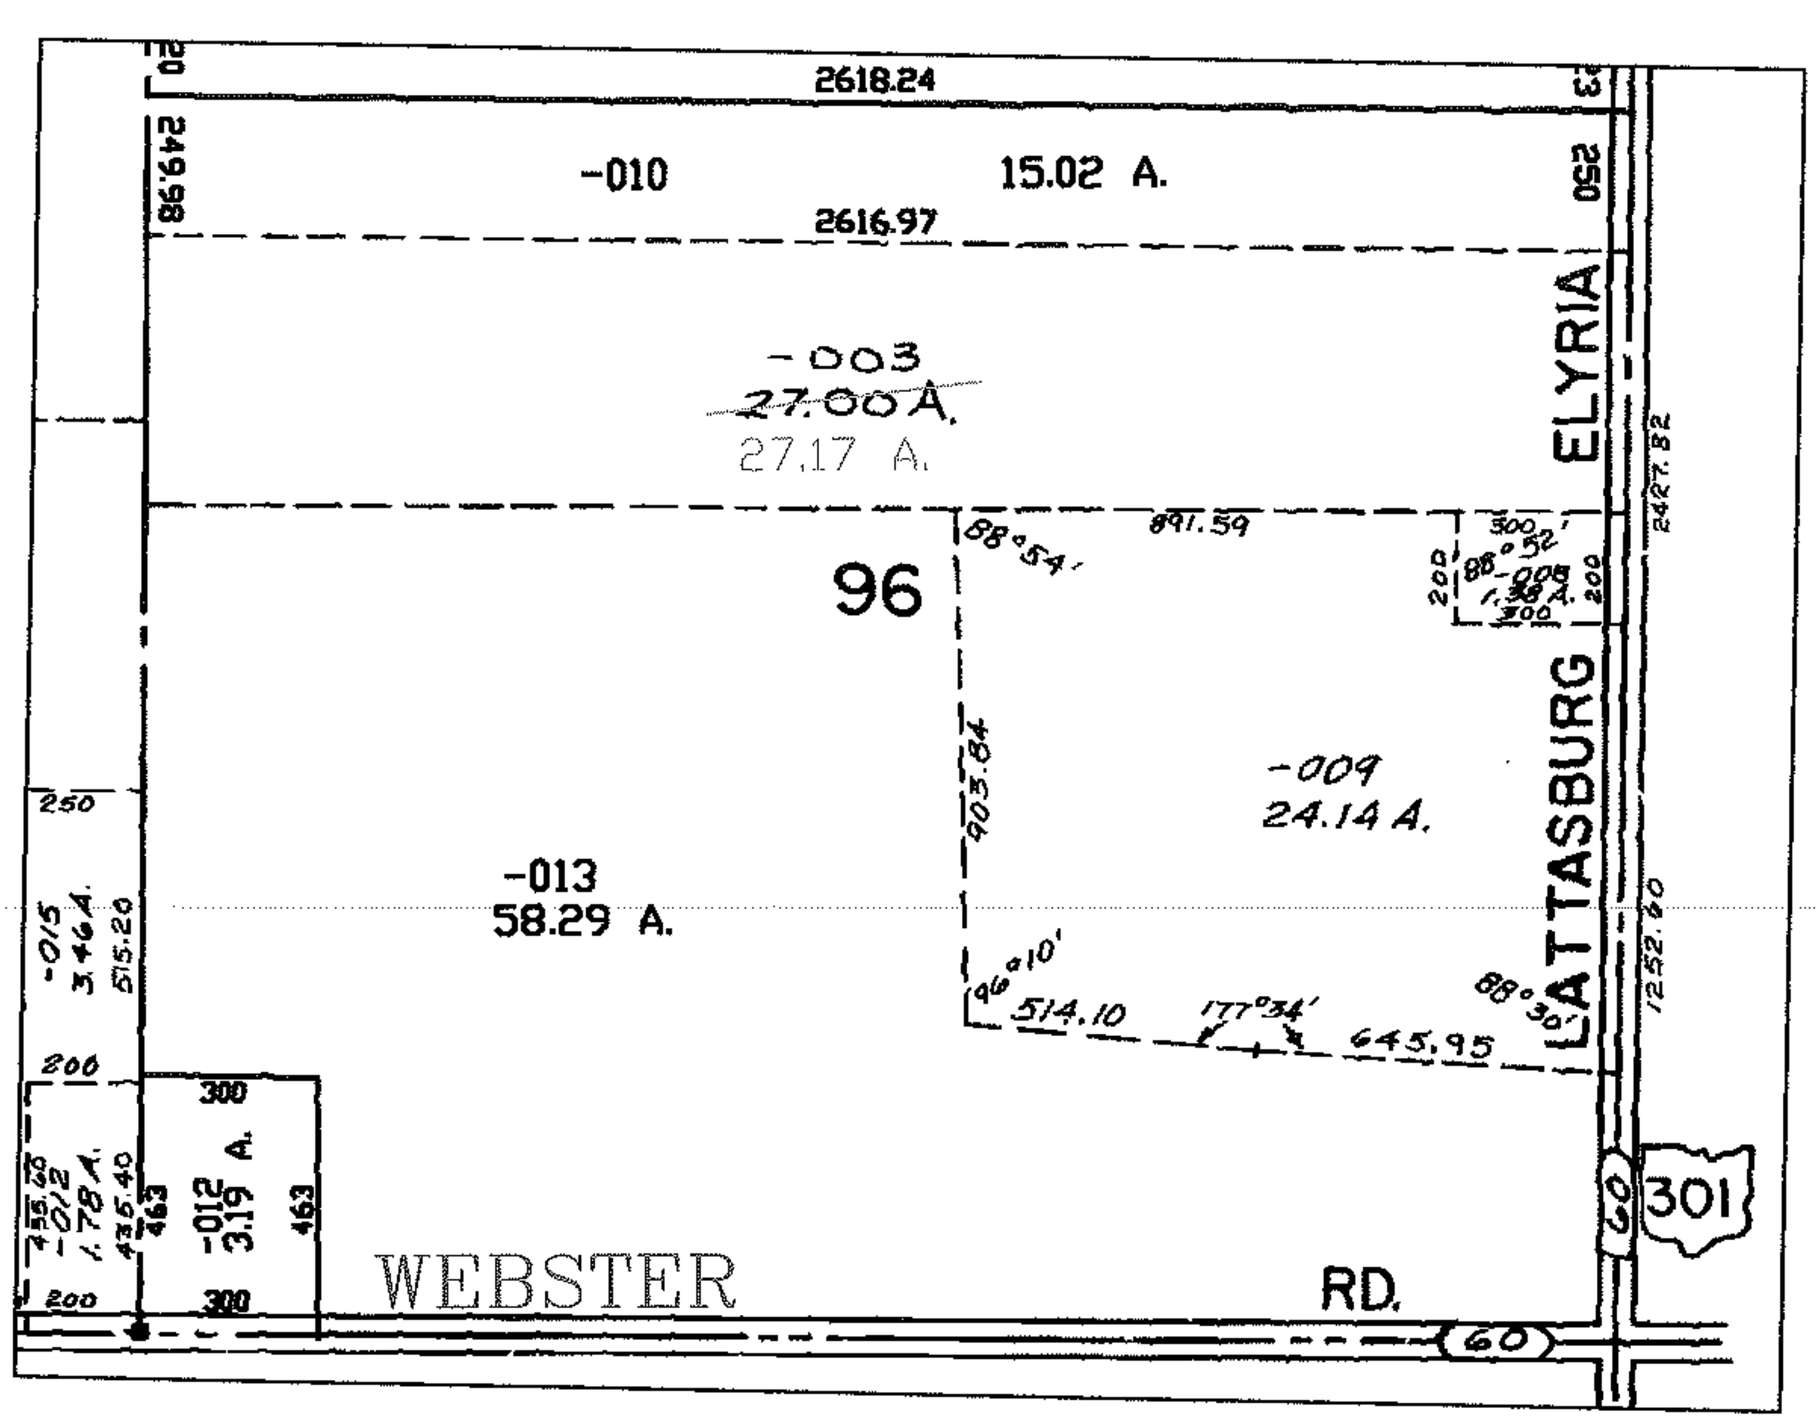

SPLITS/DEEDS PROCESSED

LORAIN COUNTY TAX MAP DEPARTMENT
226 MIDDLE AVE. ELYRIA, OHIO

SURVEYED BY: N/A
CLOSURE: N/A
MAP PAGE(S): 15-00-096-A
APPROVED BY: DRH DATE: 6/1/2006
SCALE: 1"= 200 PRIOR INSTRUMENT: 1354/377