RASTER

PARENT PARCEL: 12-00-015-000-028, -029
CHILD PARCEL: 12-00-015-000-079, -080, -081, -082
STARTING POINT: INT CL BOONE RD AND S.R. 82

06-01370-U

N
W E
S

UNCOMBINATION PER DEED

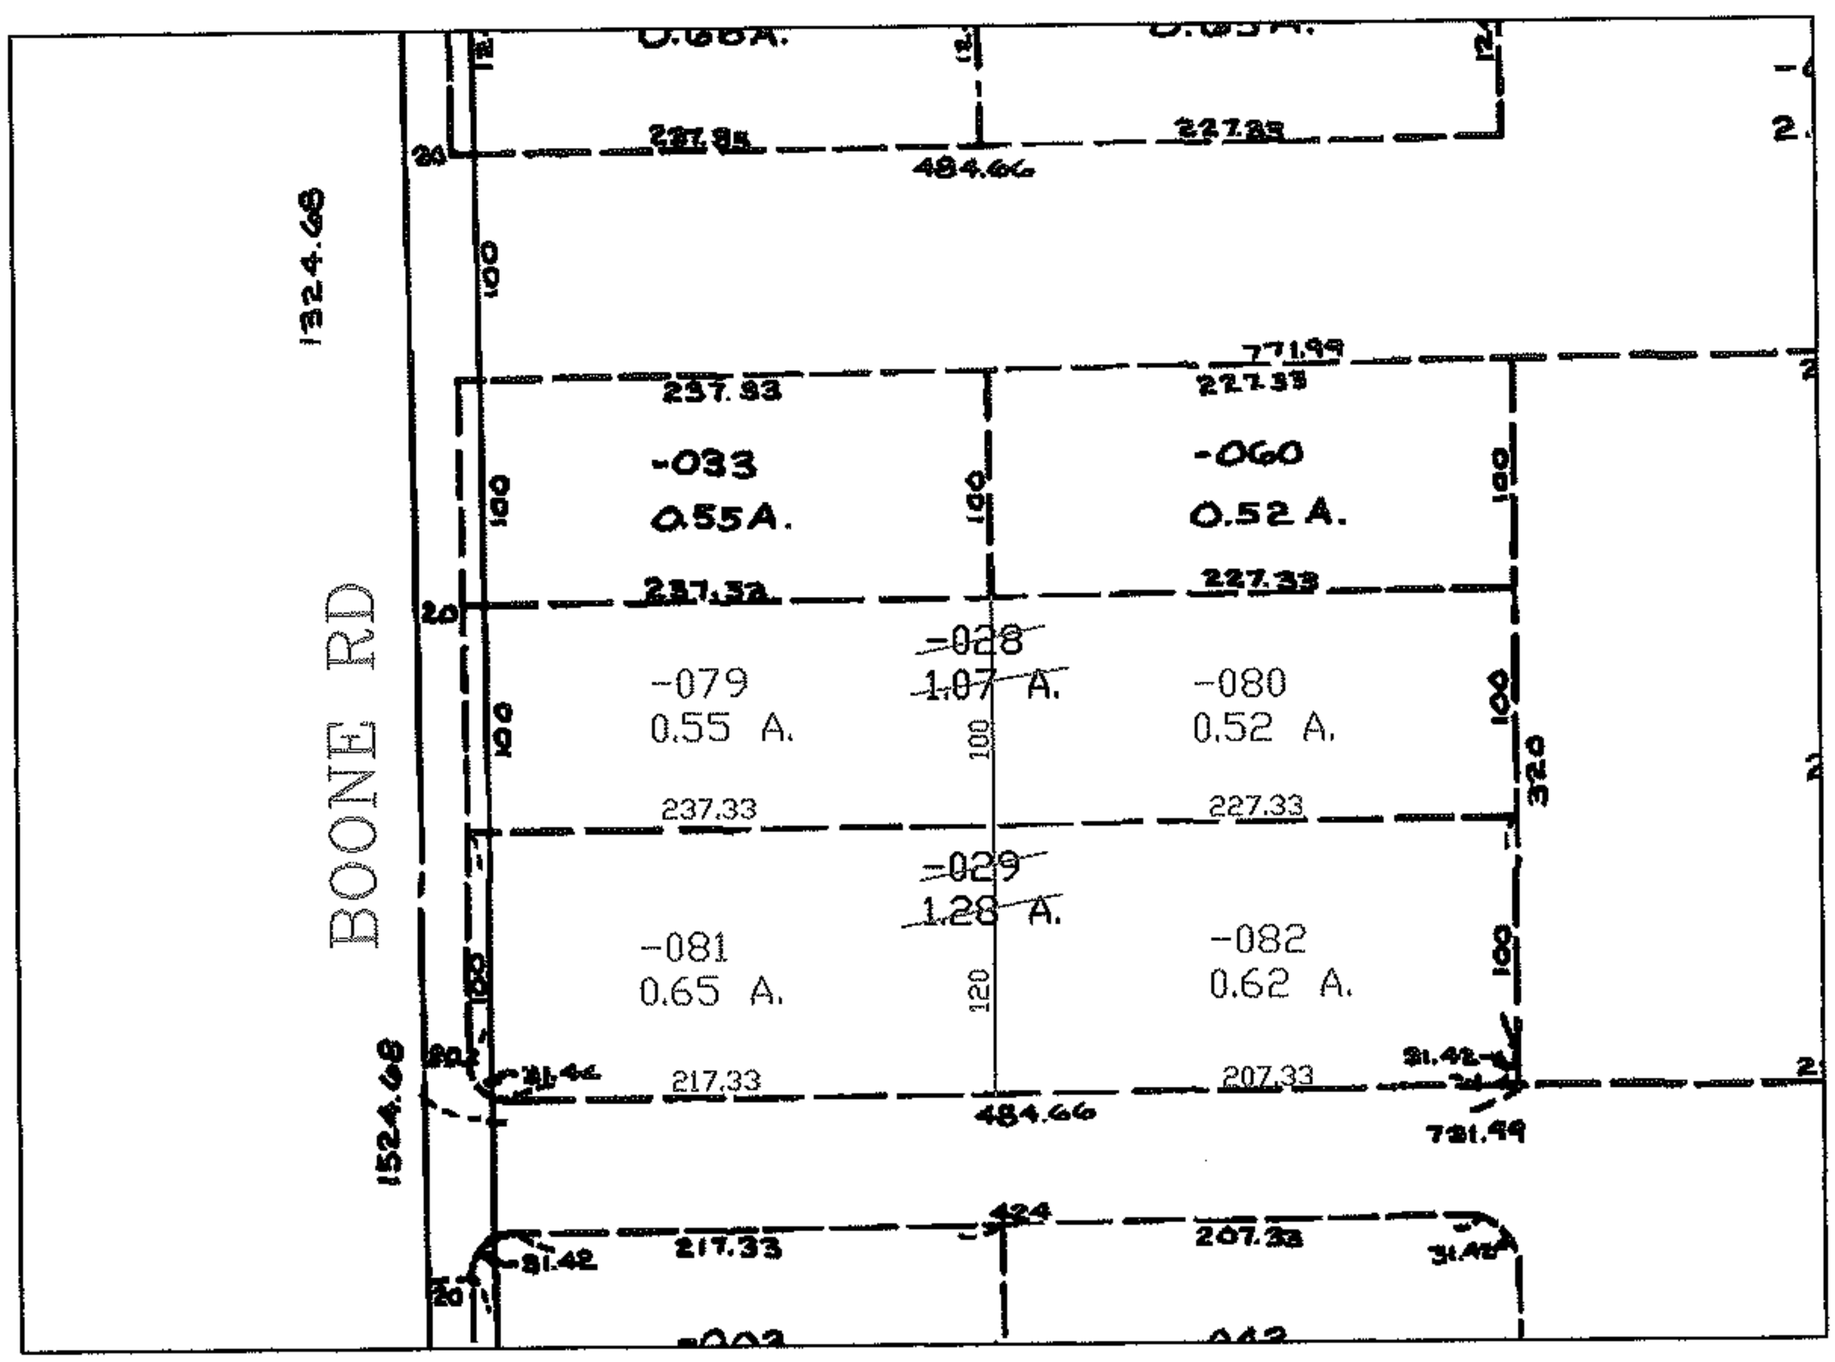

SPLITS/DEEDS PROCESSED
LORAIN COUNTY TAX MAP DEPARTMENT
226 MIDDLE AVE. ELYRIA, OHIO

SURVEYED BY: N/A
CLOSURE: 1:10,000
MAP PAGE(S): 12-00-015-A
APPROVED BY: DRH DATE: 7/20/2006
SCALE: 1"= 200 PRIOR INSTRUMENT: