RASTER

PARENT PARCEL: 03-00-107-101-016

CHILD PARCEL: 03-00-107-101-064 & -065

STARTING POINT:

06-01441-C

N

W E

S

UNCOMBINATION PER DEED

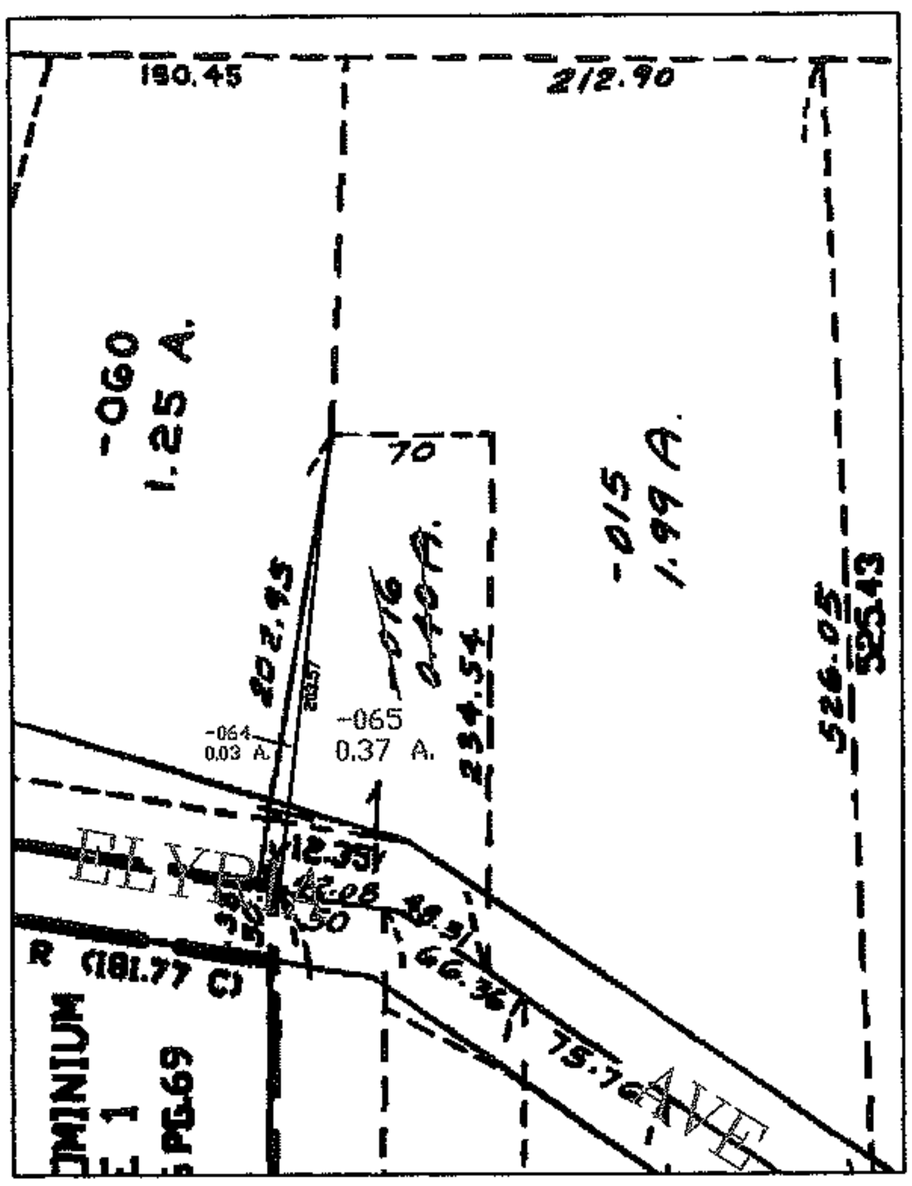

SPLITS/DEEDS PROCESSED

LORAIN COUNTY TAX MAP DEPARTMENT
226 MIDDLE AVE. ELYRIA, OHIO

SURVEYED BY: N/A

CLOSURE: N/A

MAP PAGE(S): 03-00-107-A

APPROVED BY: DRH DATE: 12/21/2006

SCALE: 1"= 200 PRIOR INSTRUMENT: OR 1365/359