RASTER

PARENT PARCEL: 02-01-006-184-021

CHILD PARCEL: --SAME--

STARTING POINT: INT MEISTER RD AND VACATED KAY AVE

07-01455-C

MAP CORRECTION ONLY
PARCEL ALREADY EXISTS

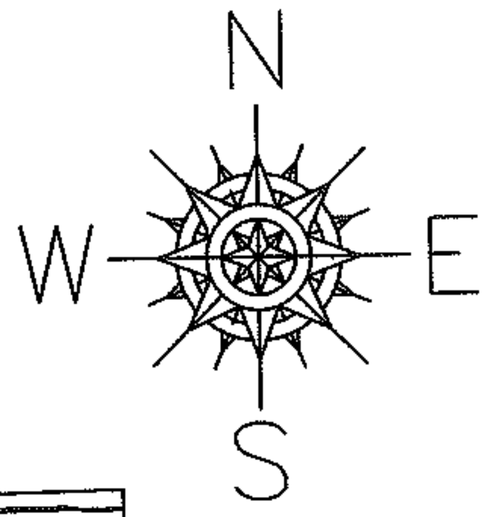

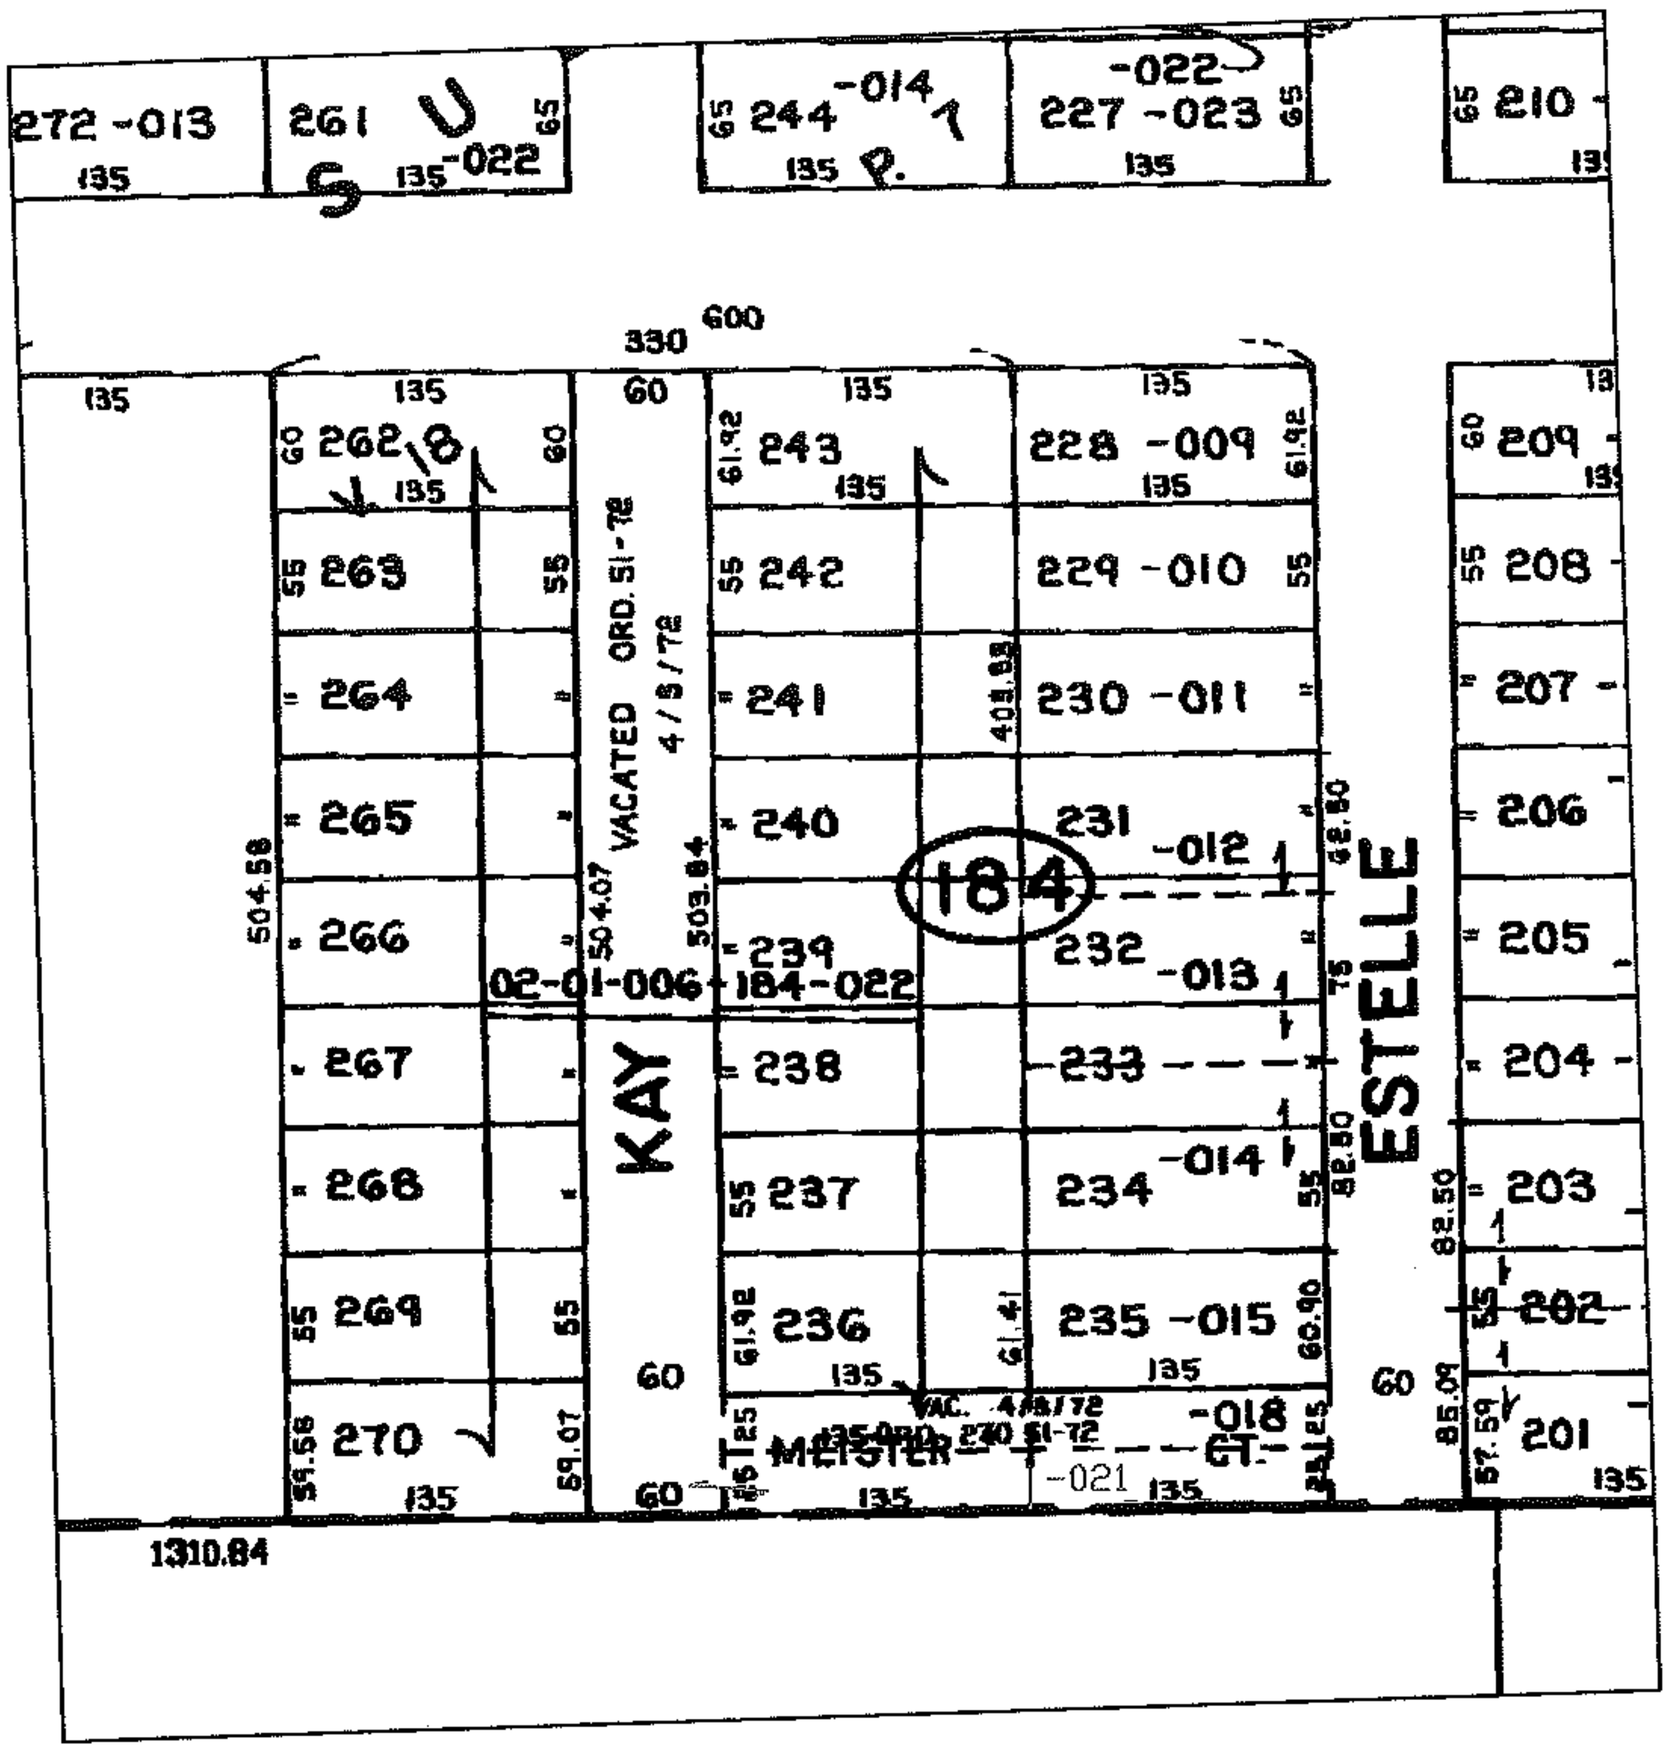

SPLITS/DEEDS PROCESSED

LORAIN COUNTY TAX MAP DEPARTMENT
226 MIDDLE AVE. ELYRIA, OHIO

SURVEYED BY: N/A

CLOSURE: 1:10,000

MAP PAGE(S): 02-01-006-G

APPROVED BY: DRH DATE: 2/15/2007

SCALE: 1"= 200 PRIOR INSTRUMENT: DV 1058/499