RASTER

PARENT PARCEL: --NONE--

CHILD PARCEL: 07-00-035-900-003

STARTING POINT: INT SHADY DR AND SUGAR RIDGE

07-01456-C

DROP -039

ADD -003

PARCEL NUMBERED INCORRECTLY

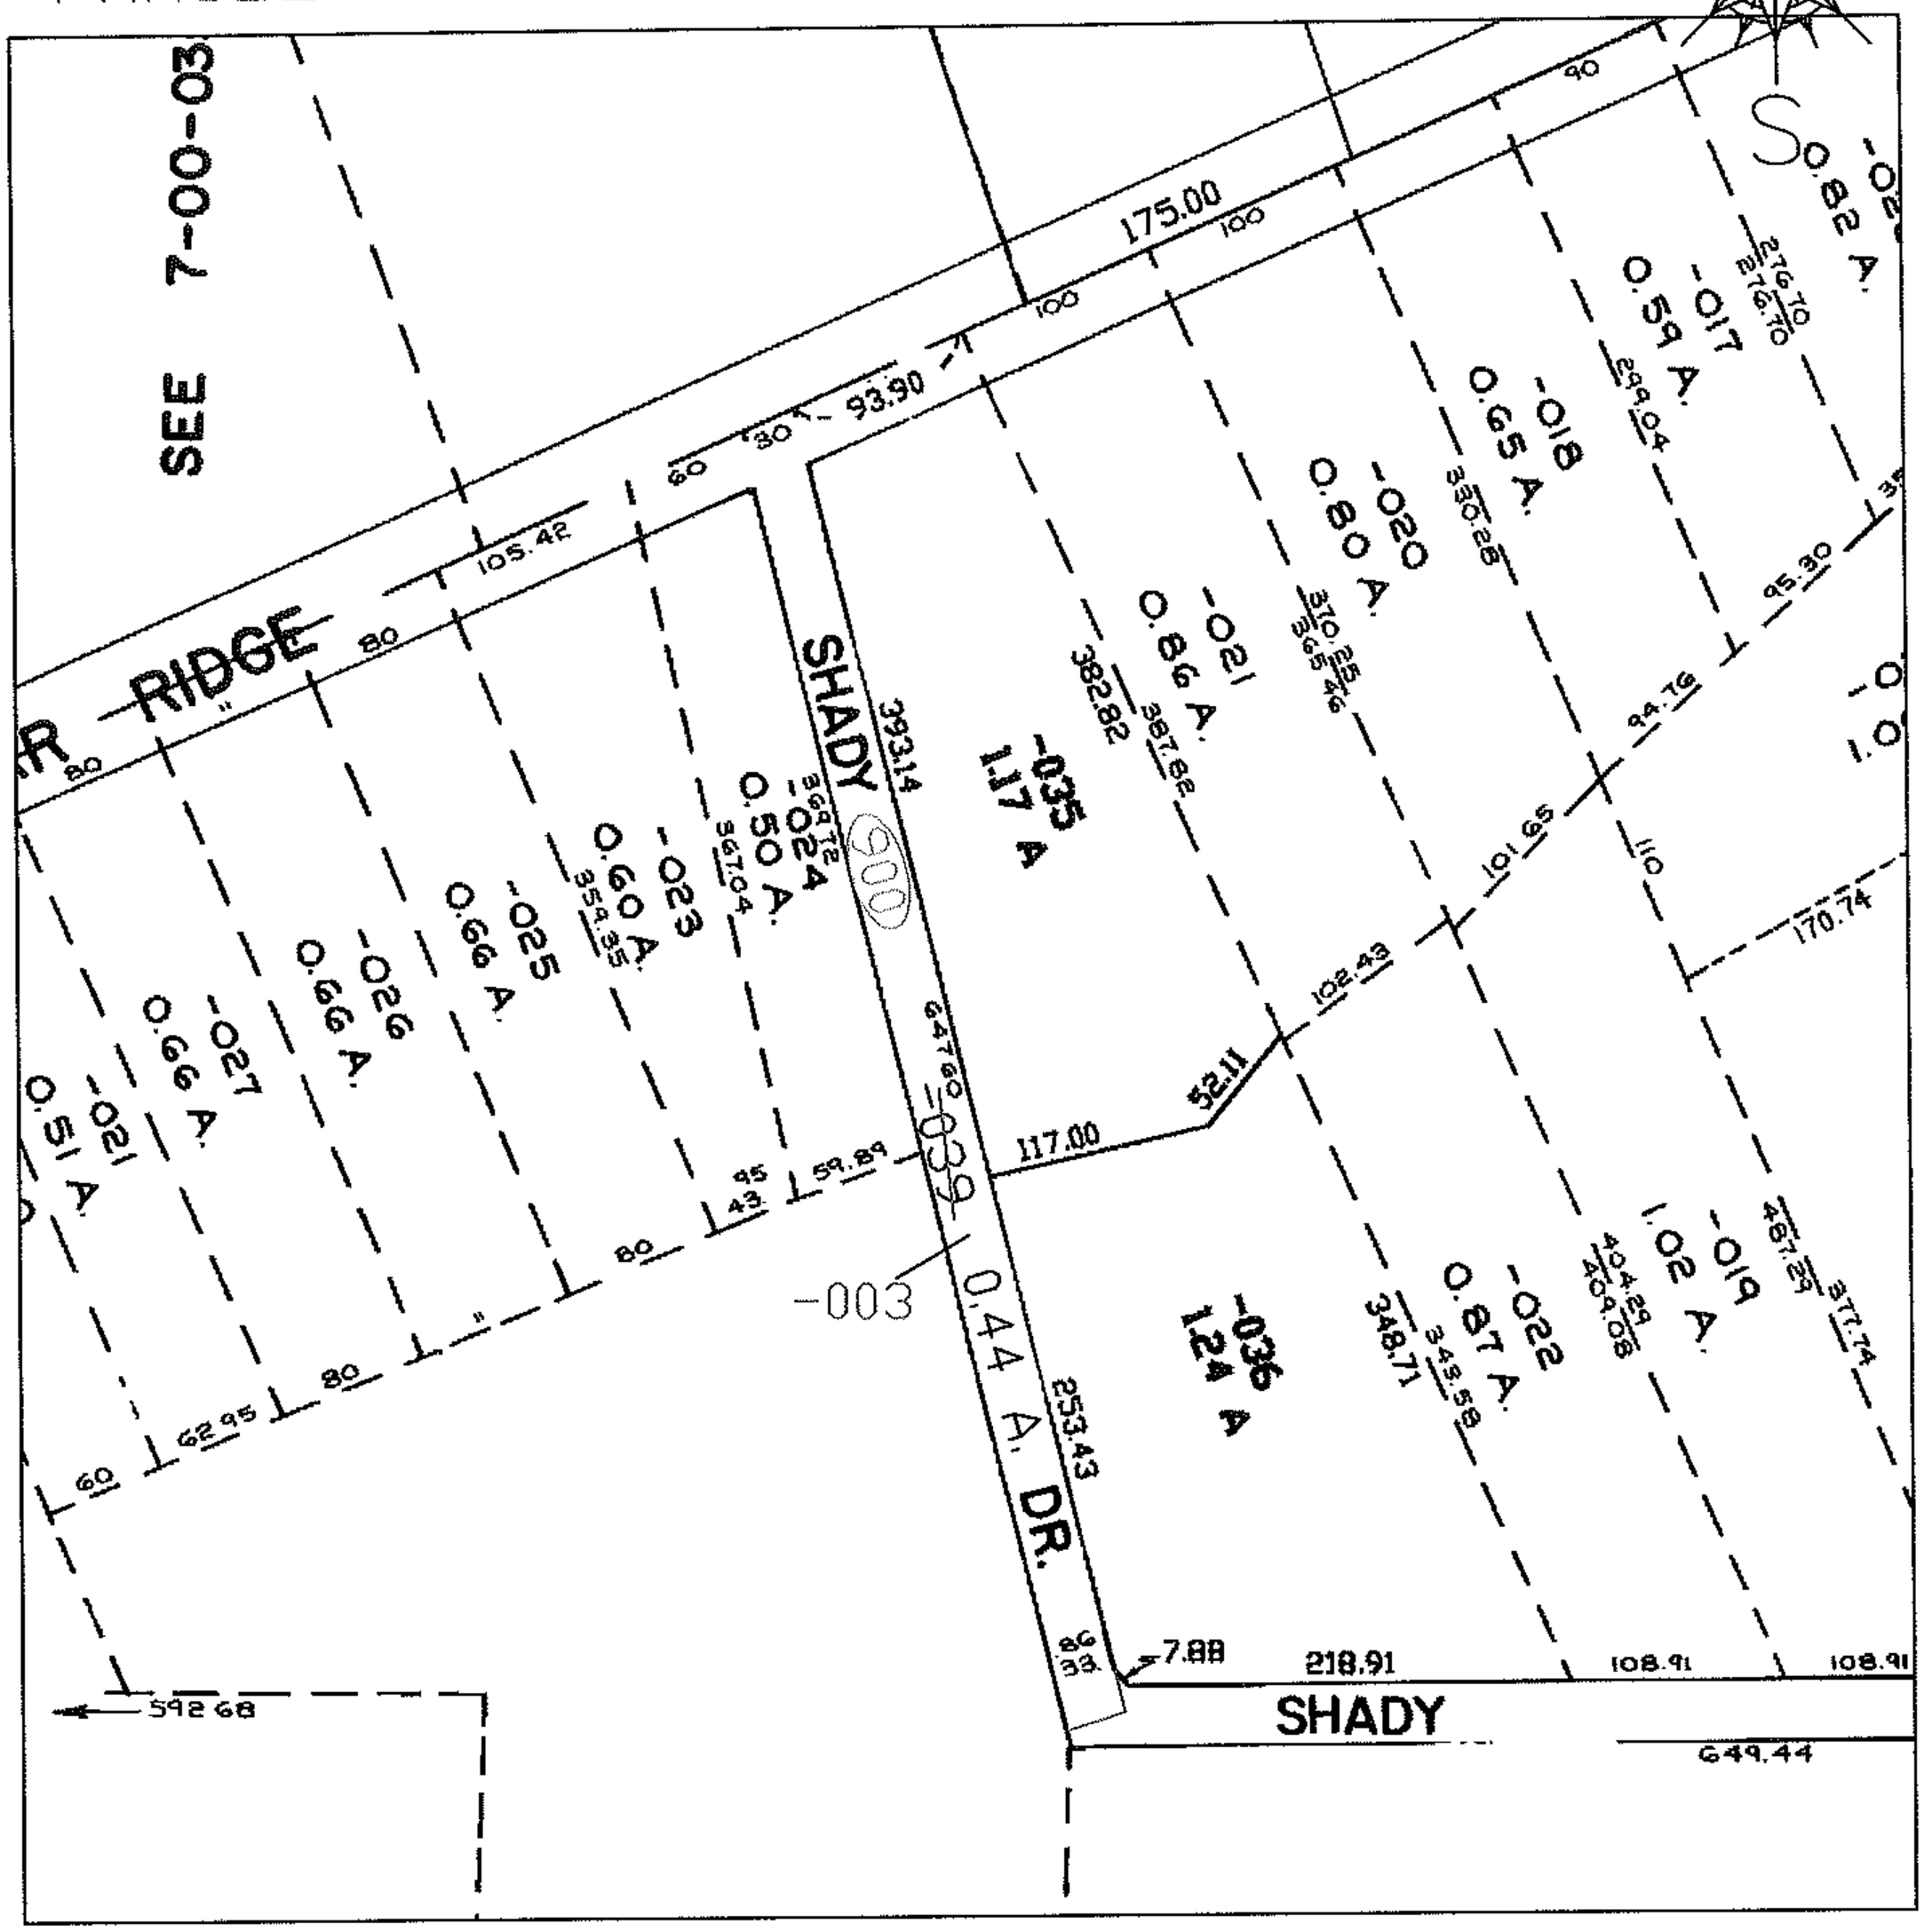

SPLITS/DEEDS PROCESSED

LORAIN COUNTY TAX MAP DEPARTMENT

226 MIDDLE AVE. ELYRIA, OHIO

SURVEYED BY: N/A

CLOSURE: N/A

MAP PAGE(S): 07-00-035-B

APPROVED BY: DRH DATE: 2/9/2007

SCALE: 1"= 200 PRIOR INSTRUMENT: DV 509/186