RASTER

07-1475-X

PARENT PARCEL: 06-25-157-000-026 & -027

CHILD PARCEL: --SAME--

STARTING POINT: INT OHIO ST AND ST. CLAIR ST

CORRS. PER DEED

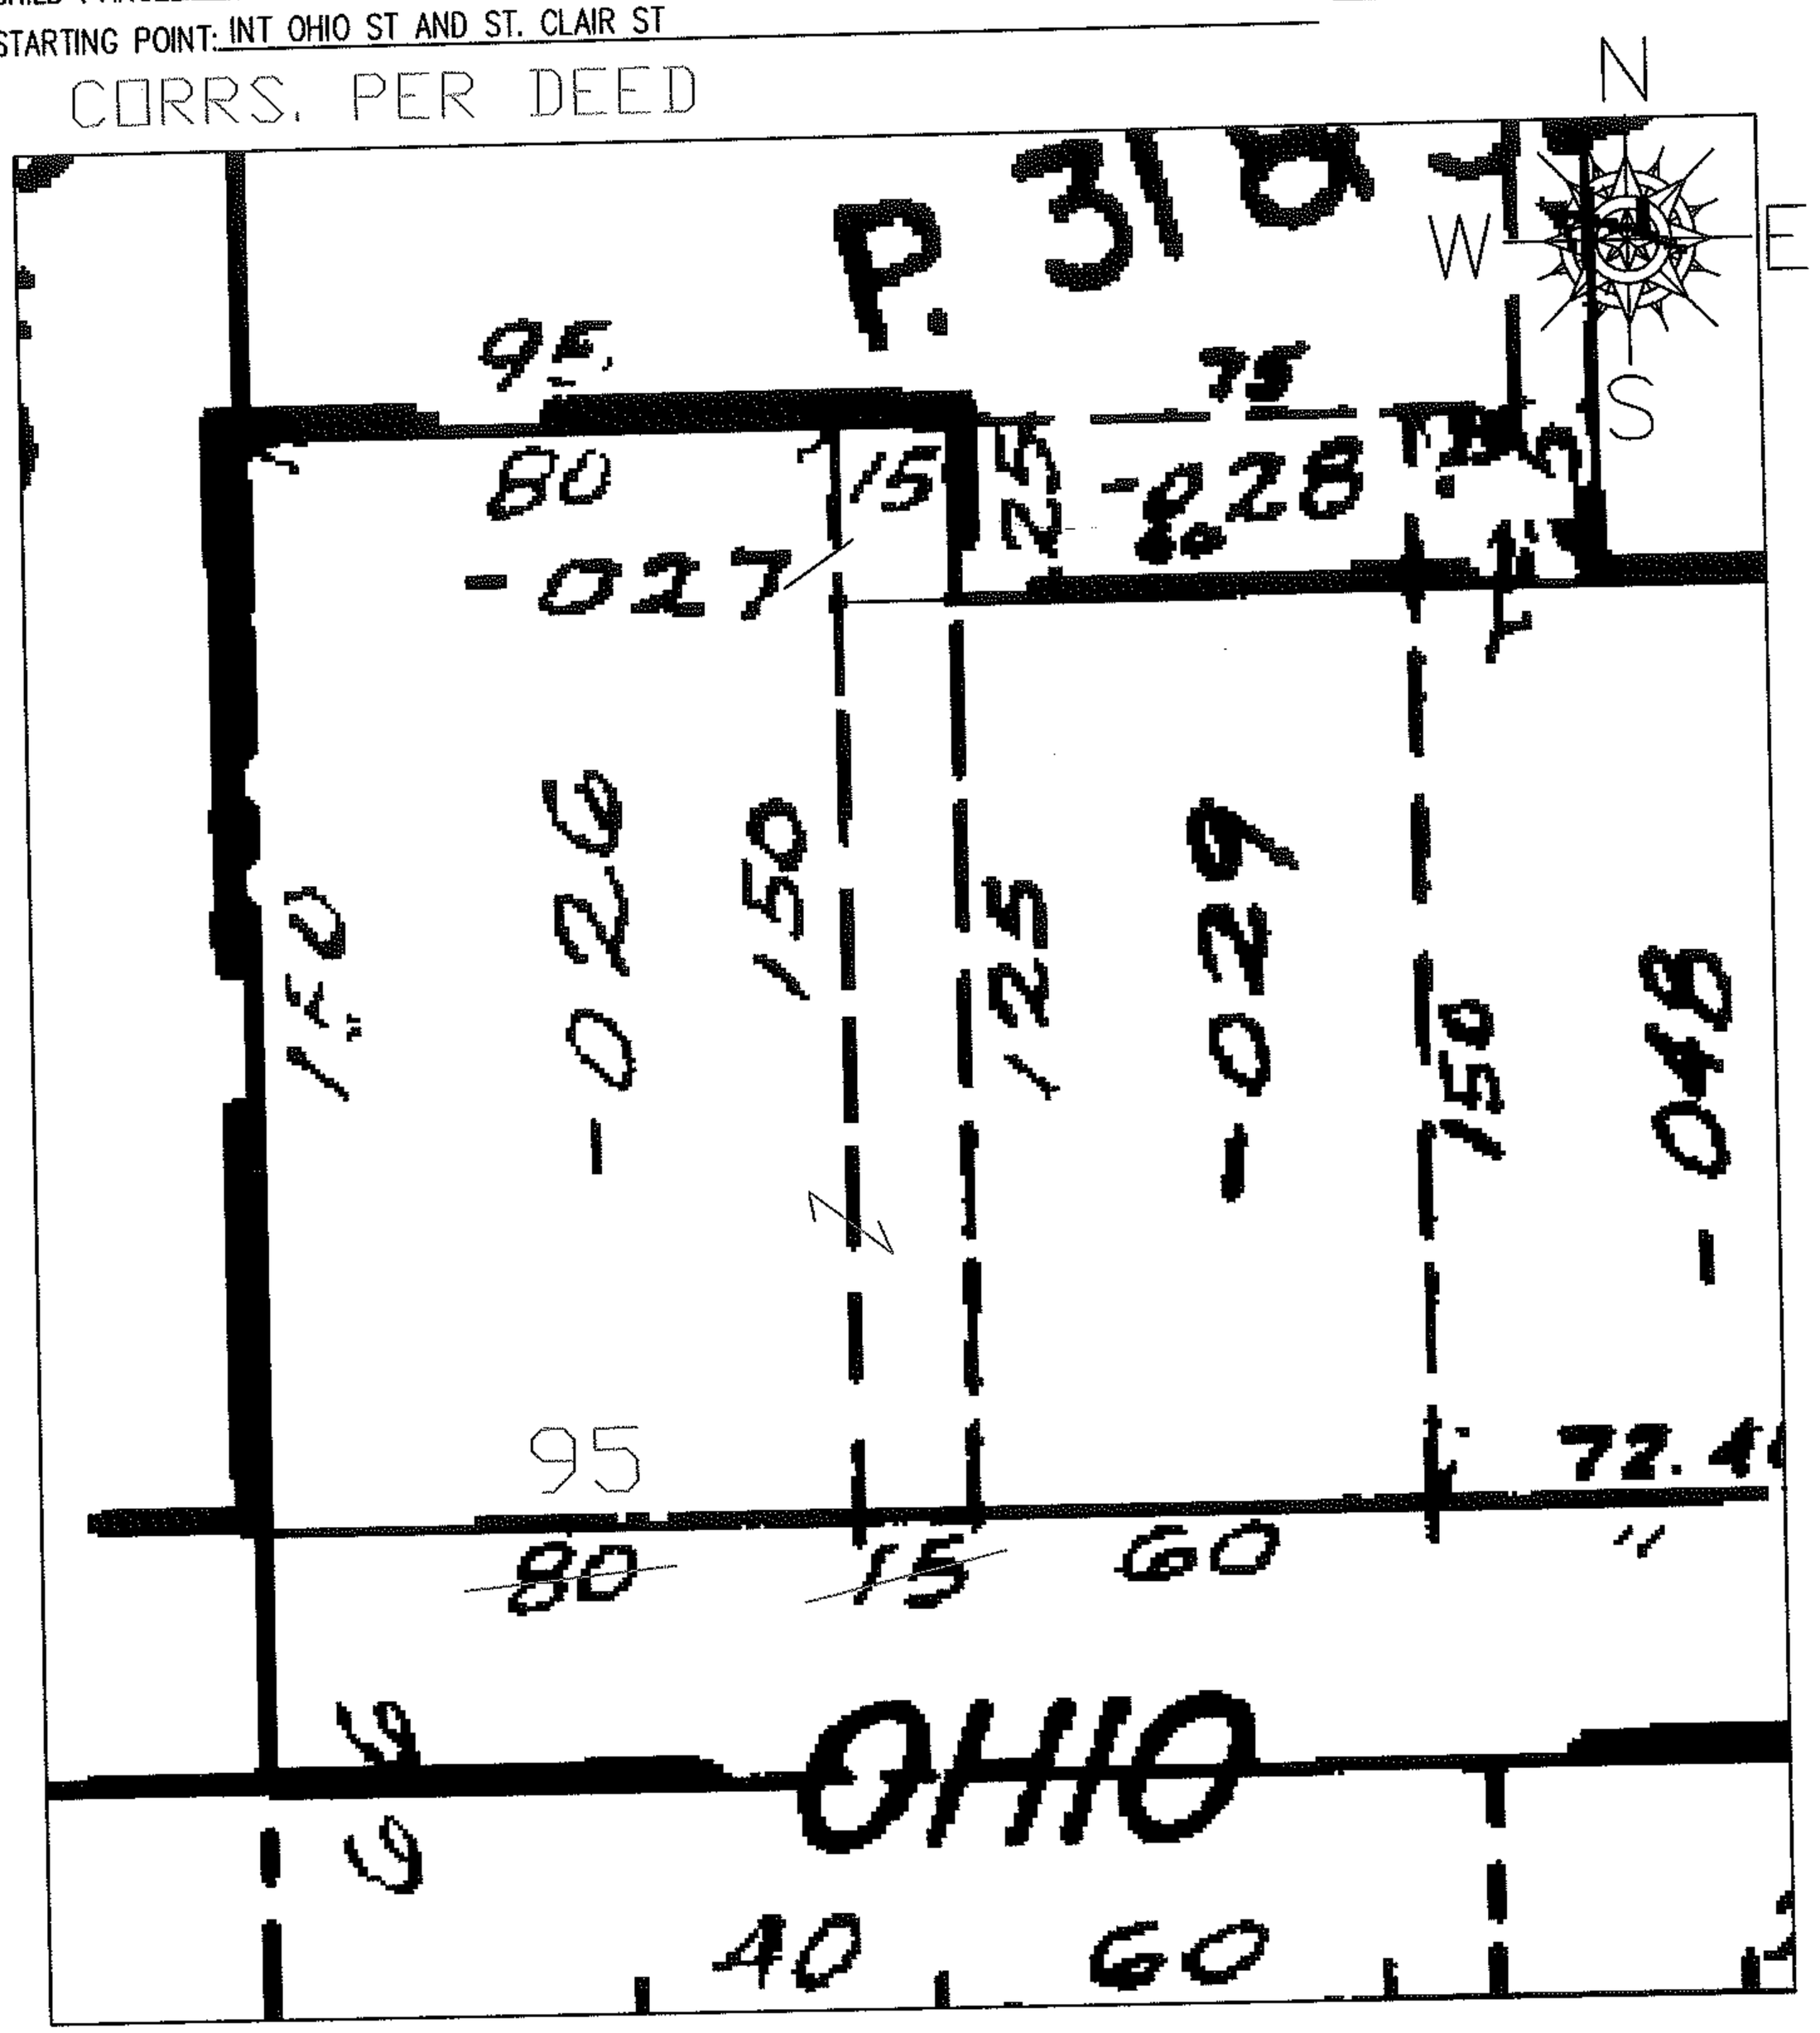

SPLITS/DEEDS PROCESSED

LORAIN COUNTY TAX MAP DEPARTMENT
226 MIDDLE AVE. ELYRIA, OHIO

SURVEYED BY: N/A

CLOSURE: N/A

MAP PAGE(S): 06-102

APPROVED BY: DRH DATE: 5/7/2007

SCALE: 1"= 50 PRIOR INSTRUMENT: 20040993404