RASTER

PARENT PARCEL: 03-00-103-005

CHILD PARCEL: --SAME--

STARTING POINT: INT BROADWAY AND MUSSEY

07-01487-C

FRONTAGE CORR.
TO REFLECT MAP
AND DEED

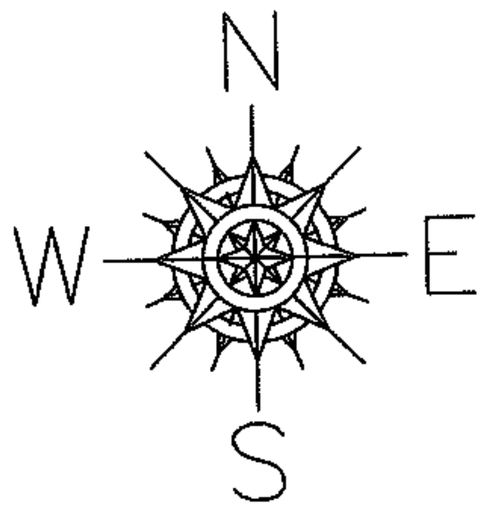

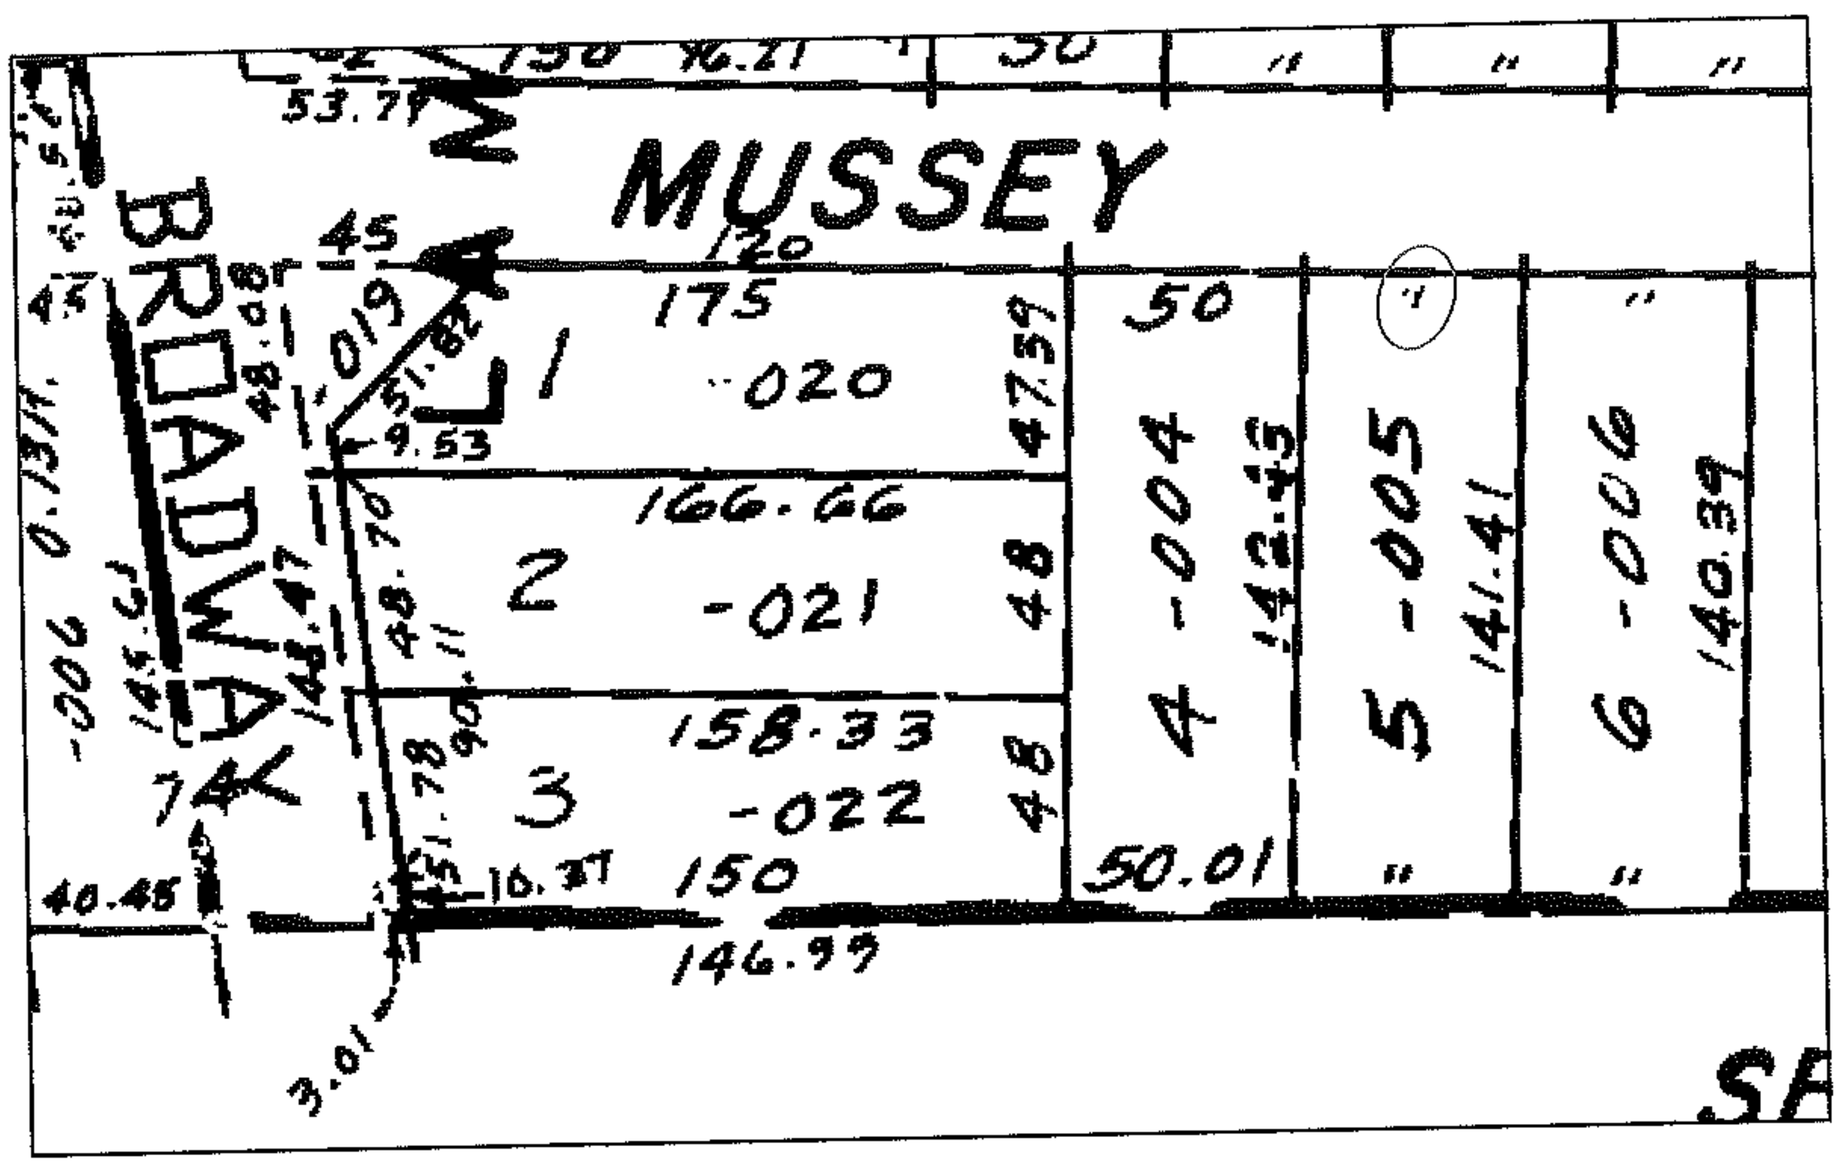

SPLITS/DEEDS PROCESSED

LORAIN COUNTY TAX MAP DEPARTMENT
226 MIDDLE AVE. ELYRIA, OHIO

SURVEYED BY: N/A

CLOSURE: N/A

MAP PAGE(S): 03-00-103-A

APPROVED BY: DRH DATE: 5/7/2007

SCALE: 1"= 100 PRIOR INSTRUMENT: DV 1166/839