RASTER

PARENT PARCEL: 04-00-030-102-012

CHILD PARCEL: --SAME--

STARTING POINT:

07-01513-C

MAP CORRECTION ONLY
PARCEL NOT ON MAP

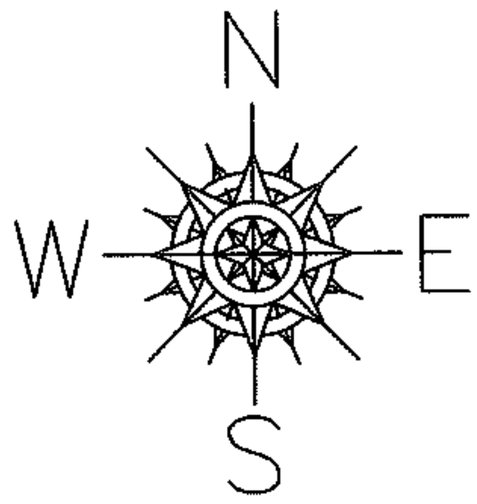

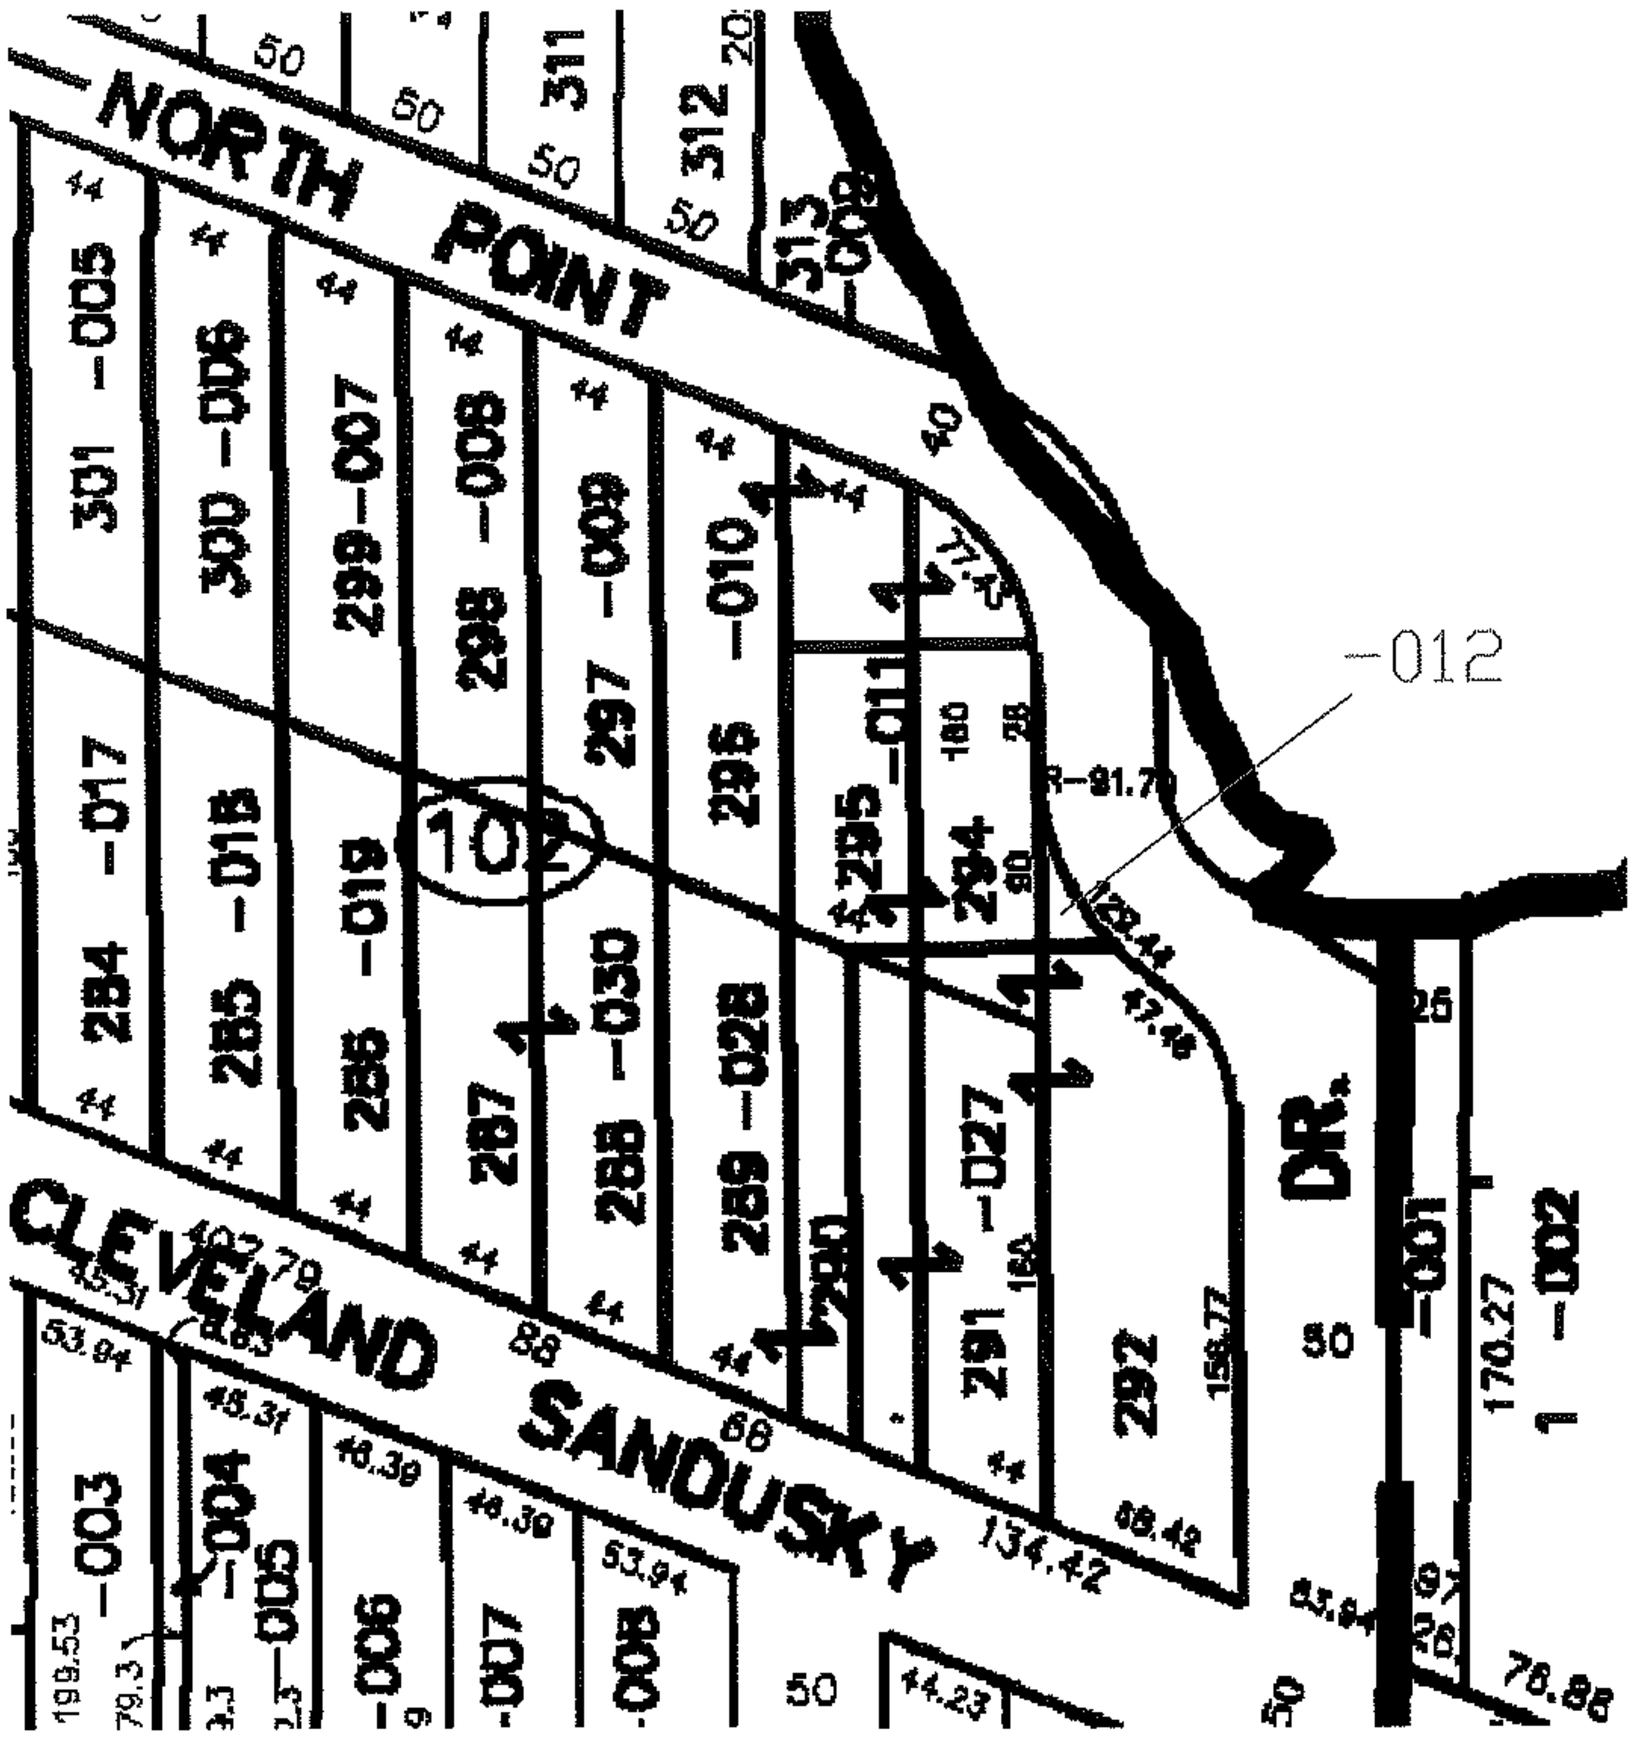

SPLITS/DEEDS PROCESSED

LORAIN COUNTY TAX MAP DEPARTMENT
226 MIDDLE AVE. ELYRIA, OHIO

SURVEYED BY: J. W. WARDEN

CLOSURE: 1:10,000

MAP PAGE(S): ~~04-00-019-02~~ 04-00-030-A

APPROVED BY: DRH DATE: 8/3/2007

SCALE: NOT TO SCALE PRIOR INSTRUMENT: 19980526741