RASTER

PARENT PARCEL: 06-25-067-103-011

CHILD PARCEL: --SAME--

STARTING POINT: INT CL CLARK AND WILLAMS

07-01540-C

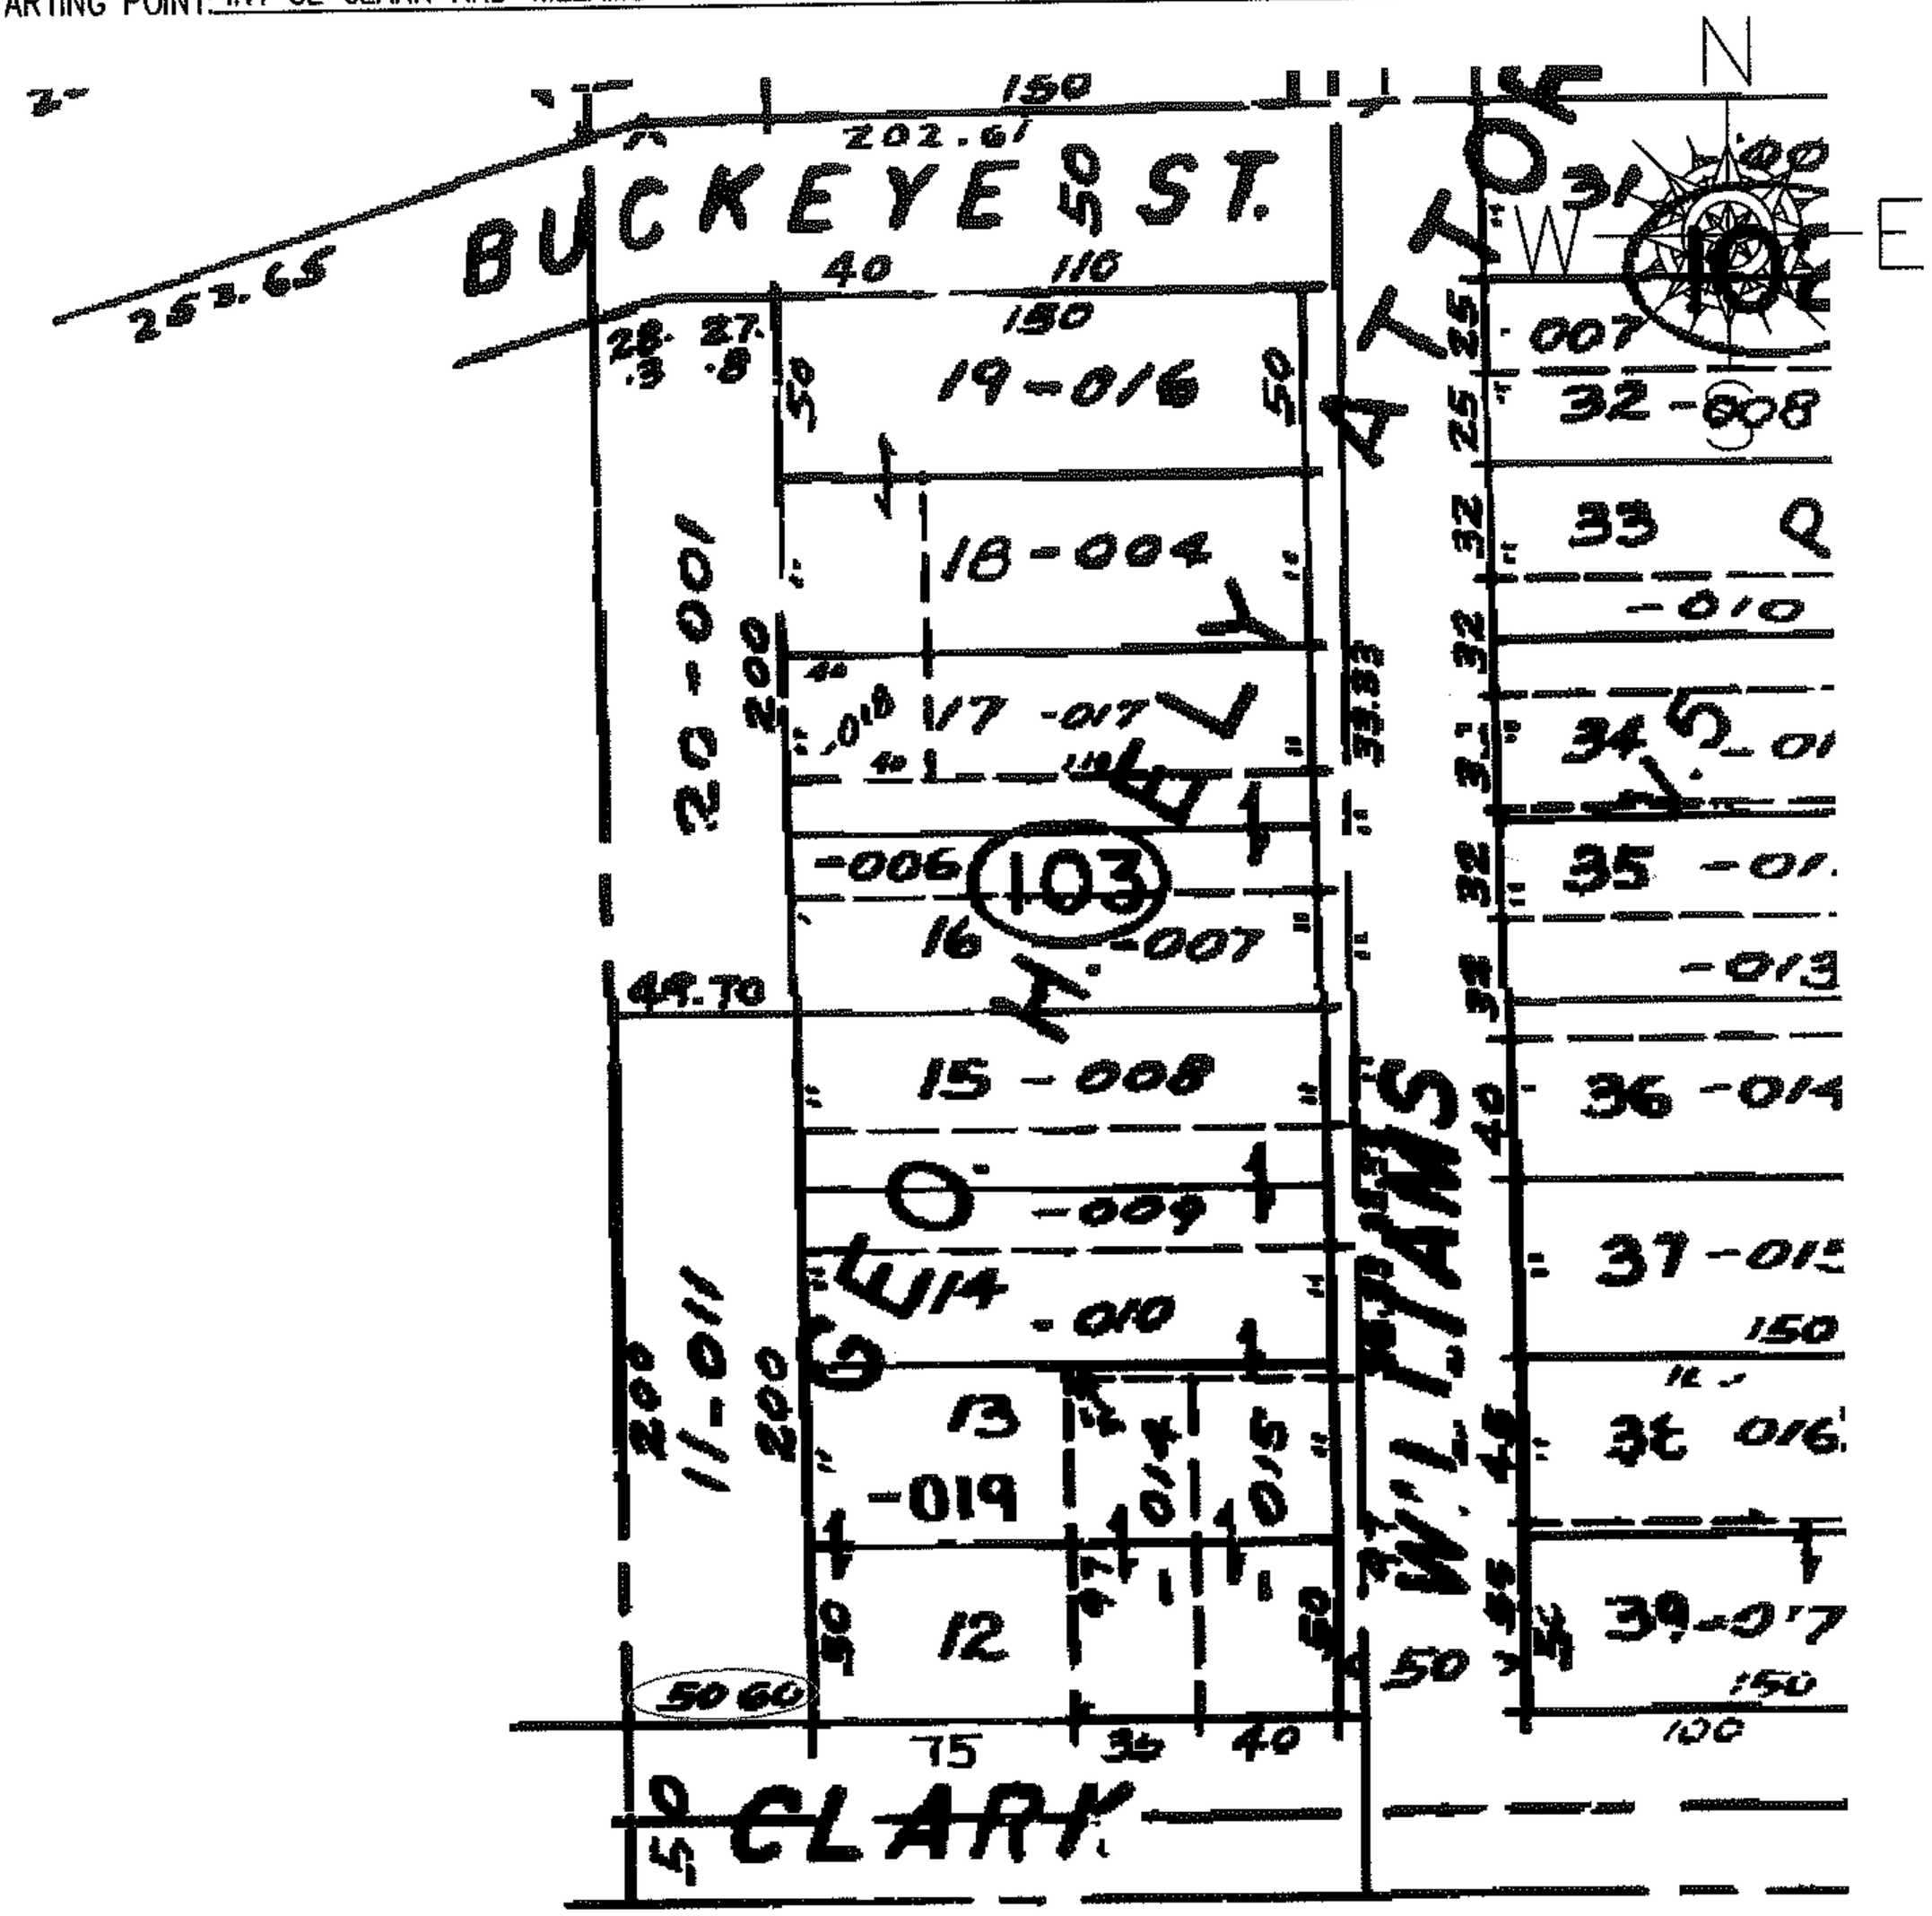

FRONTAGE CORR

PER DEED AND MAP

SPLITS/DEEDS PROCESSED

LORAIN COUNTY TAX MAP DEPARTMENT
226 MIDDLE AVE. ELYRIA, OHIO

SURVEYED BY: N/A

CLOSURE: N/A

MAP PAGE(S): 6-104

APPROVED BY: DRH DATE: 10/10/2007

SCALE: NOT TO SCALE PRIOR INSTRUMENT: 20030907455