RASTER

PARENT PARCEL: 02-01-003-188-001

CHILD PARCEL: --SAME--

STARTING POINT: 25TH AND BROADWAY

07-01548-C

DEPTH CORR PER PLAT AND DEED

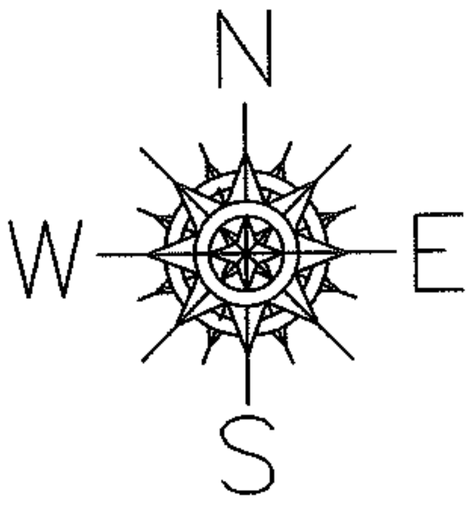

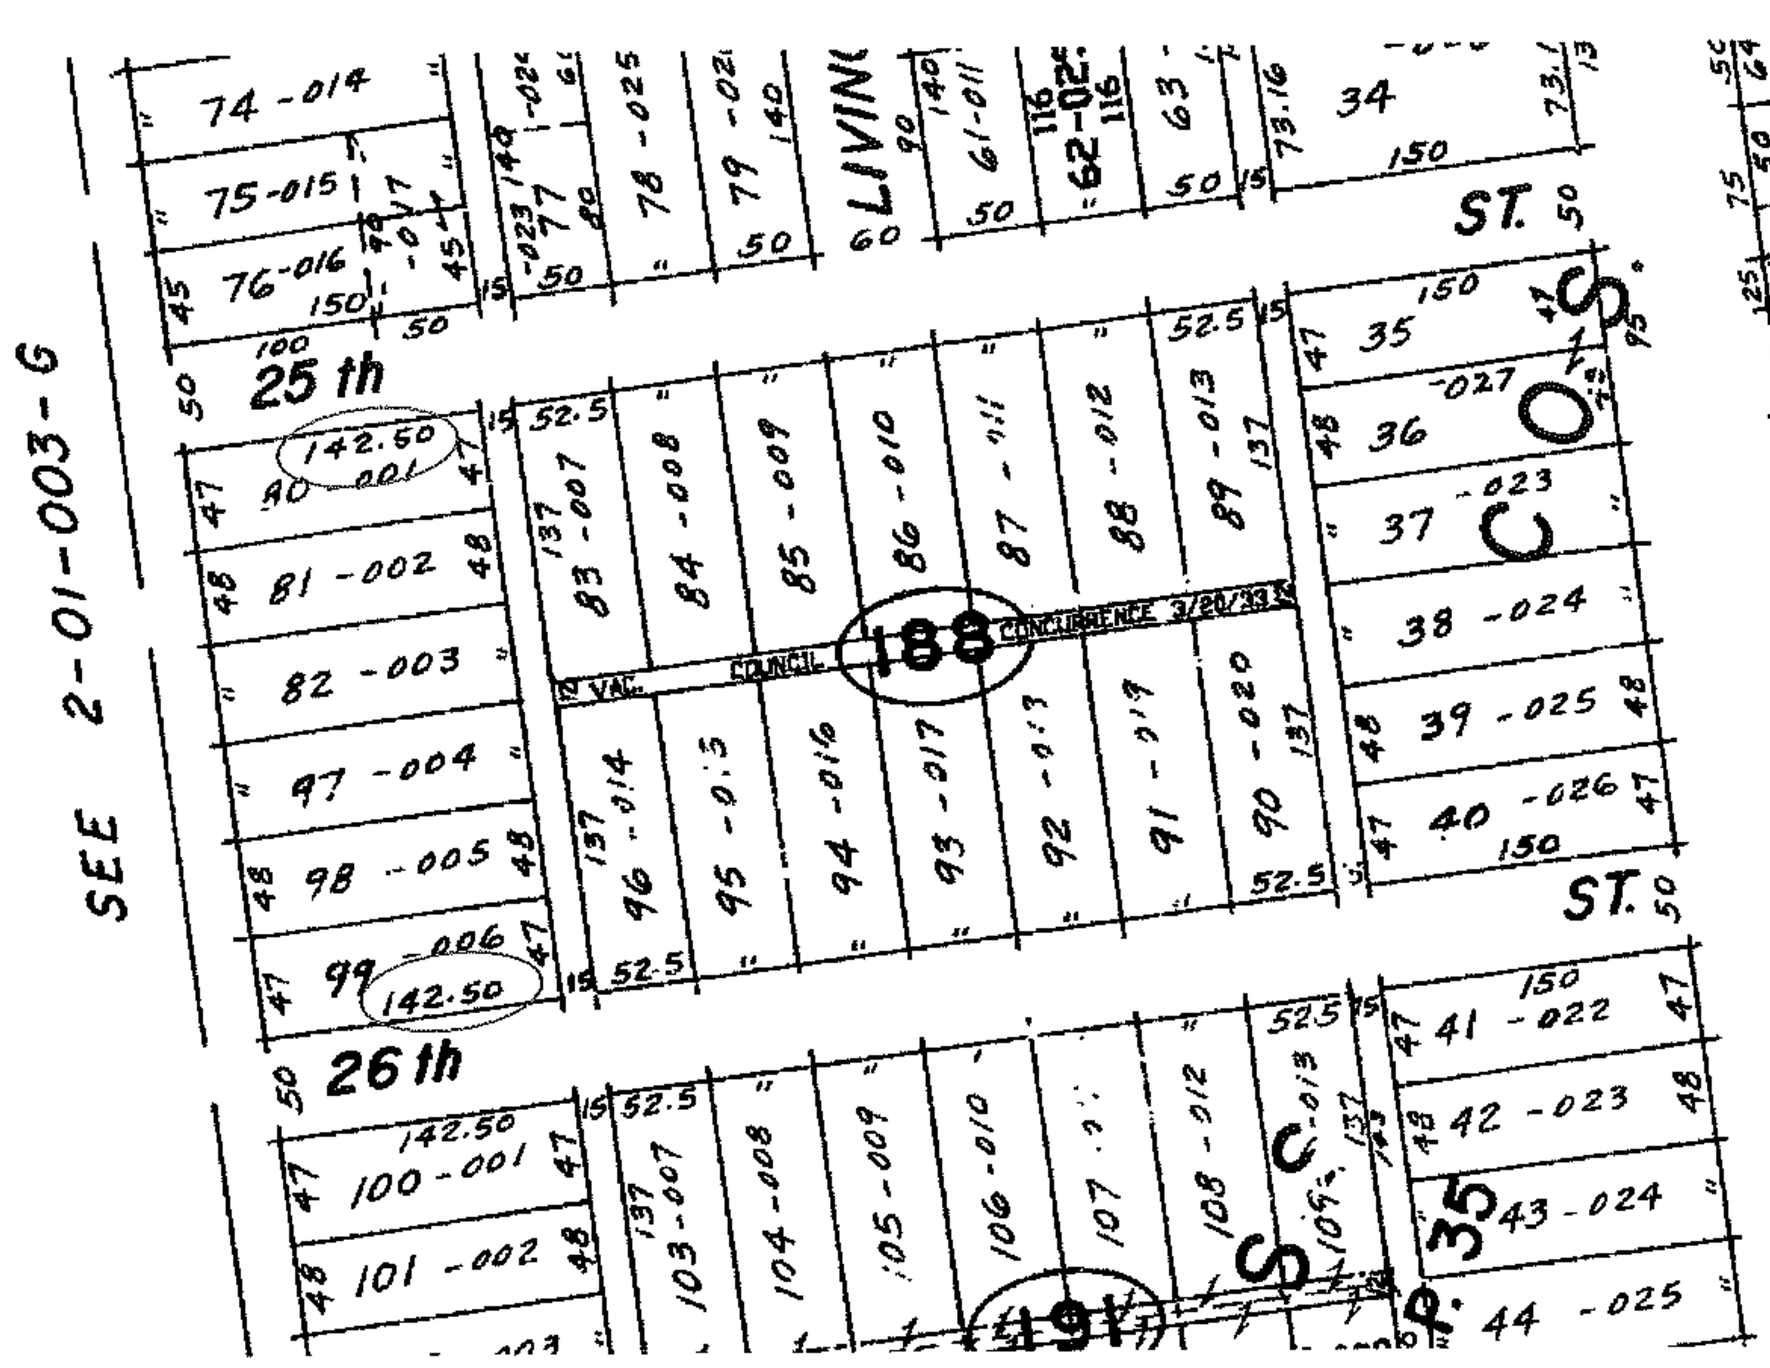

SPLITS/DEEDS PROCESSED

LORAIN COUNTY TAX MAP DEPARTMENT
226 MIDDLE AVE. ELYRIA, OHIO

SURVEYED BY: N/A

CLOSURE: N/A

MAP PAGE(S): 02-01-003-H

APPROVED BY: DRH DATE: 10/19/2007

SCALE: NOT TO SCALE PRIOR INSTRUMENT: 2007020997