Rastet

PARENT PARCEL: 04-00-012-900-001
CHILD PARCEL: --SAME--
STARTING POINT: WELTER SUB NO. 1

07-01559-C

AC. CORR. CALC PER PLAT

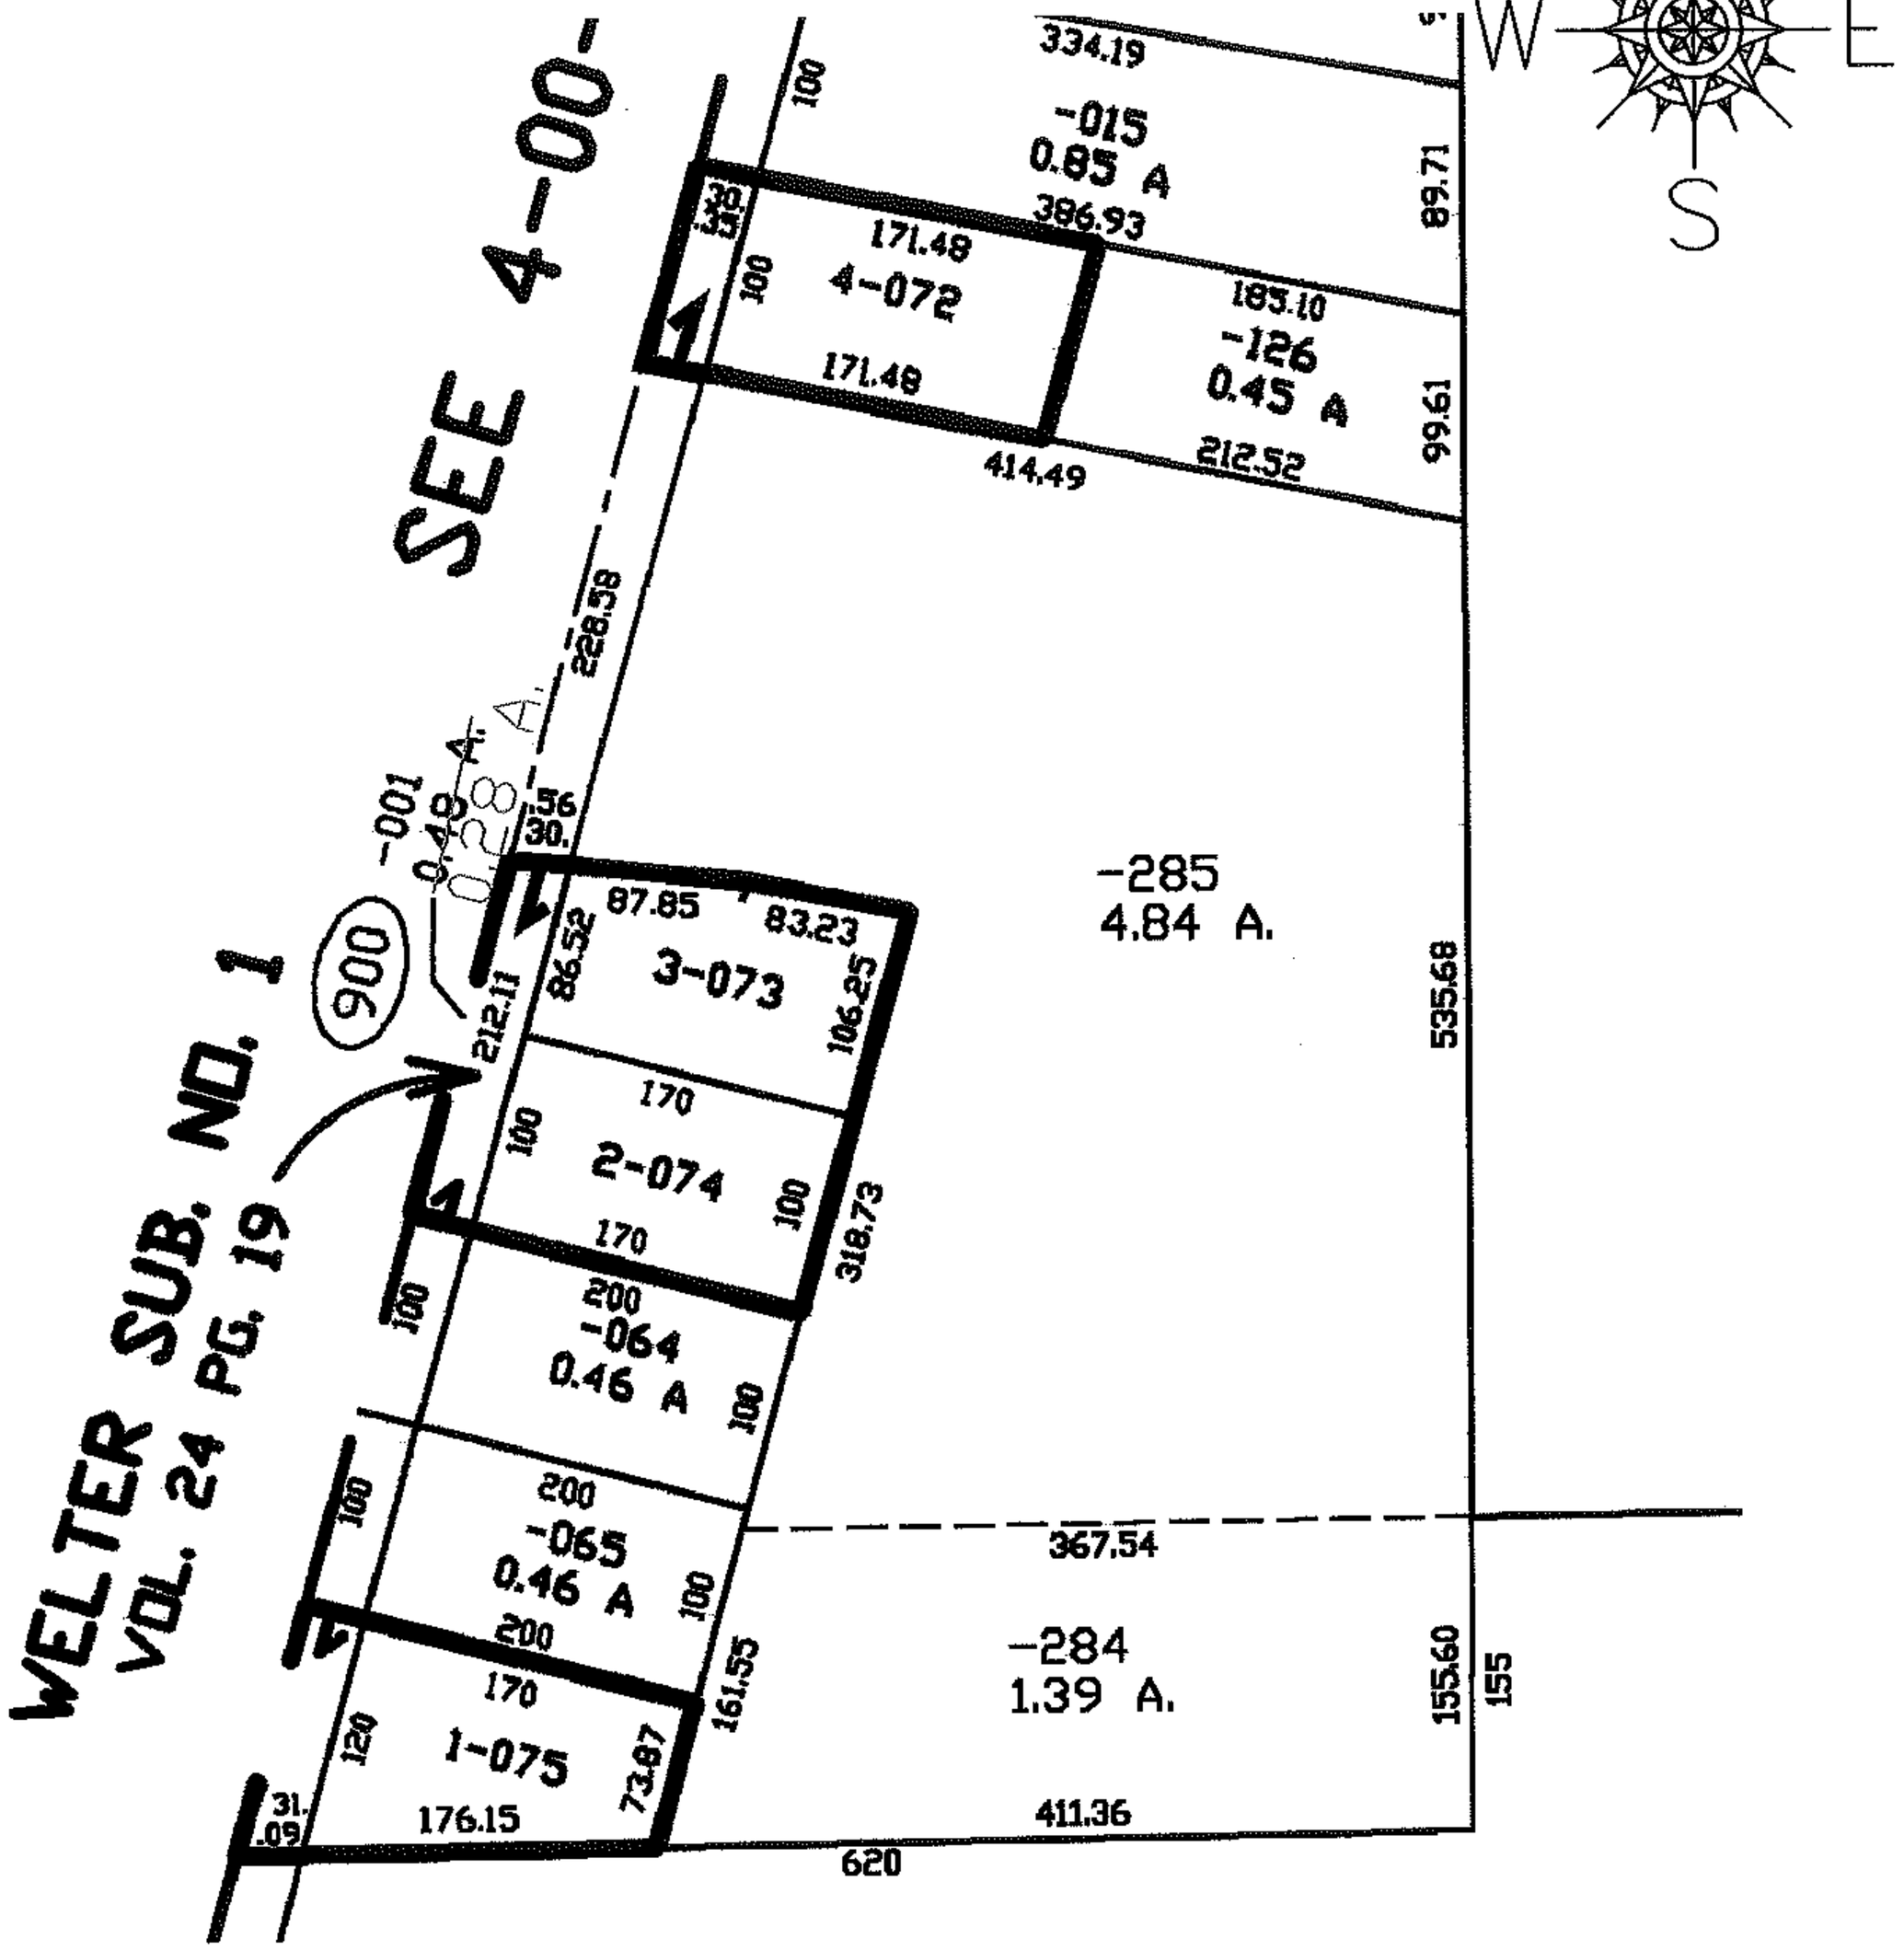

SPLITS/DEEDS PROCESSED

LORAIN COUNTY TAX MAP DEPARTMENT
226 MIDDLE AVE. ELYRIA, OHIO

SURVEYED BY: RAY HOLLIS
CLOSURE: 1:10,000
MAP PAGE(S): 04-00-012-C
APPROVED BY: DRH DATE: 2/5/2008
SCALE: NOT TO SCALE PRIOR INSTRUMENT: PV 24/19