RASTER

PARENT PARCEL: 03-00-057-500-002
CHILD PARCEL: ADD TO DUP & A. CORR
STARTING POINT: CENTERLINE OF ROOT RD & COLORADO AVE

07-01575-C

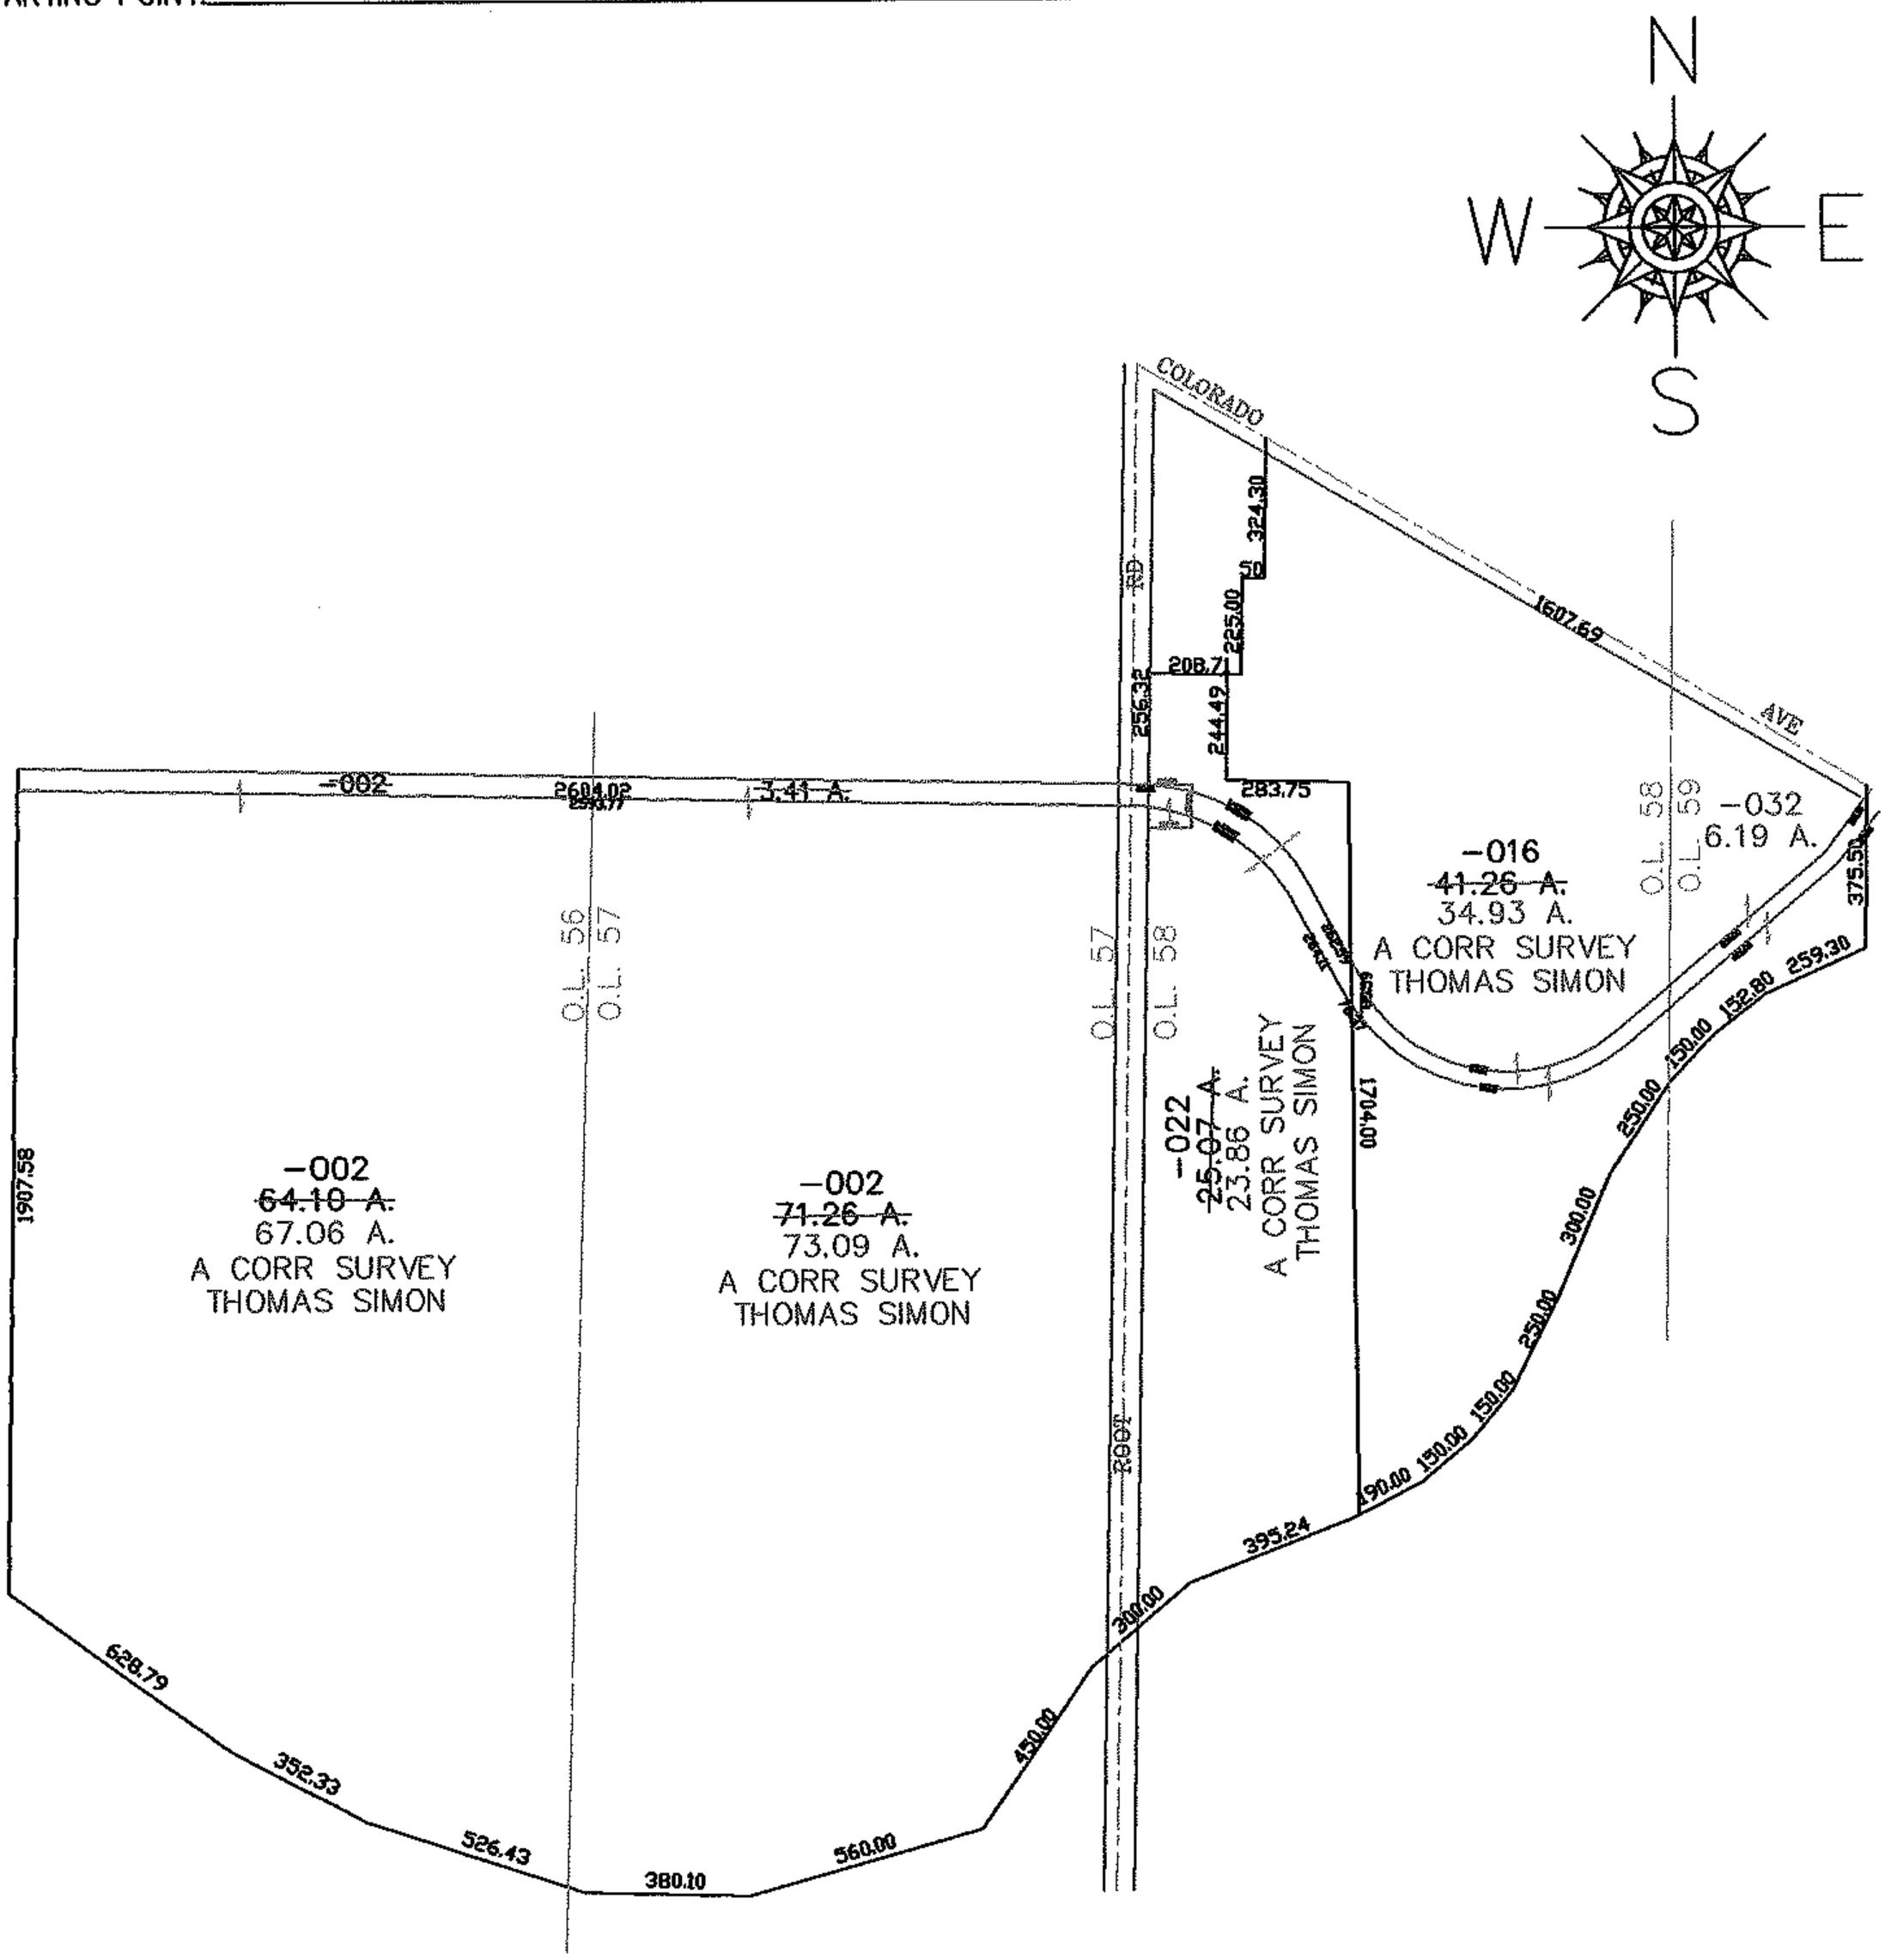

SPLITS/DEEDS PROCESSED

LORAIN COUNTY TAX MAP DEPARTMENT
226 MIDDLE AVE. ELYRIA, OHIO

SURVEYED BY: THOMAS SIMON
CLOSURE: 0.01 : 10,000
MAP PAGE(S): 03-00-058-B
APPROVED BY: JAH DATE: 11-30-07
SCALE: 1"= 600 PRIOR INSTRUMENT: 2004023525

200400 23525