PARENT PARCEL: 09-00-066-000-028, -054

CHILD PARCEL: --SAME--

STARTING POINT: INT CL OF MAPLE ST AND S.R. 58

07-01585-X

ANNEXATION FROM NEW RUSSIA TO CITY OF OBERLIN RES. NO. 07-795

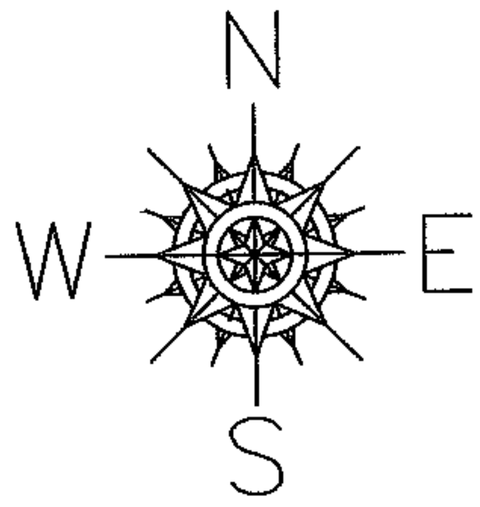

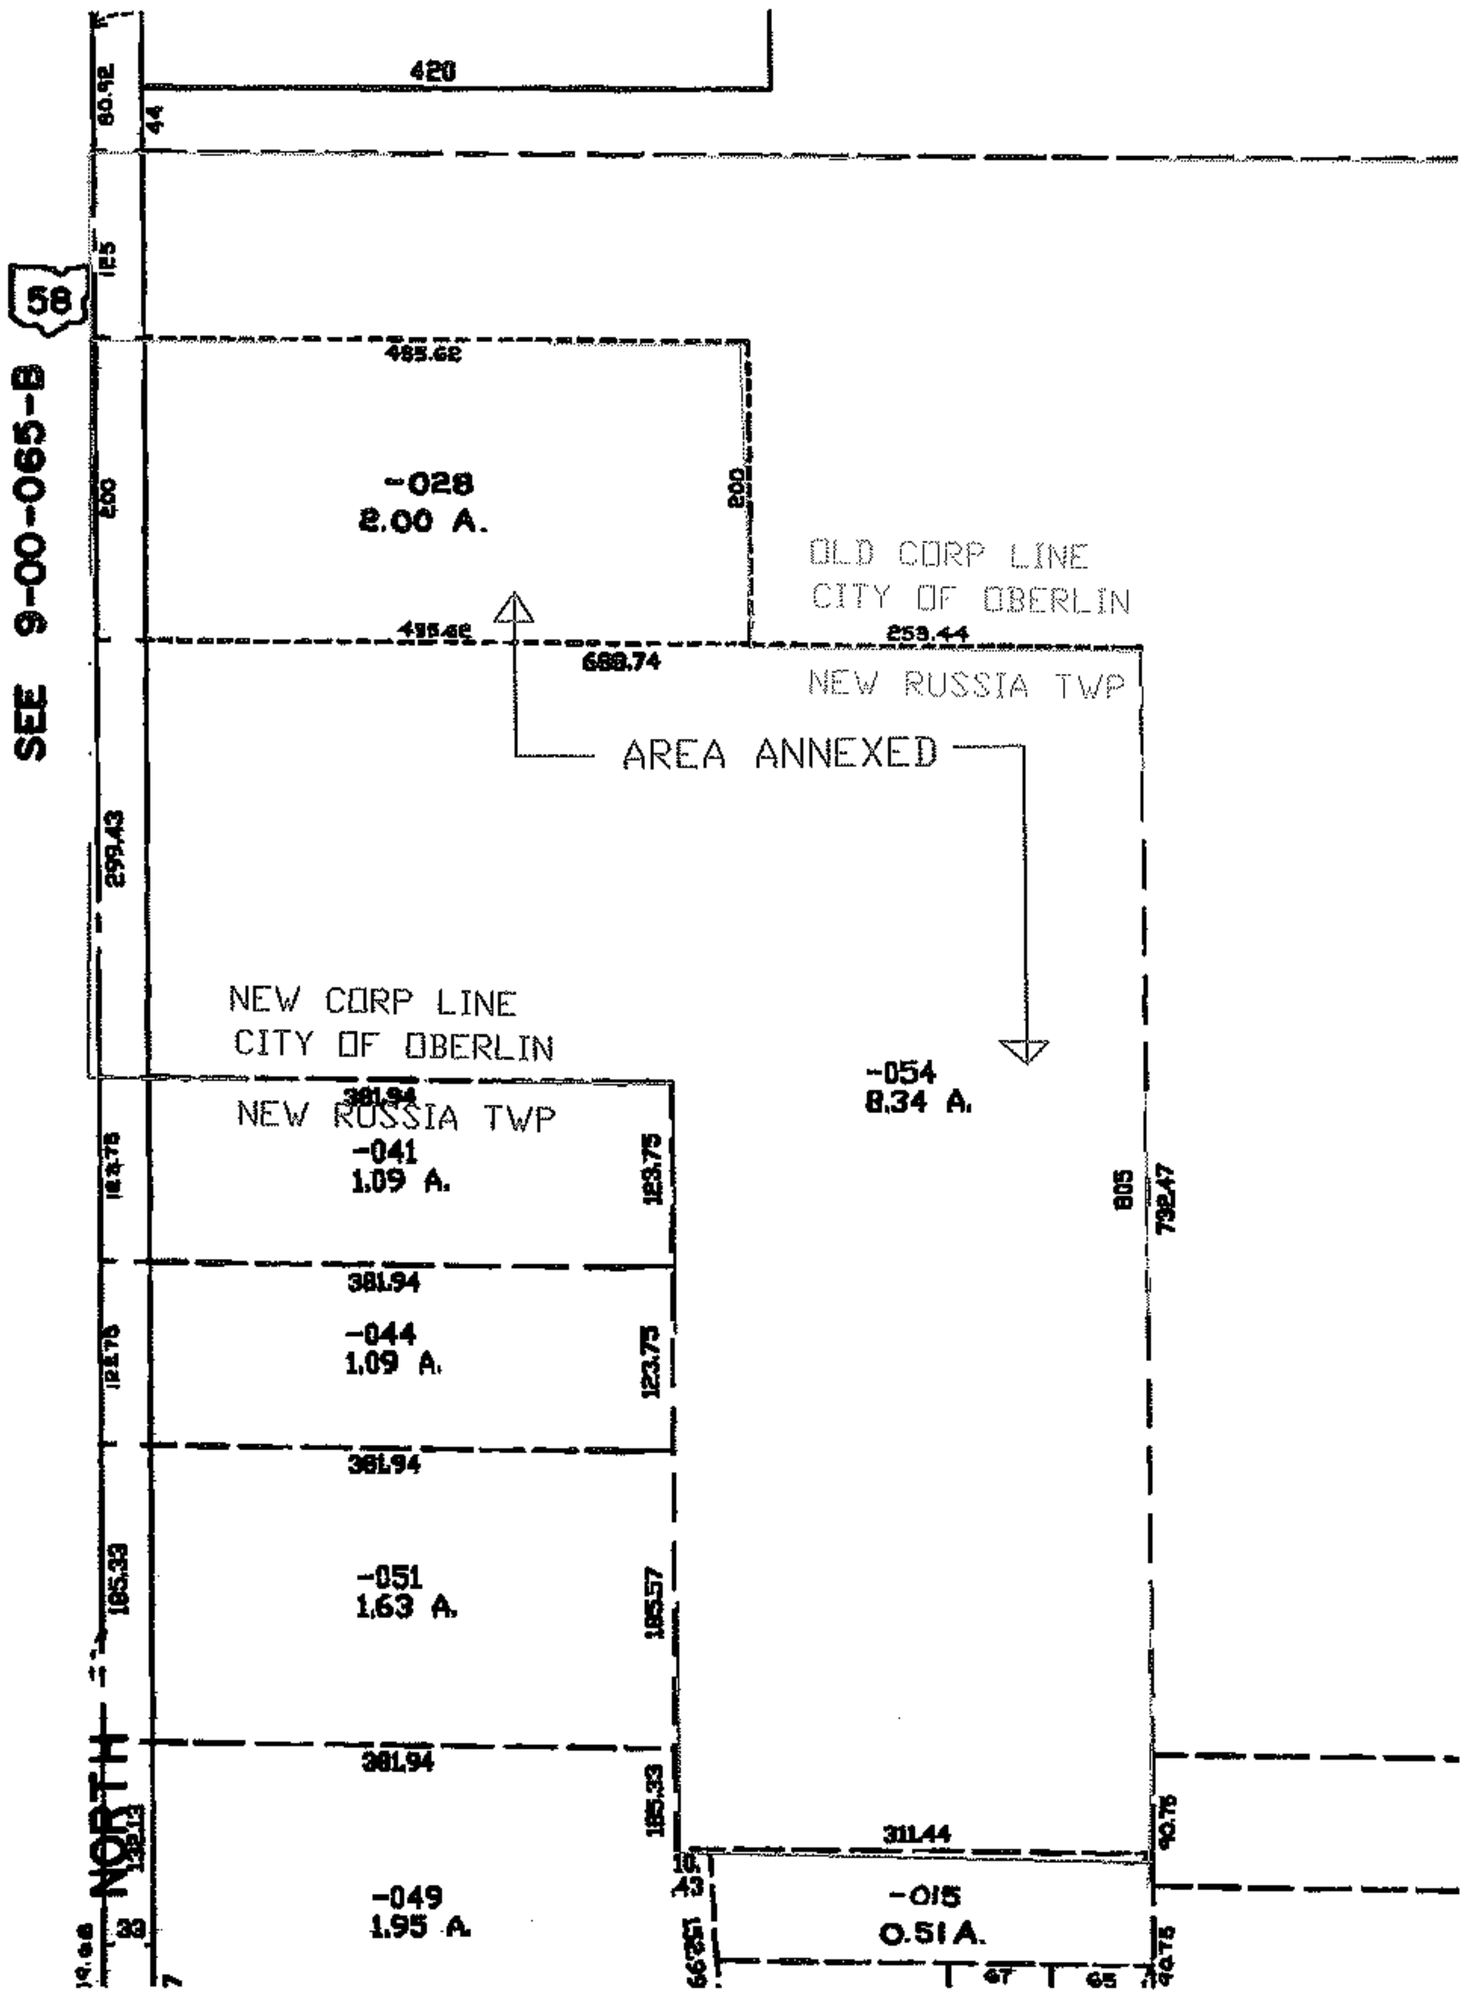

SPLITS/DEEDS PROCESSED

LORAIN COUNTY TAX MAP DEPARTMENT
226 MIDDLE AVE. ELYRIA, OHIO

SURVEYED BY: THOMAS SIMON

CLOSURE: 1:10,000

MAP PAGE(S): 09-00-066-A

APPROVED BY: DRH DATE: 3/12/2008

SCALE: NOT TO SCALE PRIOR INSTRUMENT: