RASTER

PARENT PARCEL: ADD TO DUP

CHILD PARCEL: 03-00-032-101-055

STARTING POINT:

08-01595-X

ADD TO DUP

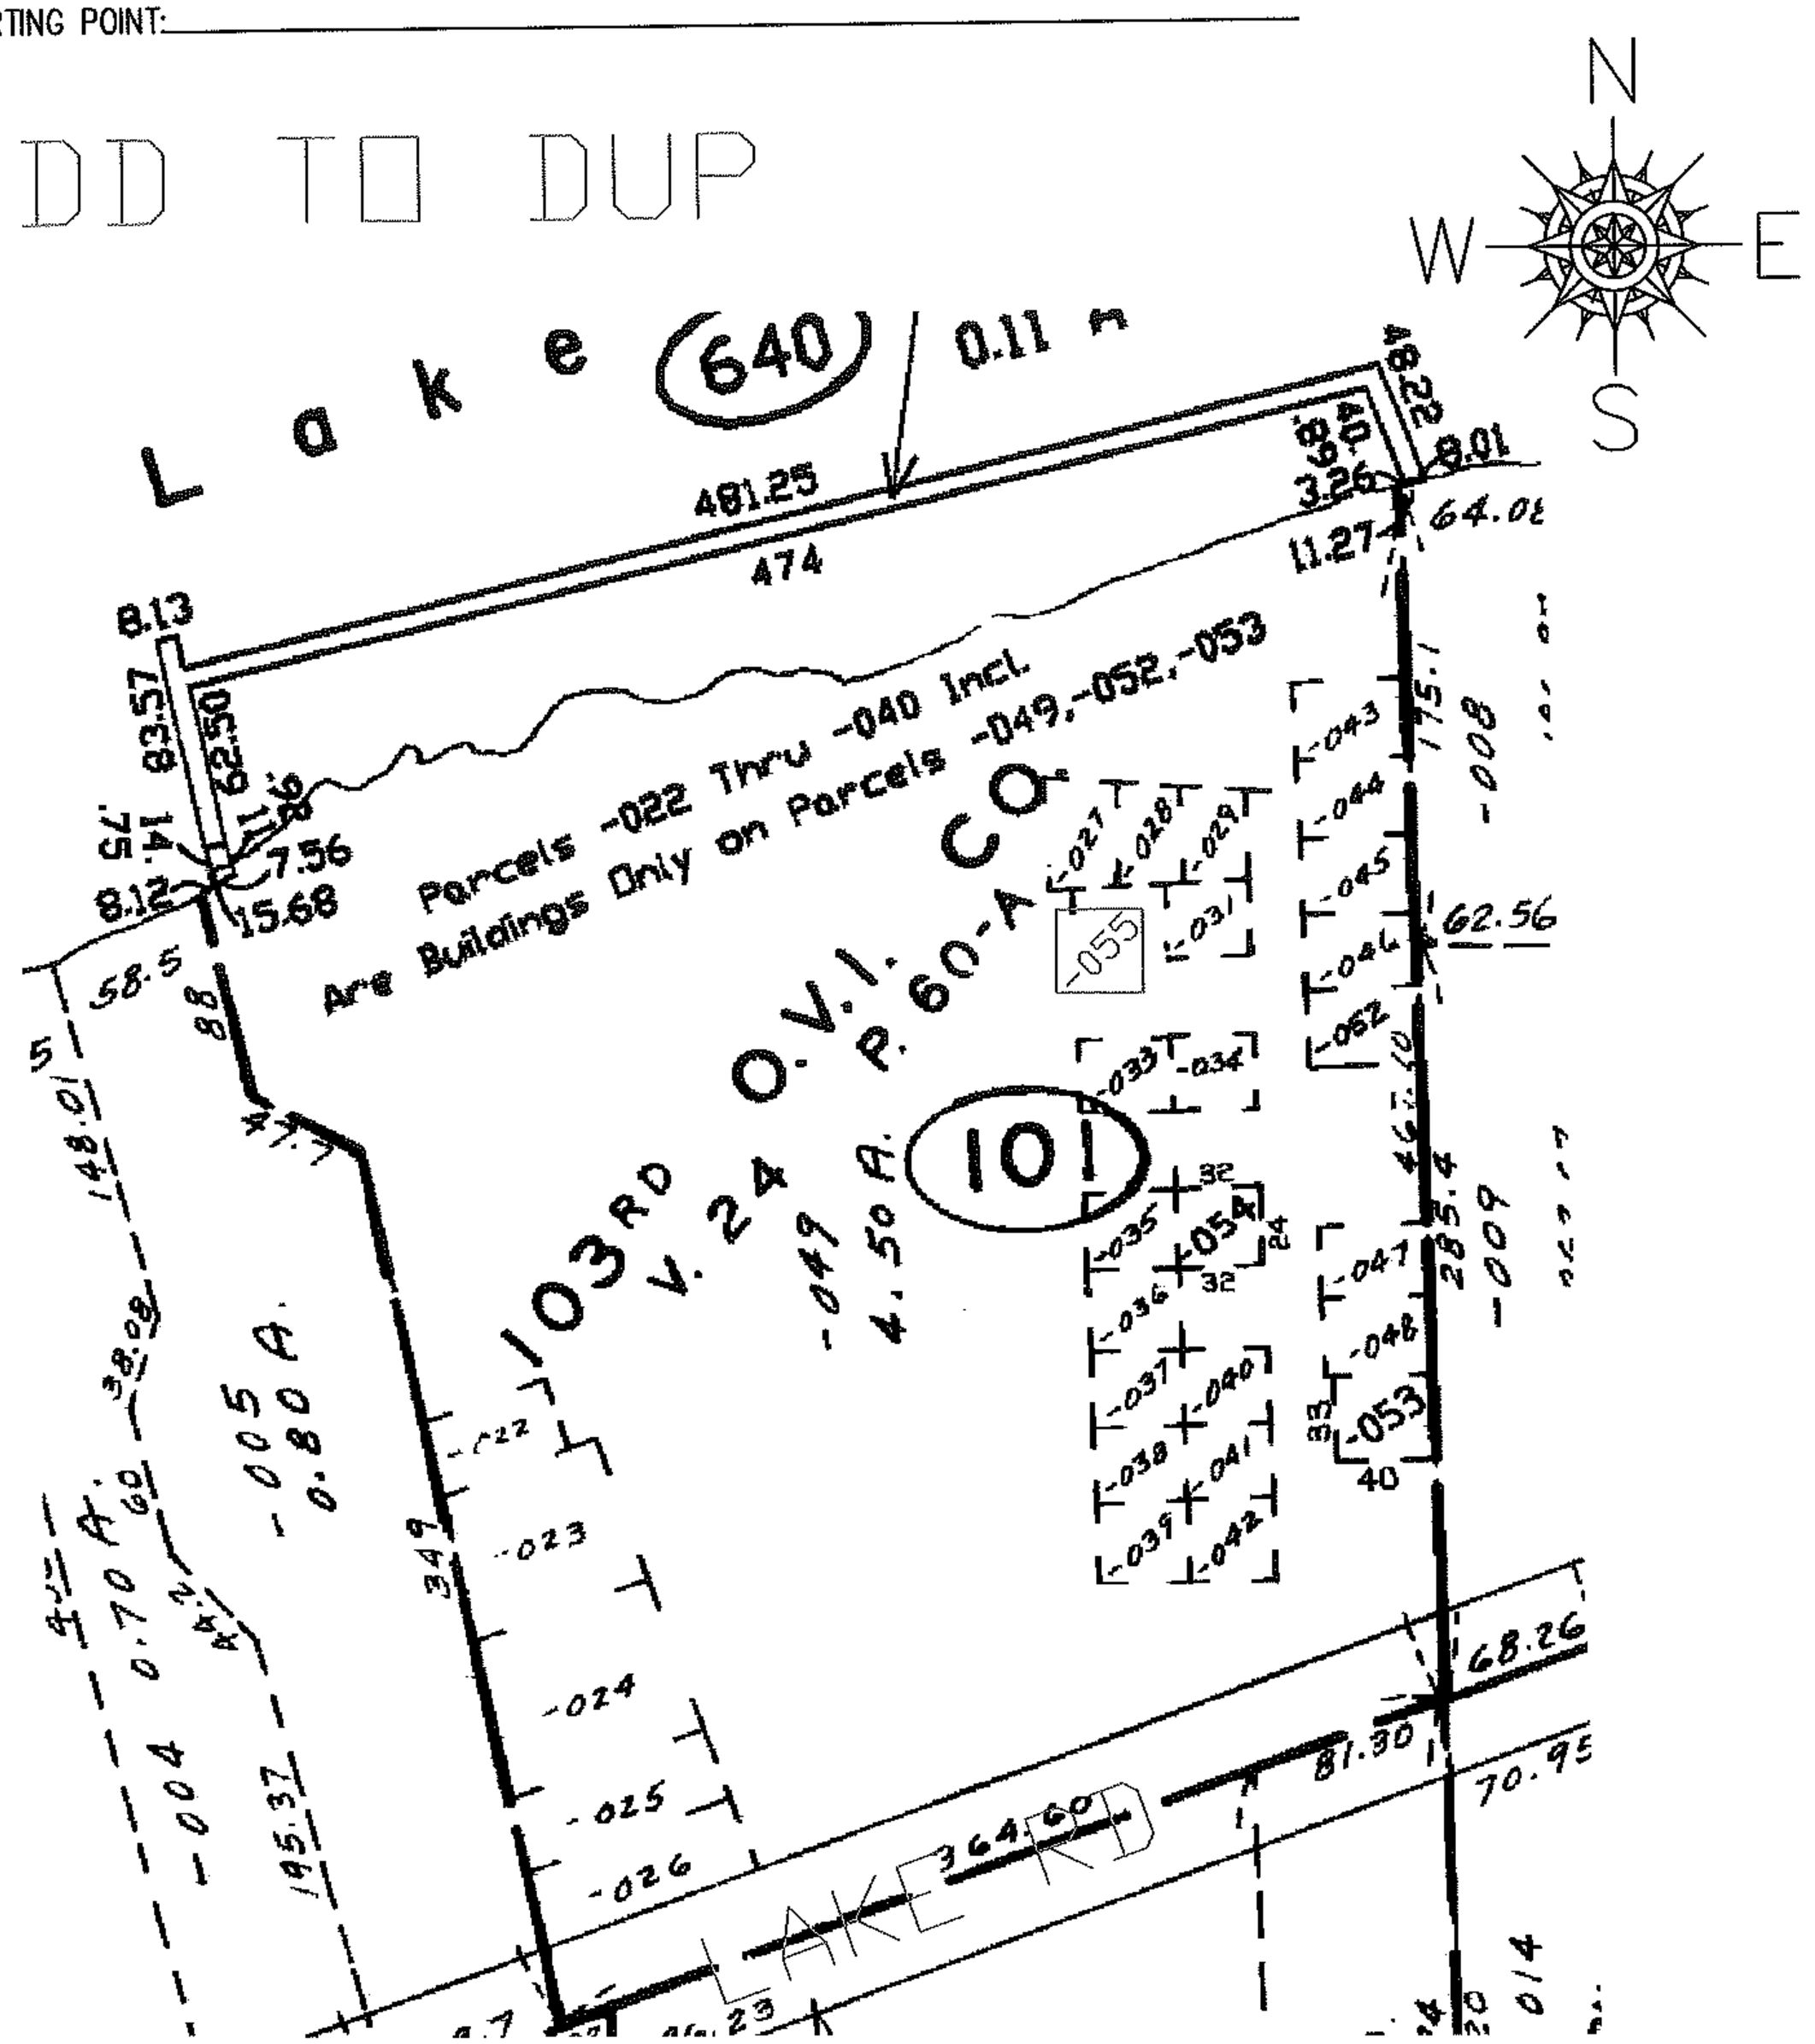

SPLITS/DEEDS PROCESSED

LORAIN COUNTY TAX MAP DEPARTMENT
226 MIDDLE AVE. ELYRIA, OHIO

SURVEYED BY: N/A

CLOSURE: N/A

MAP PAGE(S): 03-00-032-A

APPROVED BY: DRH DATE: 3/10/2008

SCALE: 1"= 100 PRIOR INSTRUMENT: