RASTER

PARENT PARCEL: 03-00-032-101-055

CHILD PARCEL: DROP FROM DUP

STARTING POINT:

08-01595-X

MAP CORR & DROP FROM DUP

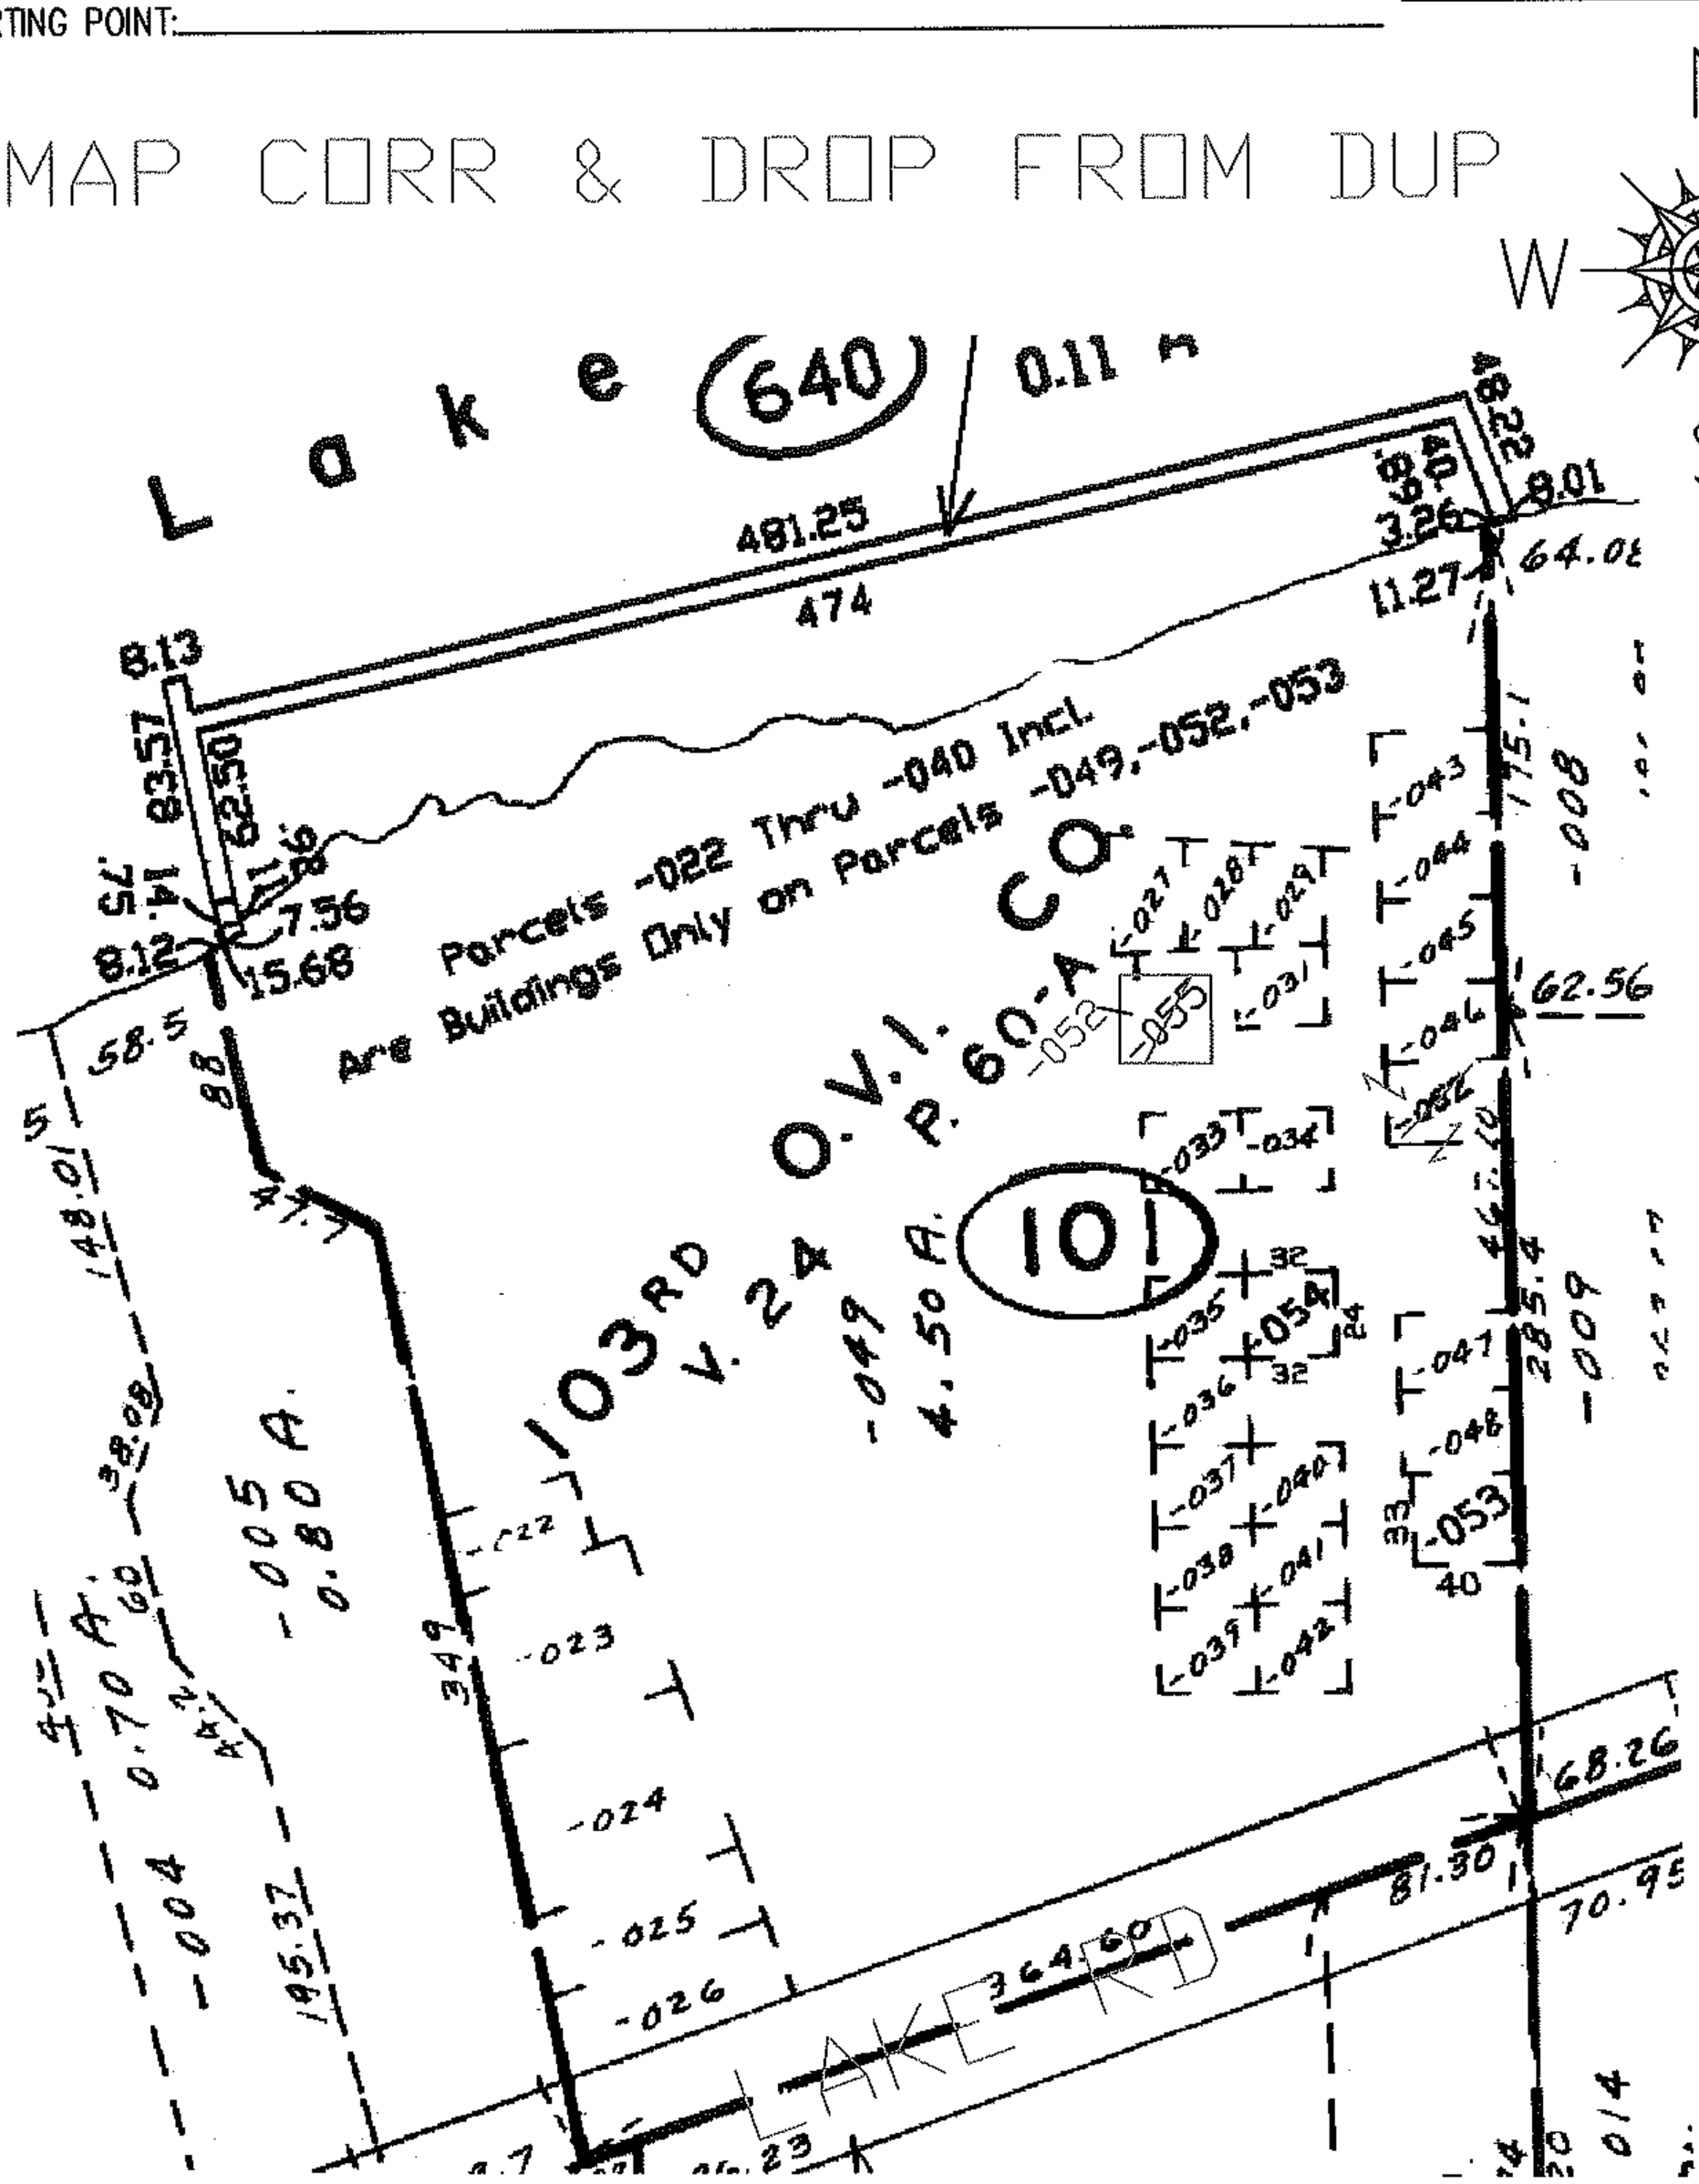

SPLITS/DEEDS PROCESSED

LORAIN COUNTY TAX MAP DEPARTMENT
226 MIDDLE AVE. ELYRIA, OHIO

SURVEYED BY: N/A

CLOSURE: N/A

MAP PAGE(S): 03-00-032-A

APPROVED BY: DRH DATE: 4/17/2008

SCALE: NOT TO SCALE PRIOR INSTRUMENT: