RASTER

PARENT PARCEL: 02-00-051-105-025

CHILD PARCEL: --SAME--

STARTING POINT: ERIE AND IOWA

08-01616-C

MAP CORRECTION
PER TED/TAX MAP

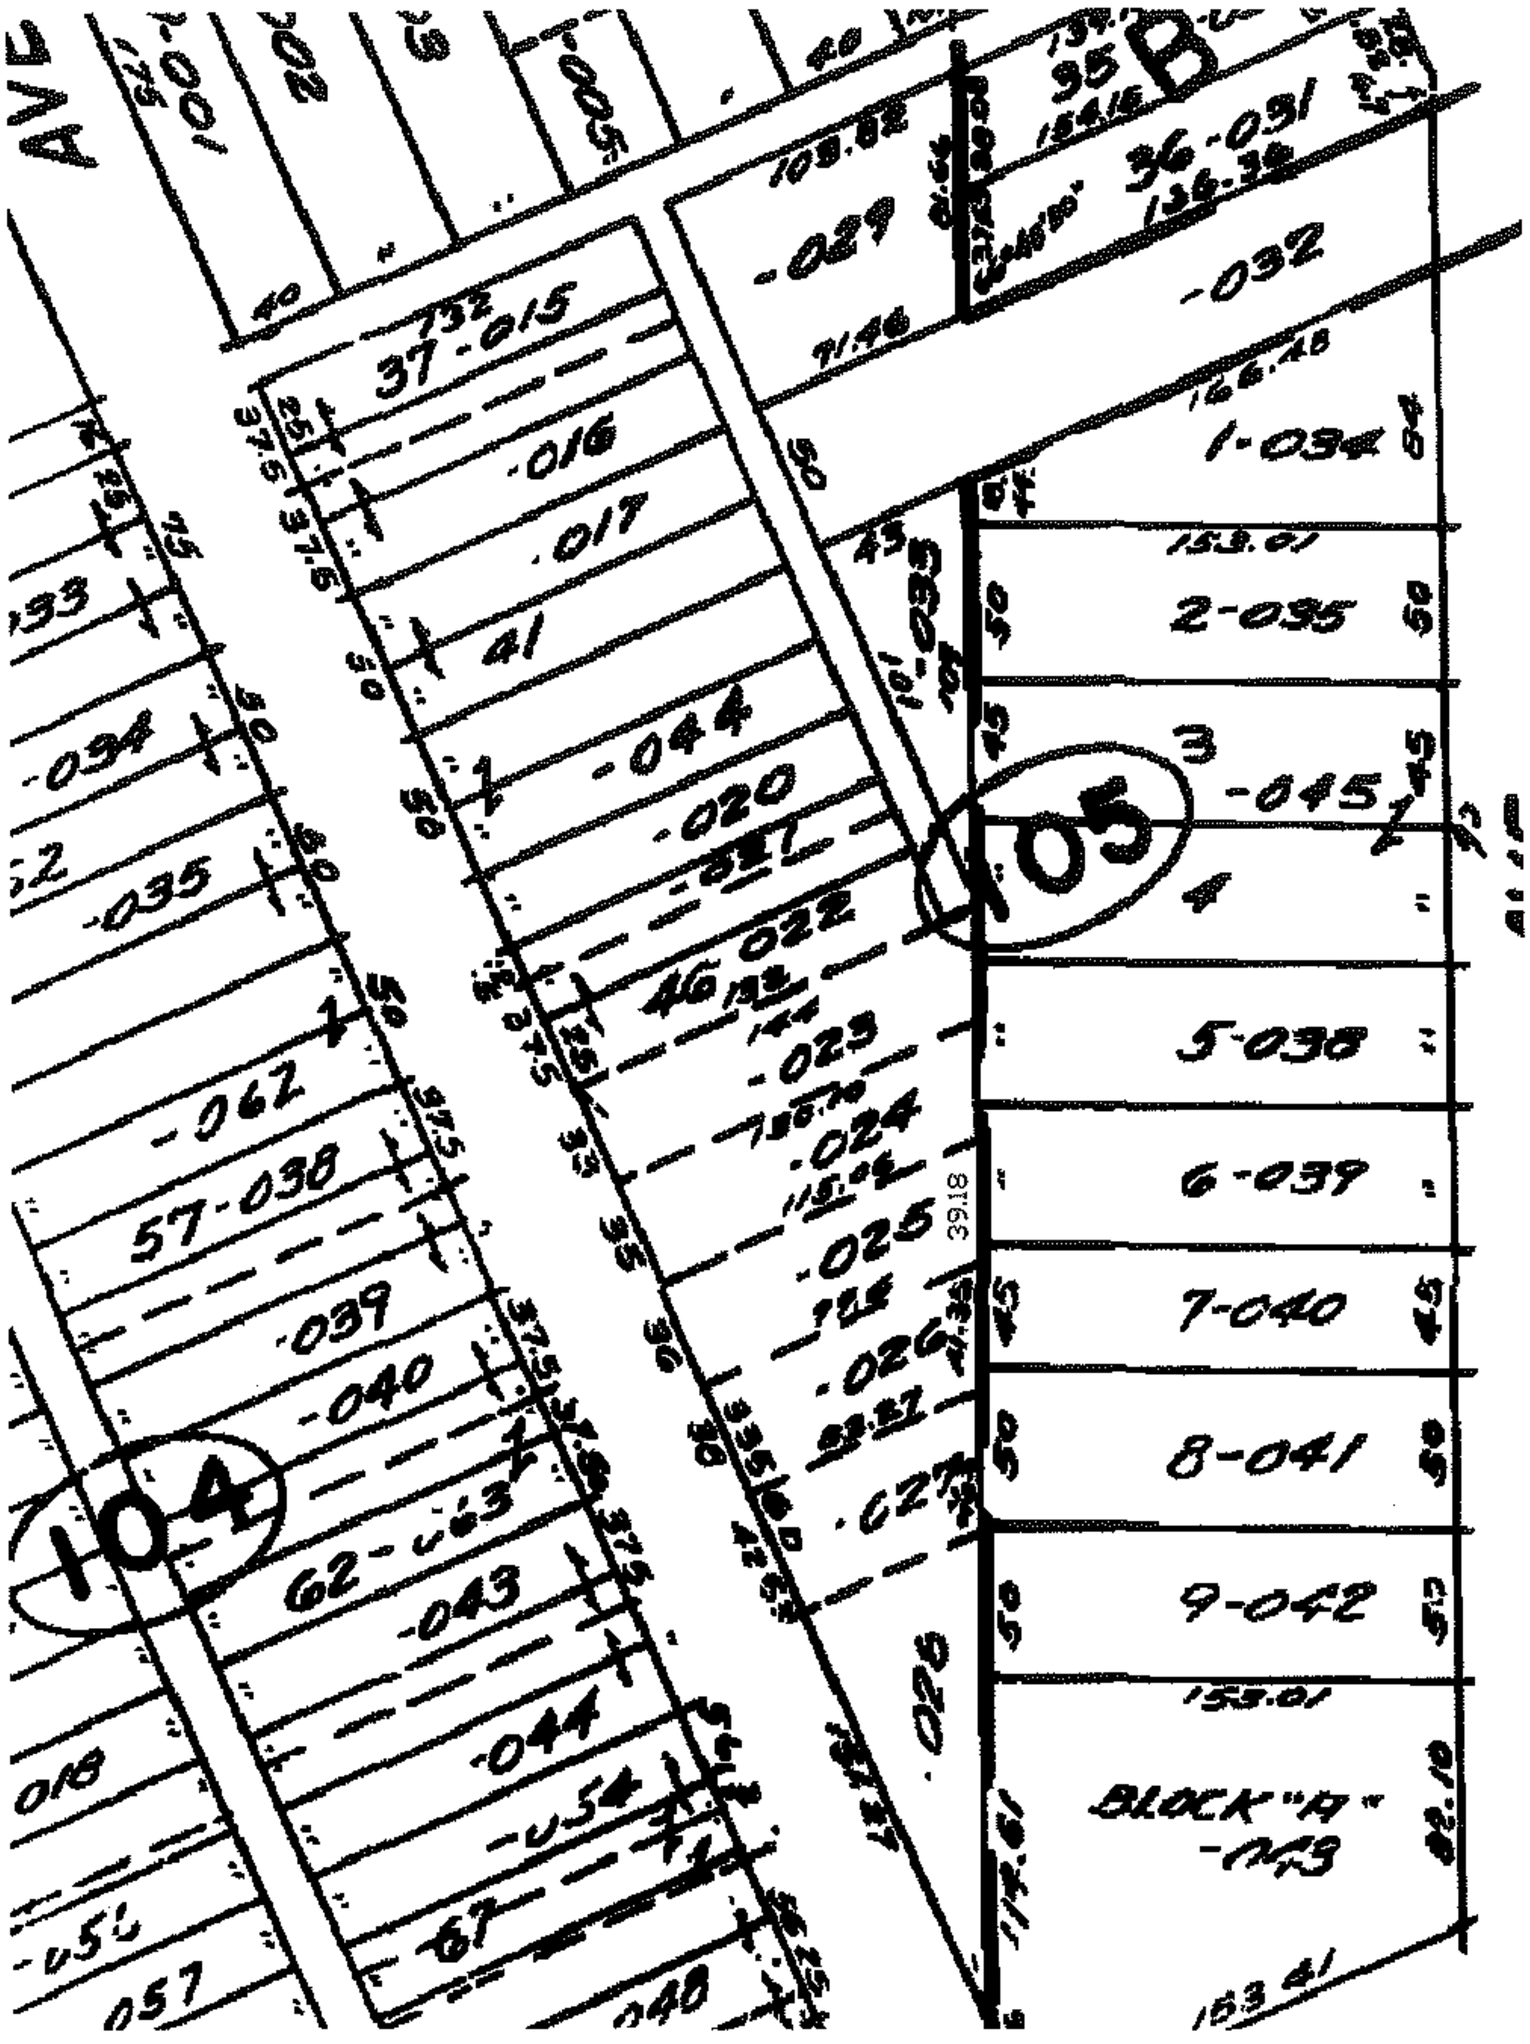

SPLITS/DEEDS PROCESSED

LORAIN COUNTY TAX MAP DEPARTMENT
226 MIDDLE AVE. ELYRIA, OHIO

SURVEYED BY: N/A

CLOSURE: N/A

MAP PAGE(S): 02-00-051-A

APPROVED BY: DRH DATE: 5/5/2008

SCALE: NOT TO SCALE PRIOR INSTRUMENT: DV 1072/679