RASTER

PARENT PARCEL: 16-00-060-000-054

CHILD PARCEL: --SAME--

STARTING POINT: INT CL WAKEMAN LAGRANGE RD AND CHAMBERLAIN RD

08-01618-C

AC. CORR.
PER SURVEY JIM ROOT

N
W E
S

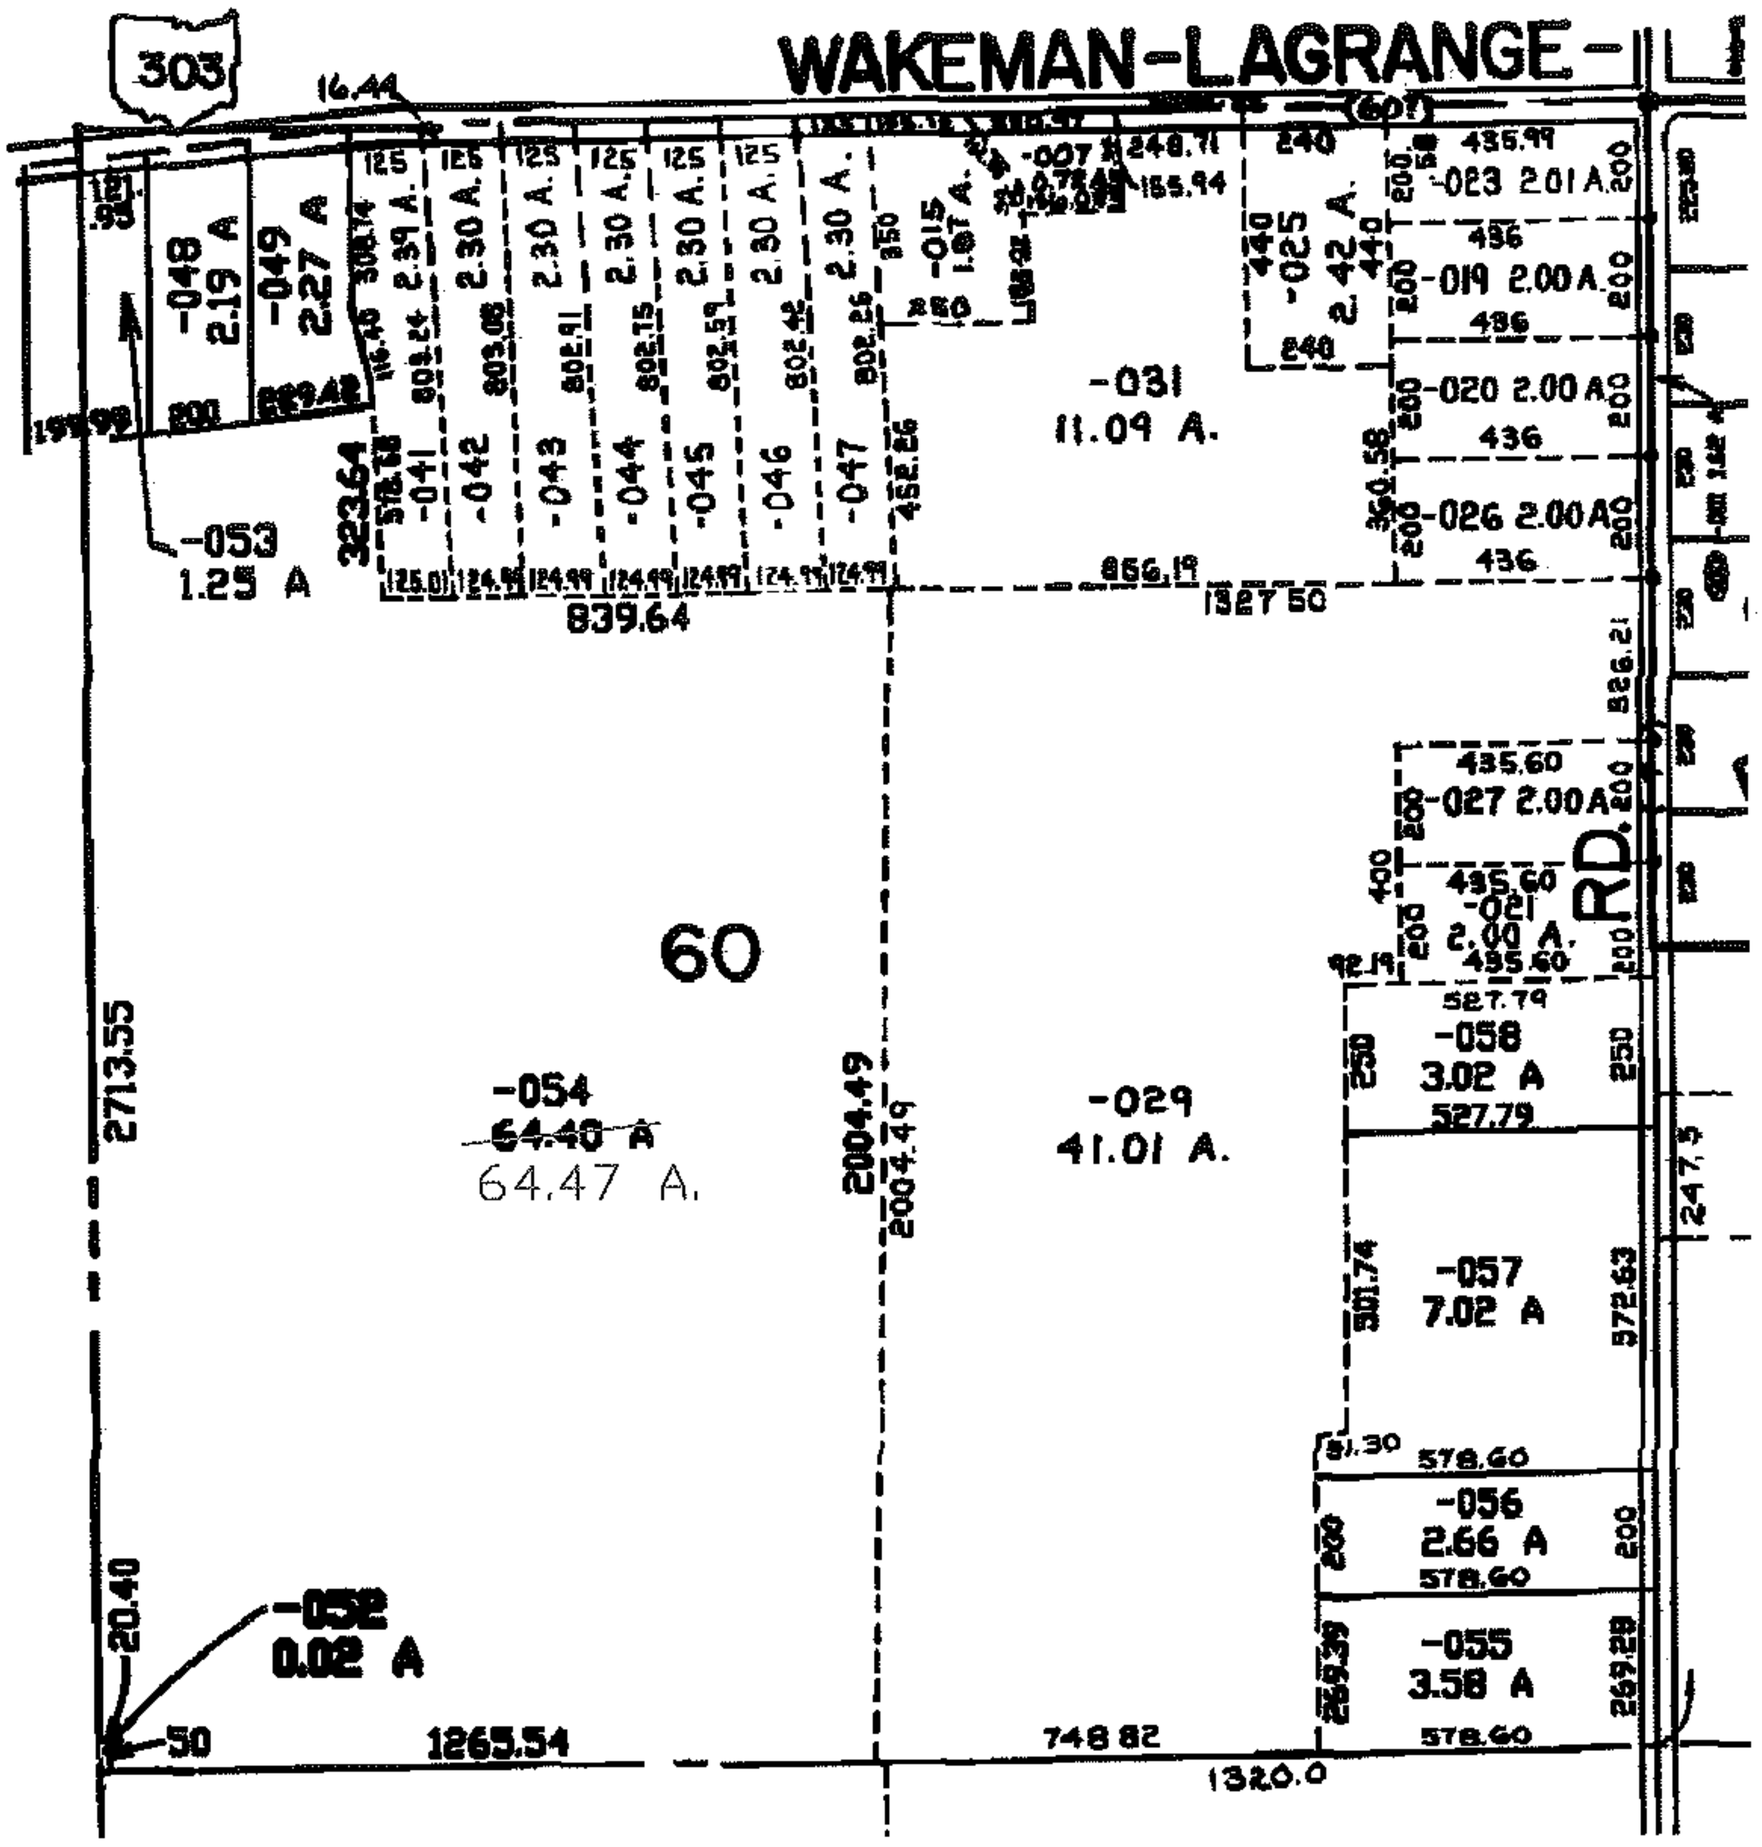


SPLITS/DEEDS PROCESSED

LORAIN COUNTY TAX MAP DEPARTMENT
226 MIDDLE AVE. ELYRIA, OHIO

SURVEYED BY: JAMES B. ROOT
CLOSURE: 1:10,000
MAP PAGE(S): 16-E
APPROVED BY: DRH DATE: 2/25/2008
SCALE: NOT TO SCALE PRIOR INSTRUMENT: 19990626518