RASTER

PARENT PARCEL: 04-00-007-120-015

CHILD PARCEL: --SAME--

STARTING POINT: S/L 16 IN AVON ACRES SUB NO 2

08-01652-C

FRONTAGE CORR PER MAP & PLAT

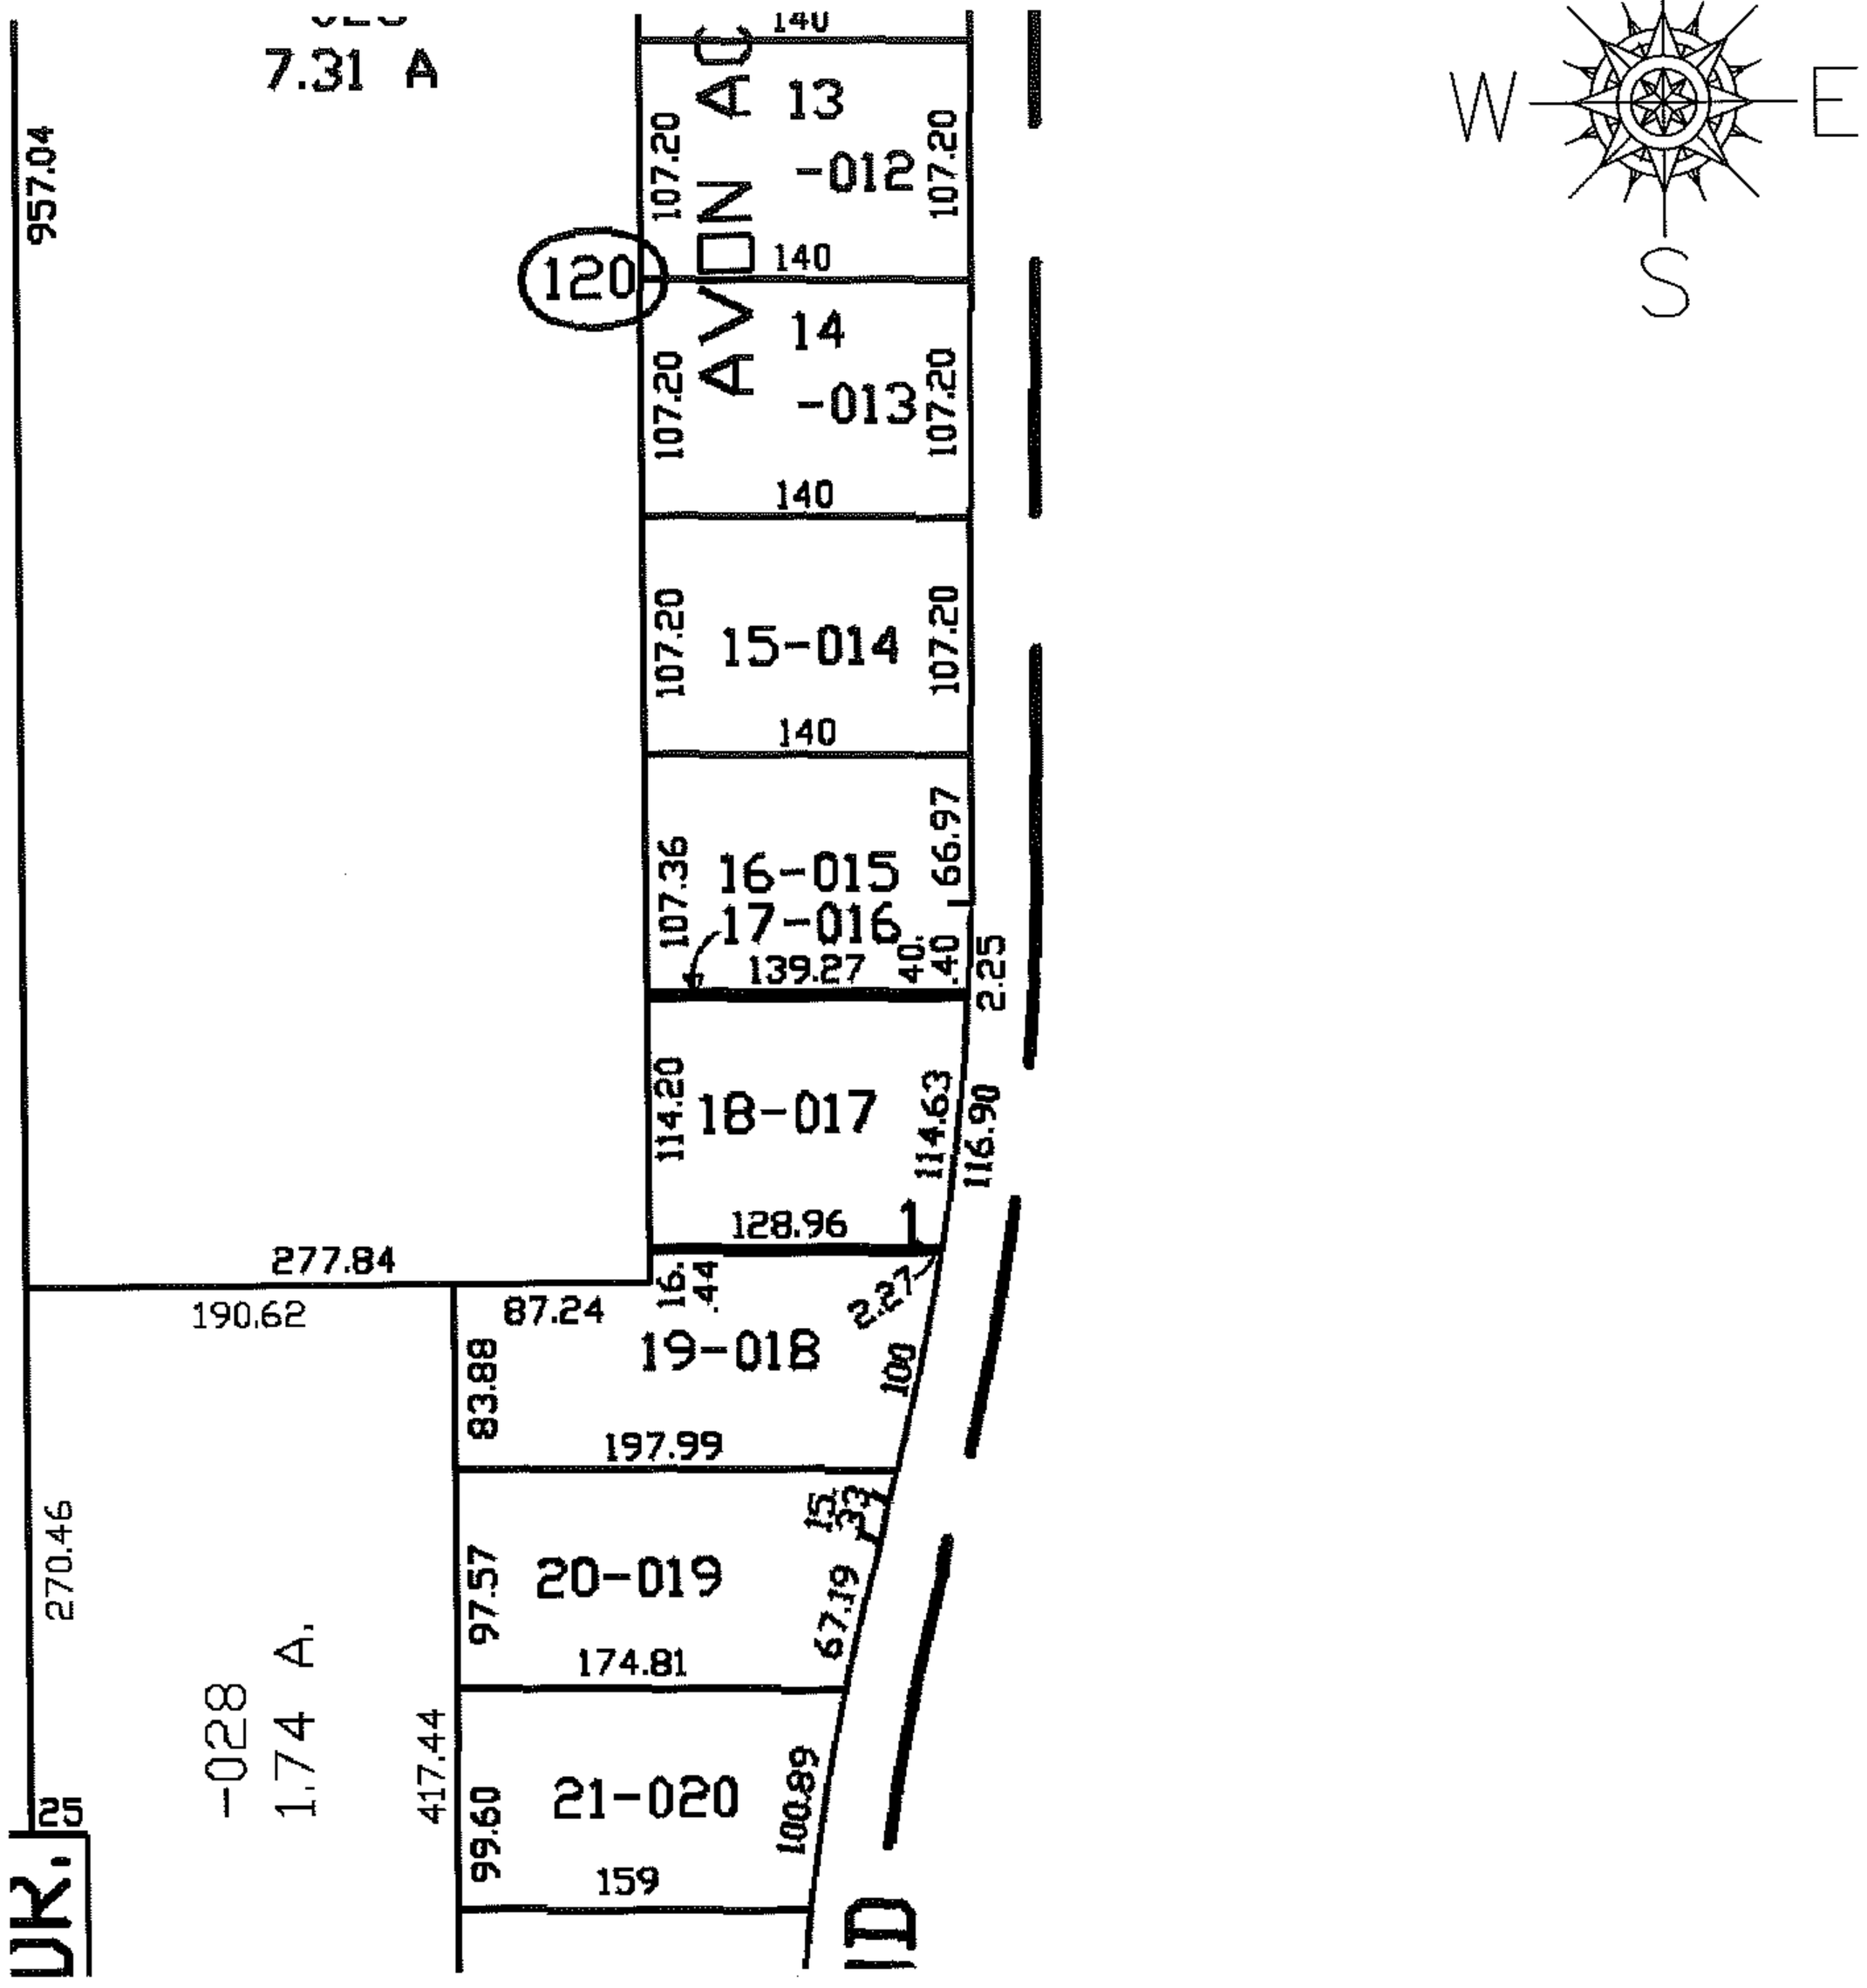

SPLITS/DEEDS PROCESSED

LORAIN COUNTY TAX MAP DEPARTMENT
226 MIDDLE AVE. ELYRIA, OHIO

SURVEYED BY: N/A

CLOSURE: N/A

MAP PAGE(S): 04-00-007-C

APPROVED BY: DRH DATE: 7/25/2008

SCALE: NOT TO SCALE PRIOR INSTRUMENT: 20010767179