RASTER

PARENT PARCEL: 03-00-098-127-024
CHILD PARCEL: --SAME--
STARTING POINT: INT ELYRIA AVE AND 34TH ST

08-01701-C

FRONTAGE CORR PER DEED

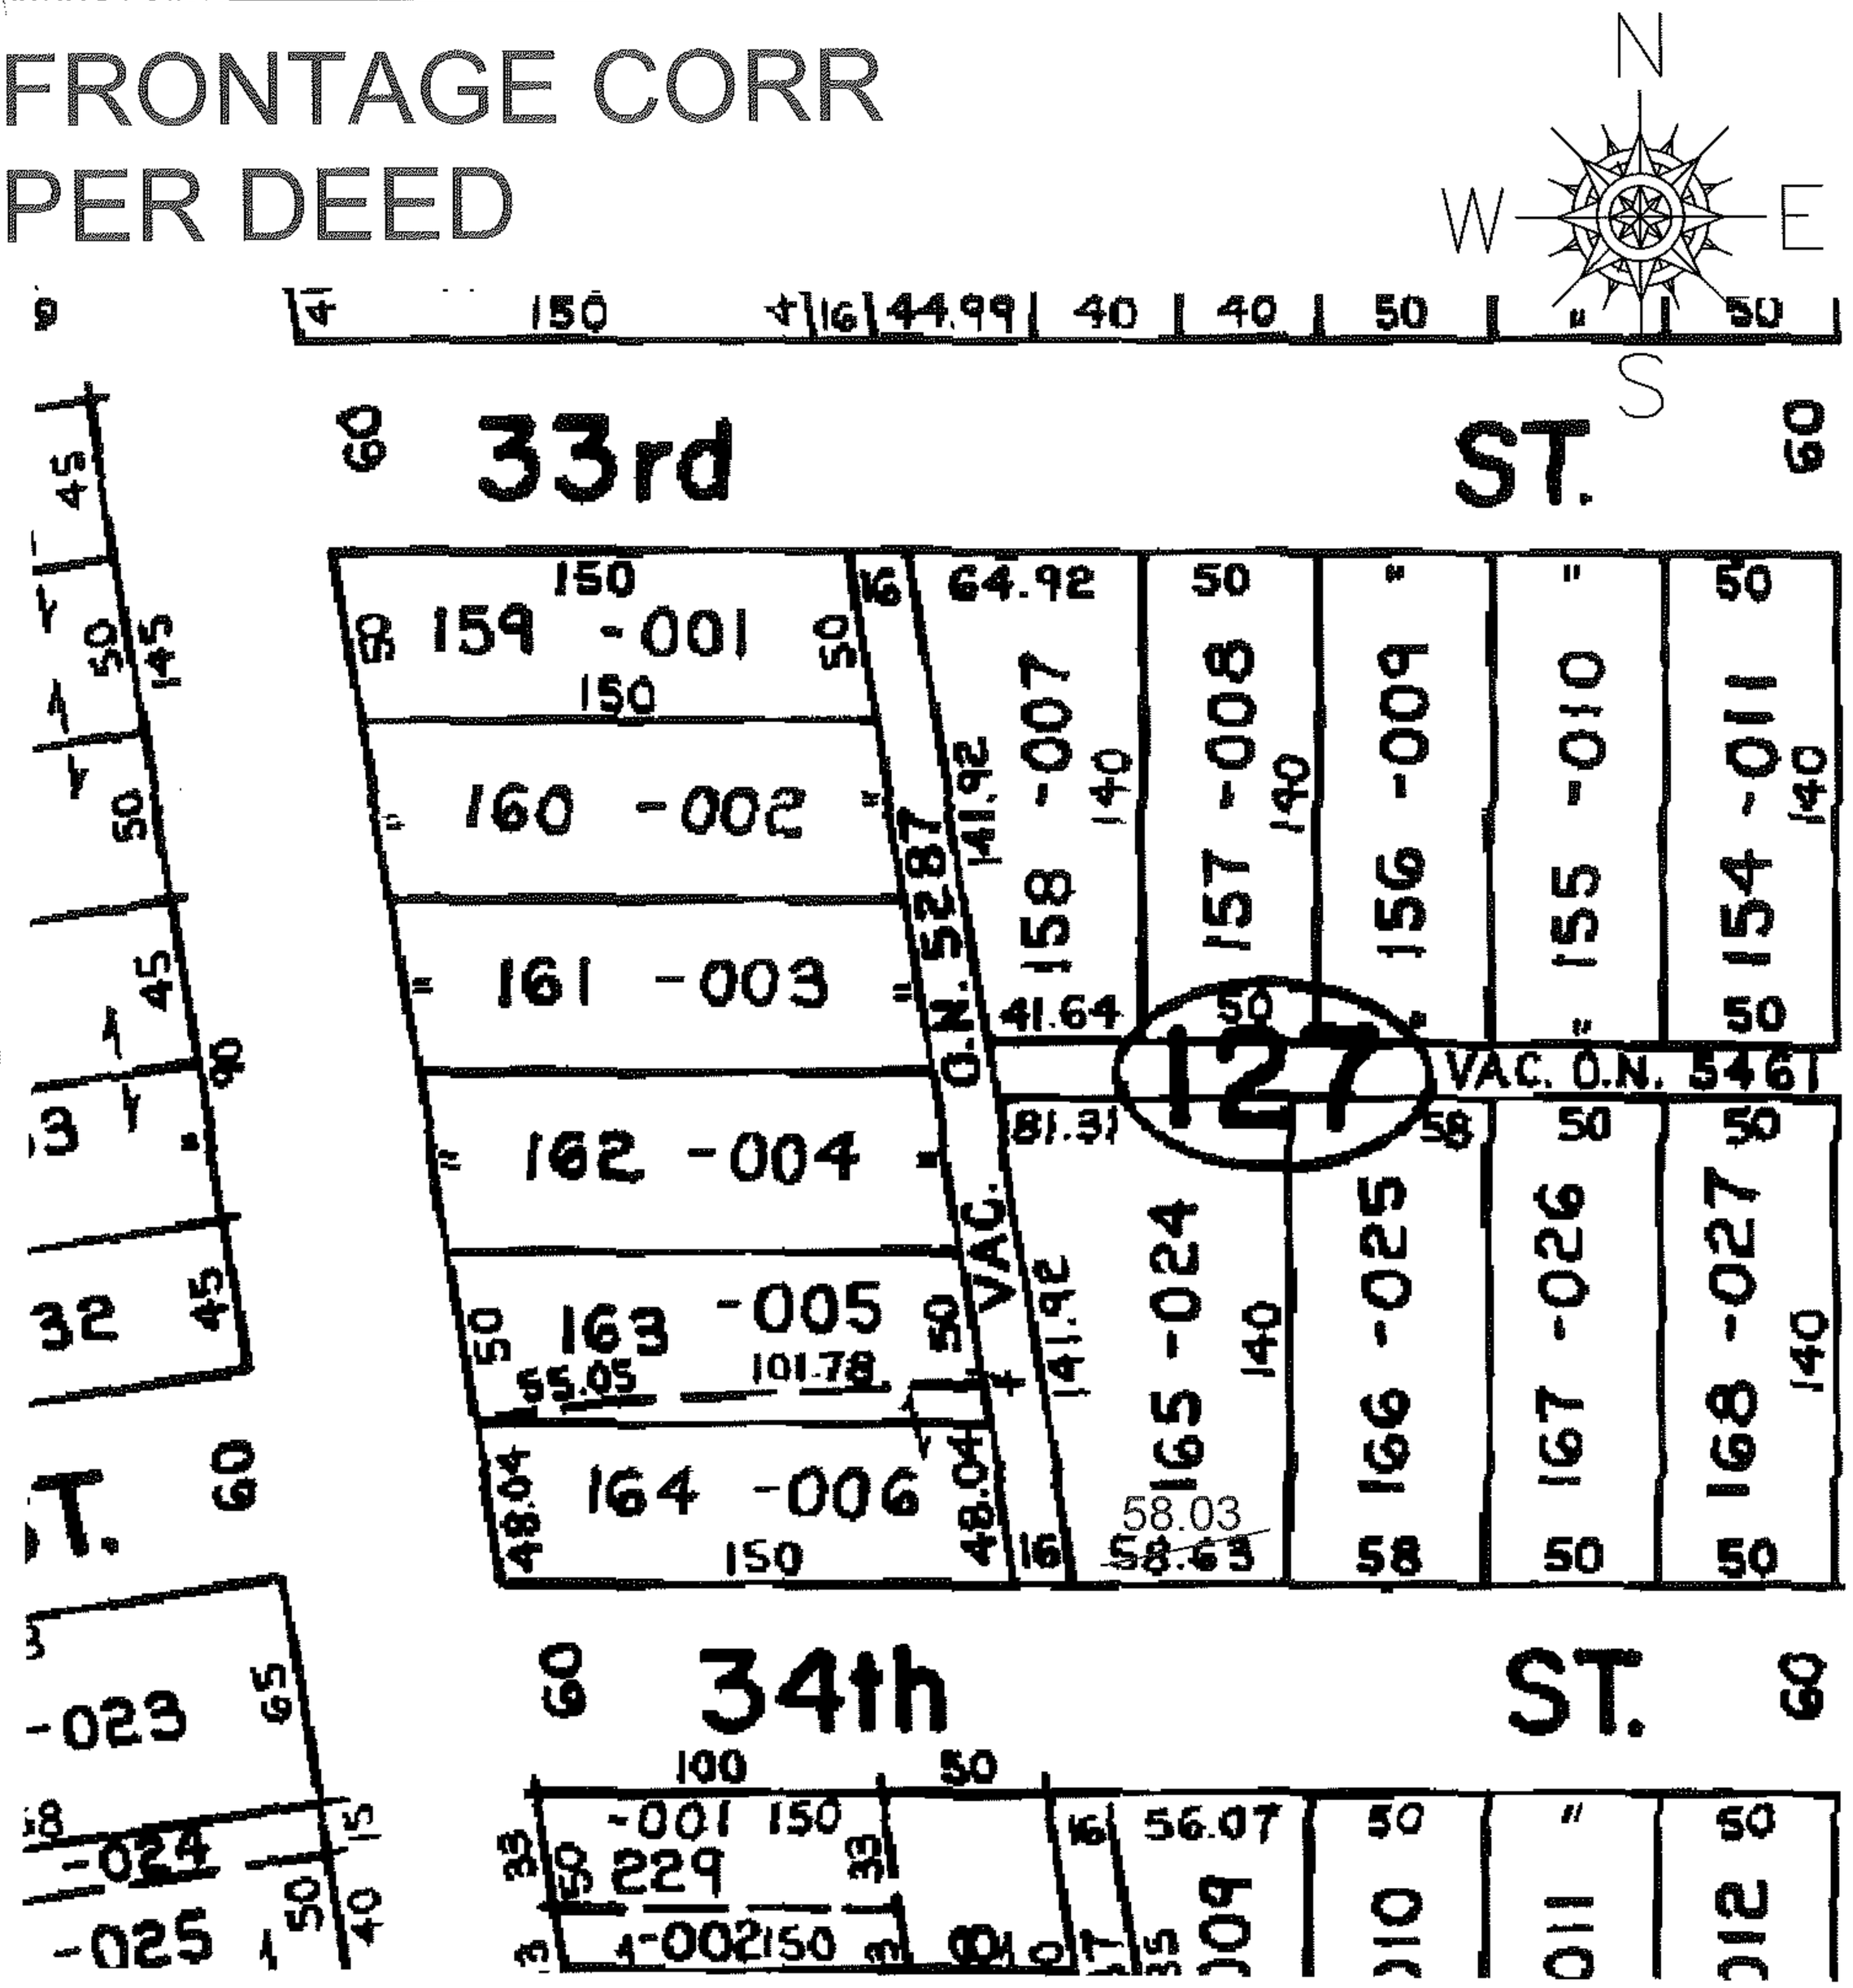

SPLITS/DEEDS PROCESSED

LORAIN COUNTY TAX MAP DEPARTMENT
226 MIDDLE AVE. ELYRIA, OHIO

SURVEYED BY: N/A
CLOSURE: N/A
MAP PAGE(S): 03-00-098-A
APPROVED BY: DRH DATE: 11/3/2008
SCALE: NOT TO SCALE PRIOR INST.: 20080271075