RASTER

PARENT PARCEL: 19-04-011-000-002

CHILD PARCEL: --SAME--

STARTING POINT: INT CL MEDINA - NORWALK AND LATTASBURG - ELYRIA

08-01714-C

MAP CORR PER DEED

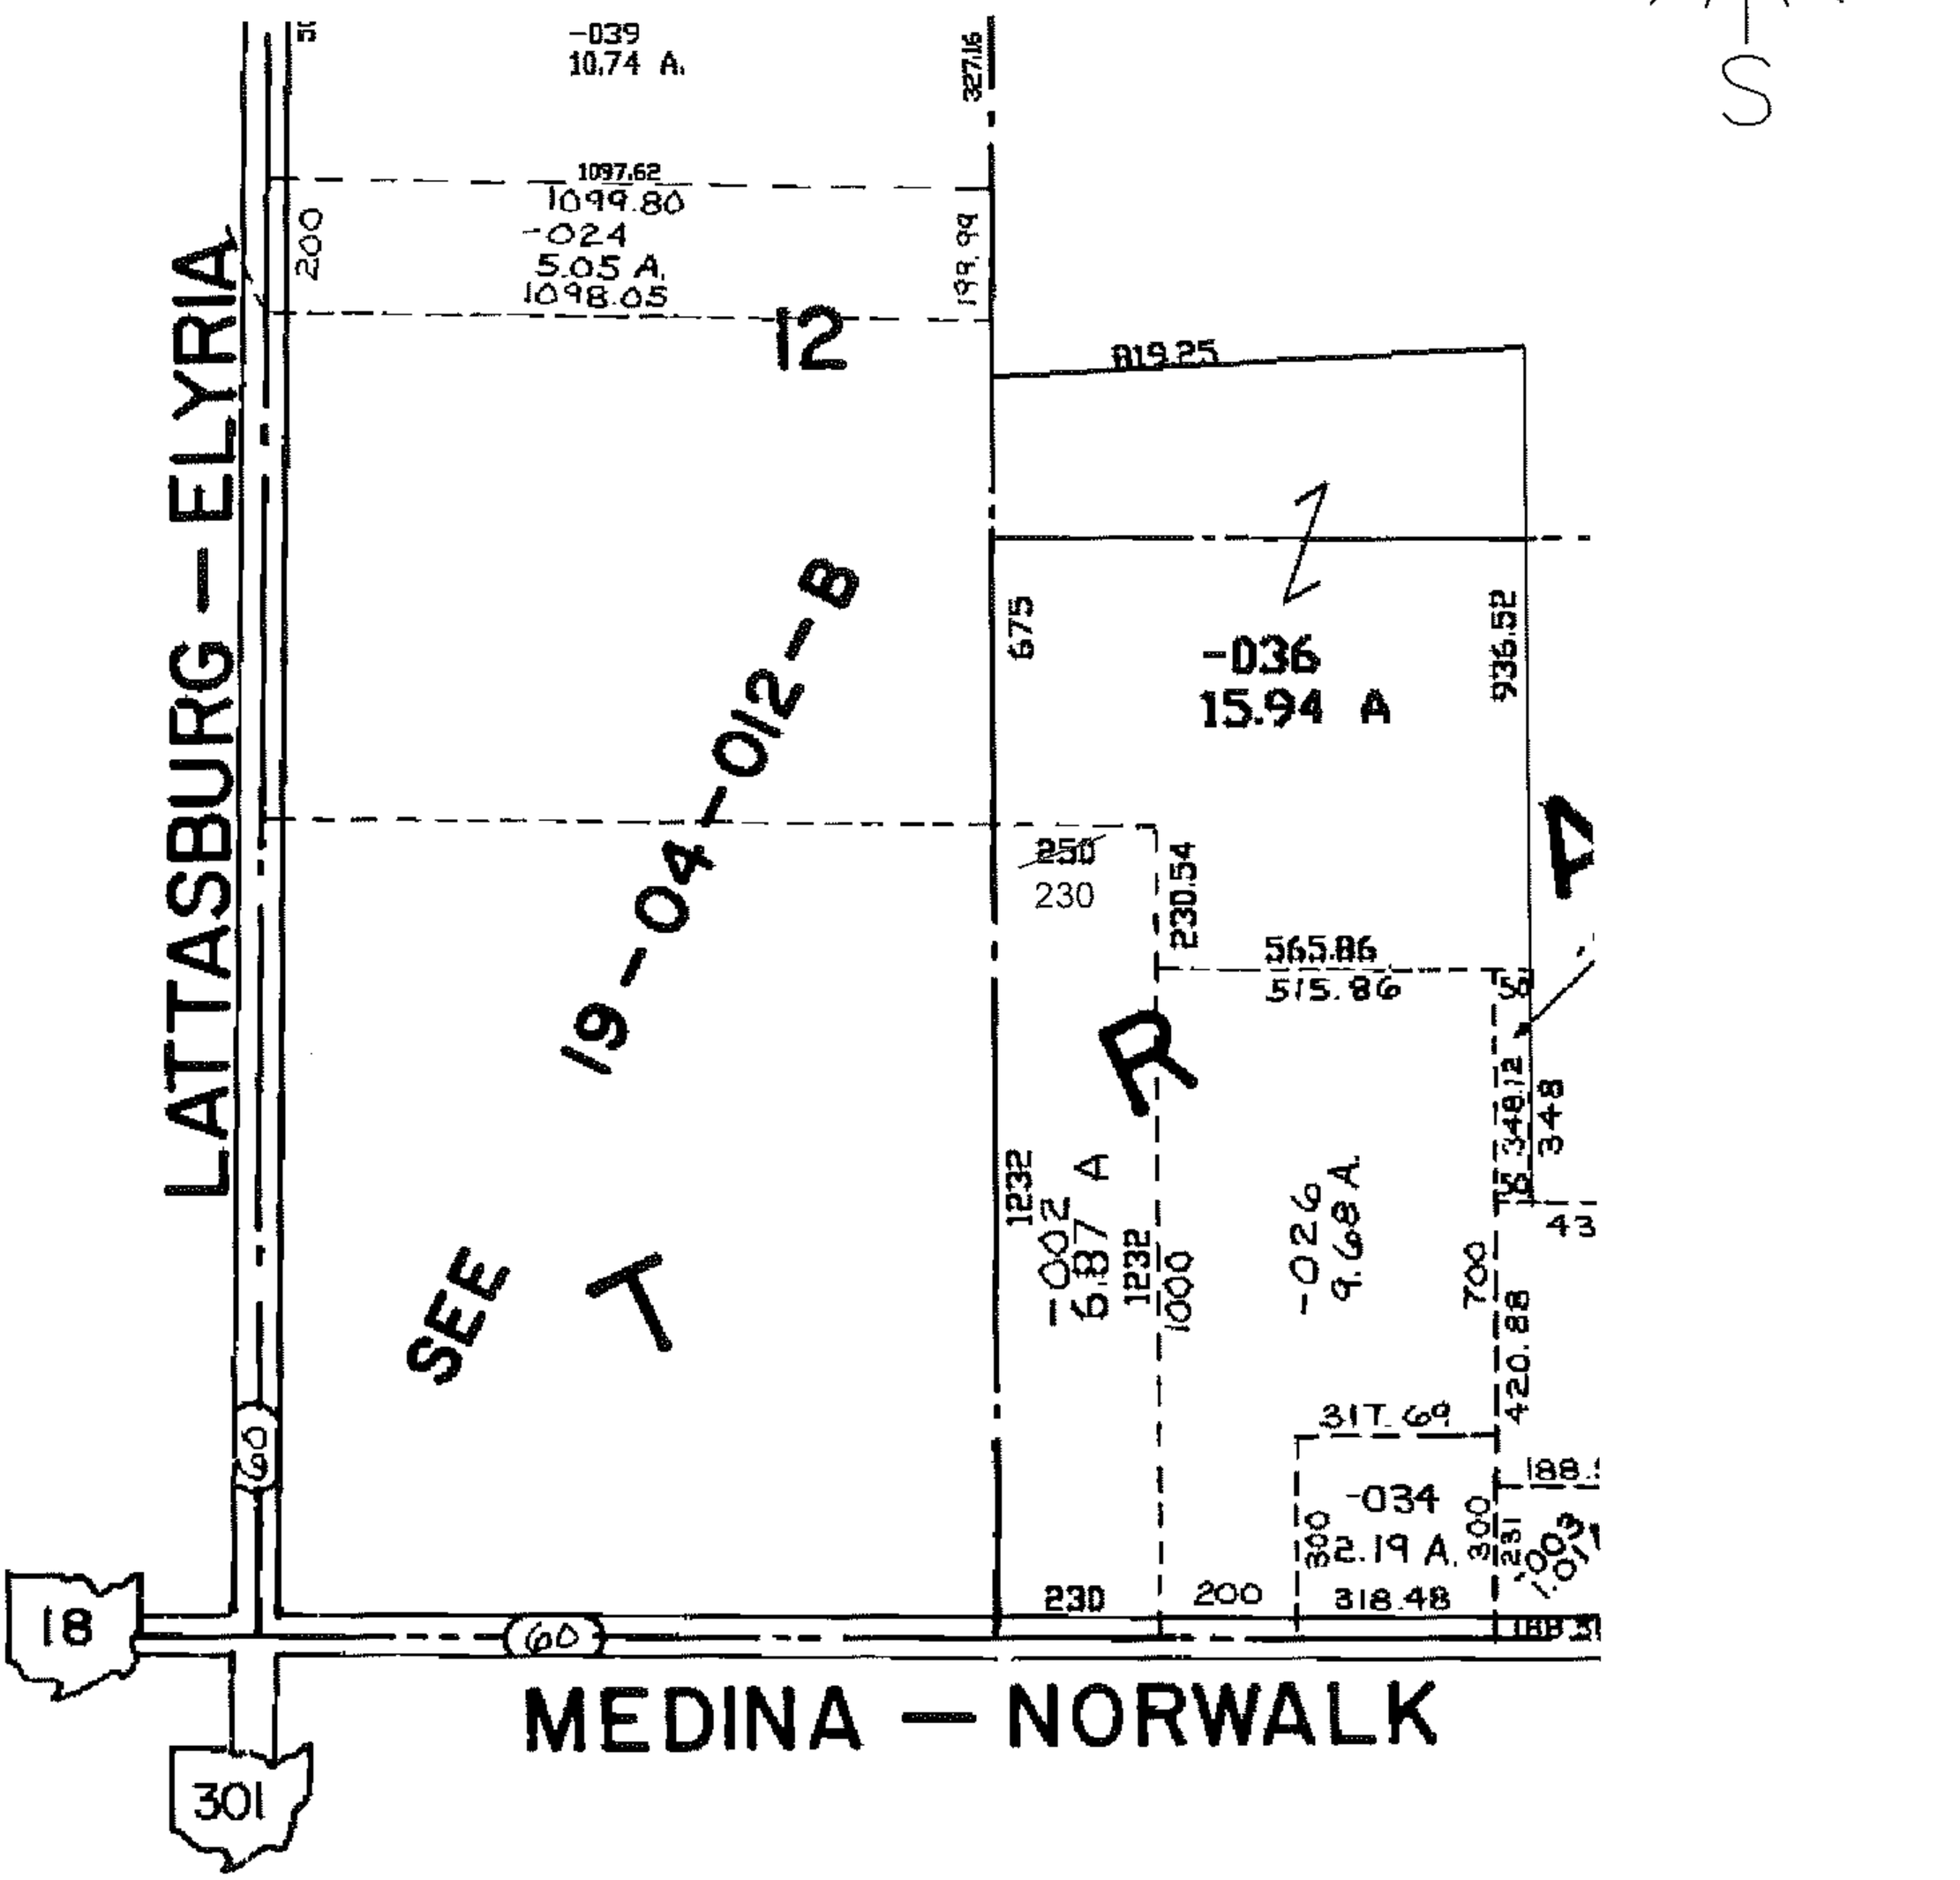

SPLITS/DEEDS PROCESSED

LORAIN COUNTY TAX MAP DEPARTMENT
226 MIDDLE AVE. ELYRIA, OHIO

SURVEYED BY: N/A

CLOSURE: N/A

MAP PAGE(S): 19-C

APPROVED BY: DRH DATE: 11/3/2008

SCALE: NOT TO SCALE PRIOR INST.: 19980537960