RASTER

PARENT PARCEL: 06-24-106-000-014, 016

CHILD PARCEL: --SAME--

STARTING POINT: SW CORNER OF SUBLOT 4 IN ALLEN H. LAKES ADDITION PV 2/22

08-01724-C

DIM CORR
PER DEED

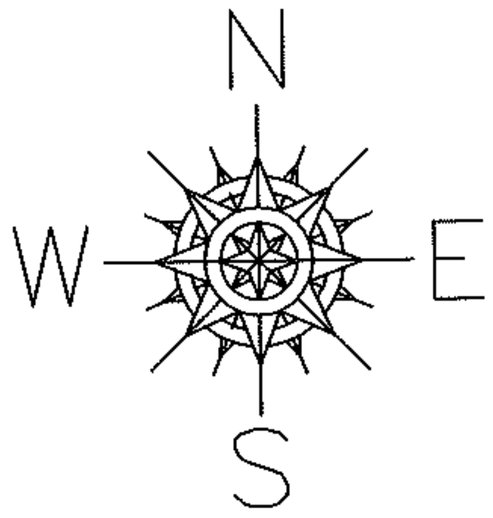


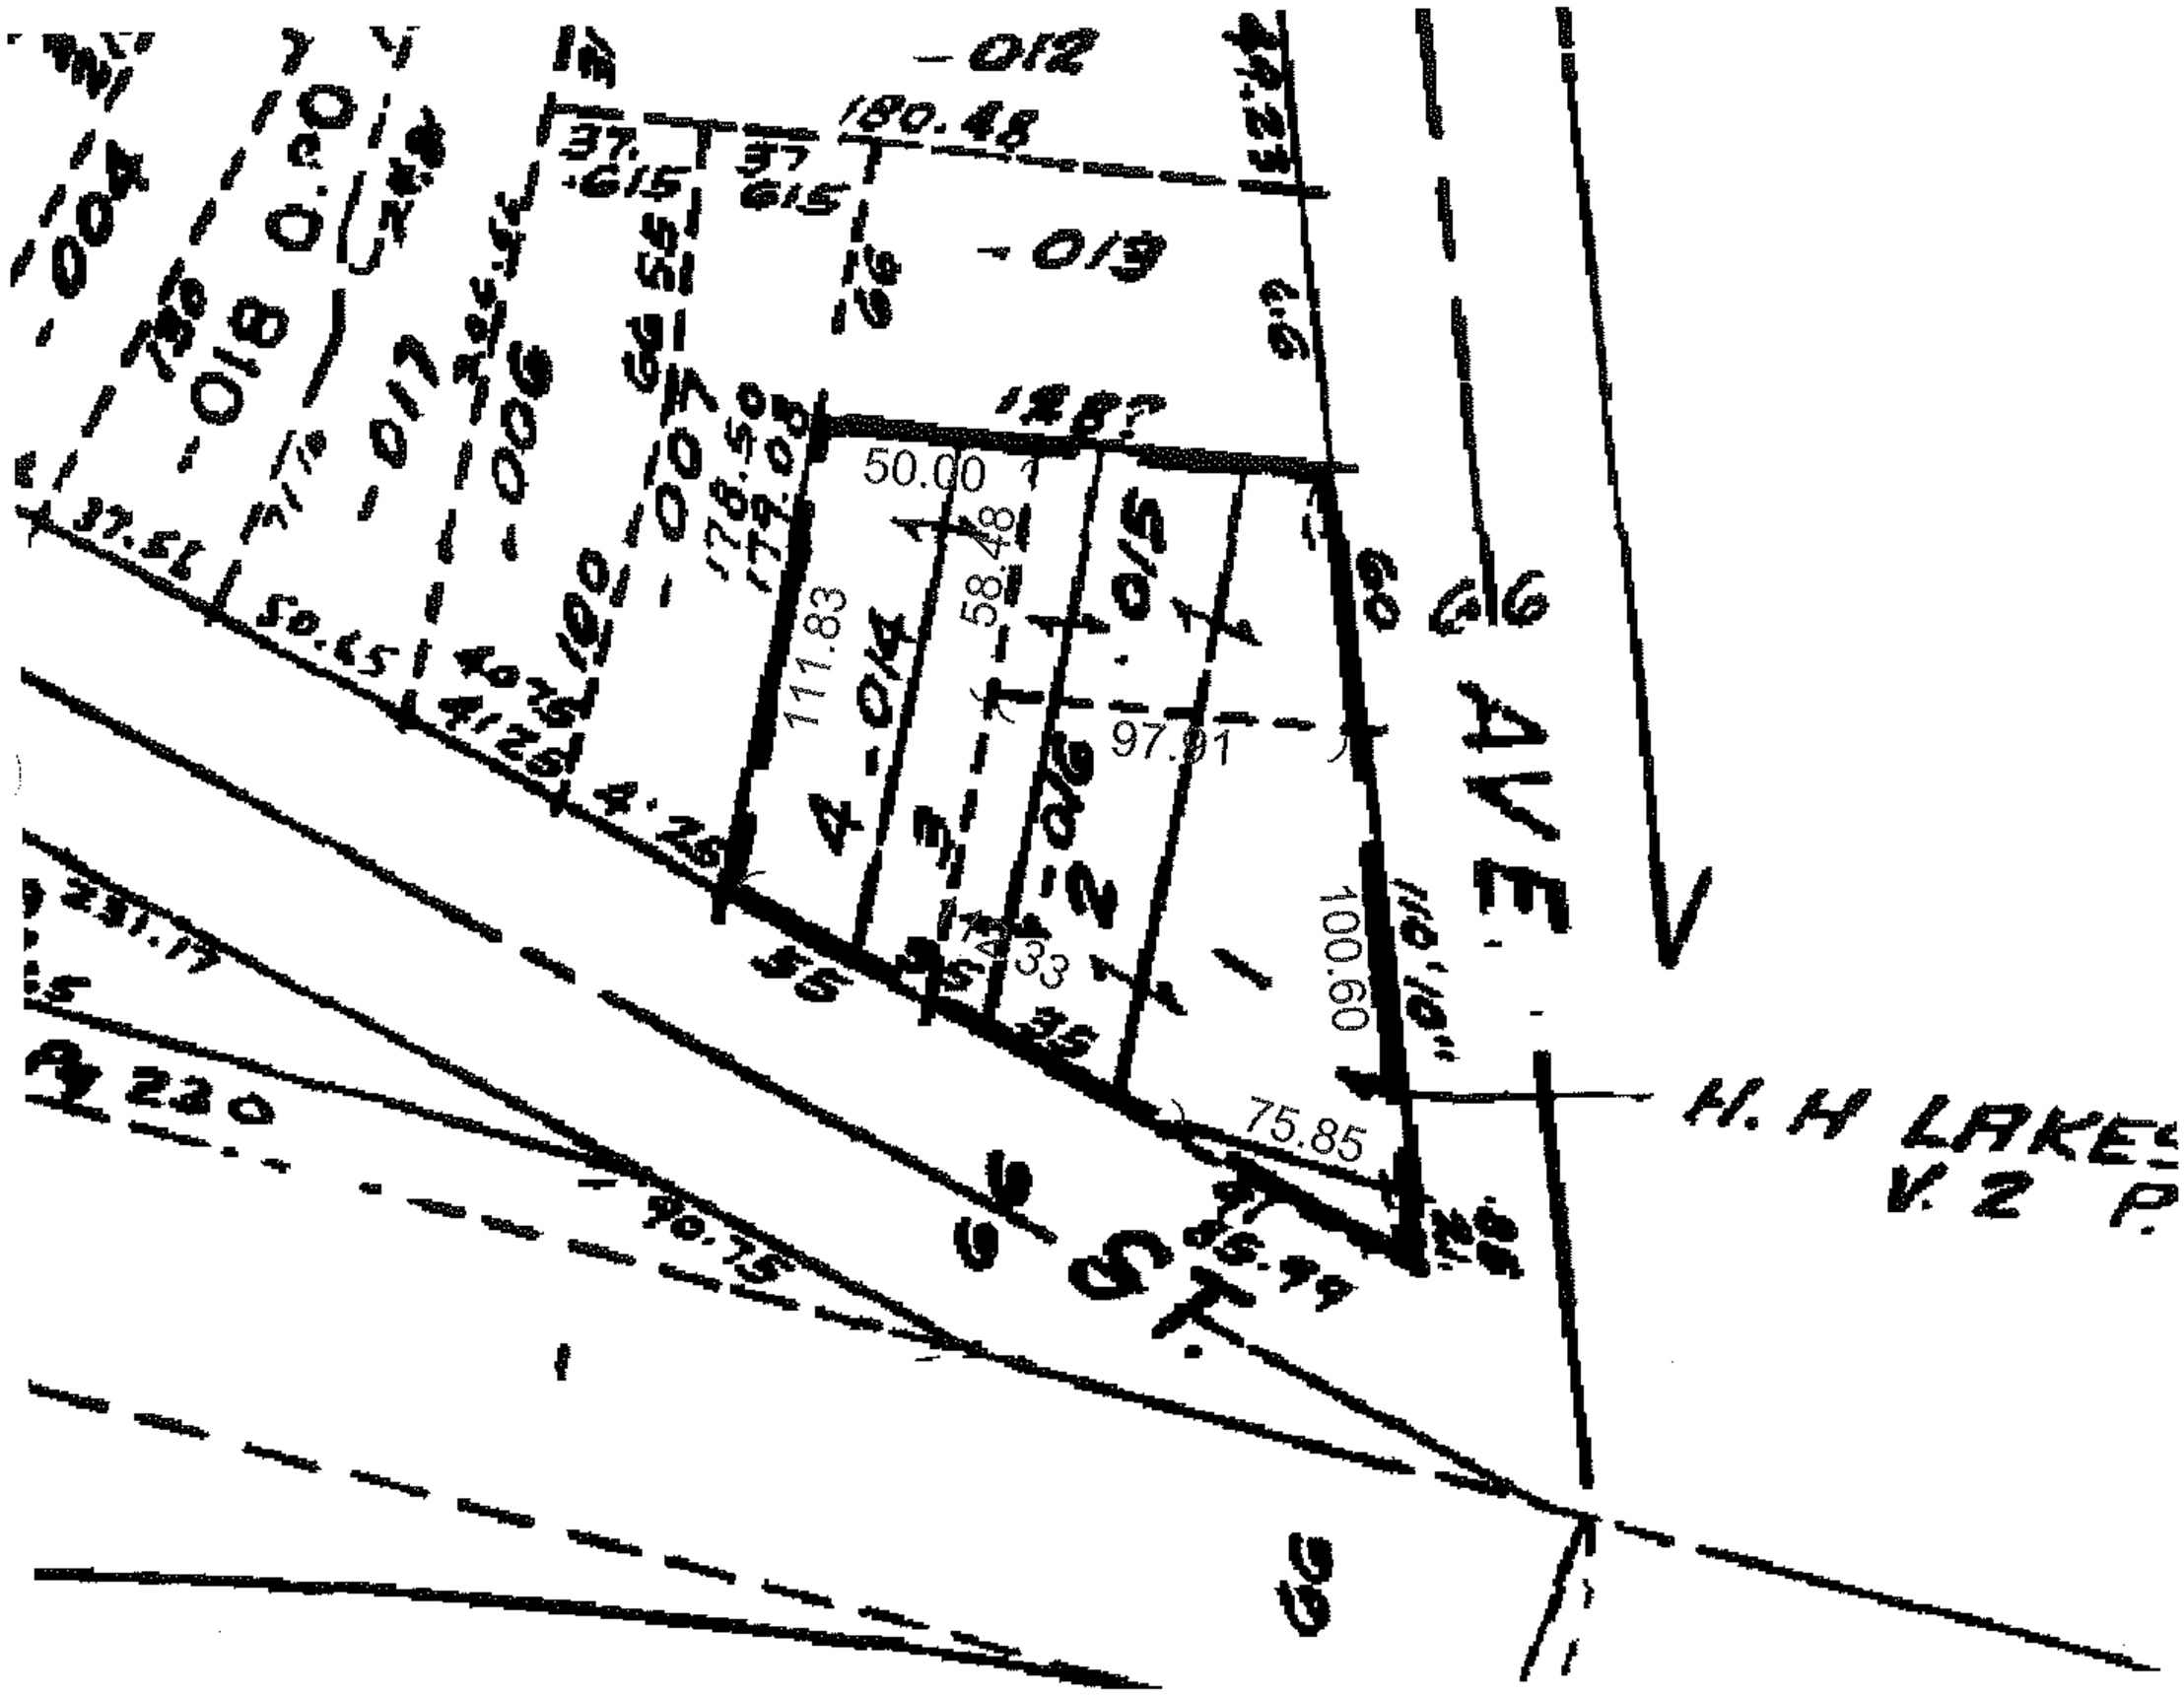


SPLITS/DEEDS PROCESSED

LORAIN COUNTY TAX MAP DEPARTMENT
226 MIDDLE AVE. ELYRIA, OHIO

SURVEYED BY: N/A

CLOSURE: N/A

MAP PAGE(S): 06-99

APPROVED BY: DRH DATE: 12/2/2008

SCALE: NOT TO SCALE PRIOR INST.: DV 1198/627