PARENT PARCEL: 11-00-070-000-141, -069 11-00-069-000-012

CHILD PARCEL: 11-00-070-000-144 THRU -146 11-00-071-000-104, 11-00-072-000-072, **

STARTING POINT: CENTERLINE OF ARCHER RD. & BUTTERNUT RIDGE RD.

** 11-00-069-000-015

~~01735XXX X~~

01735

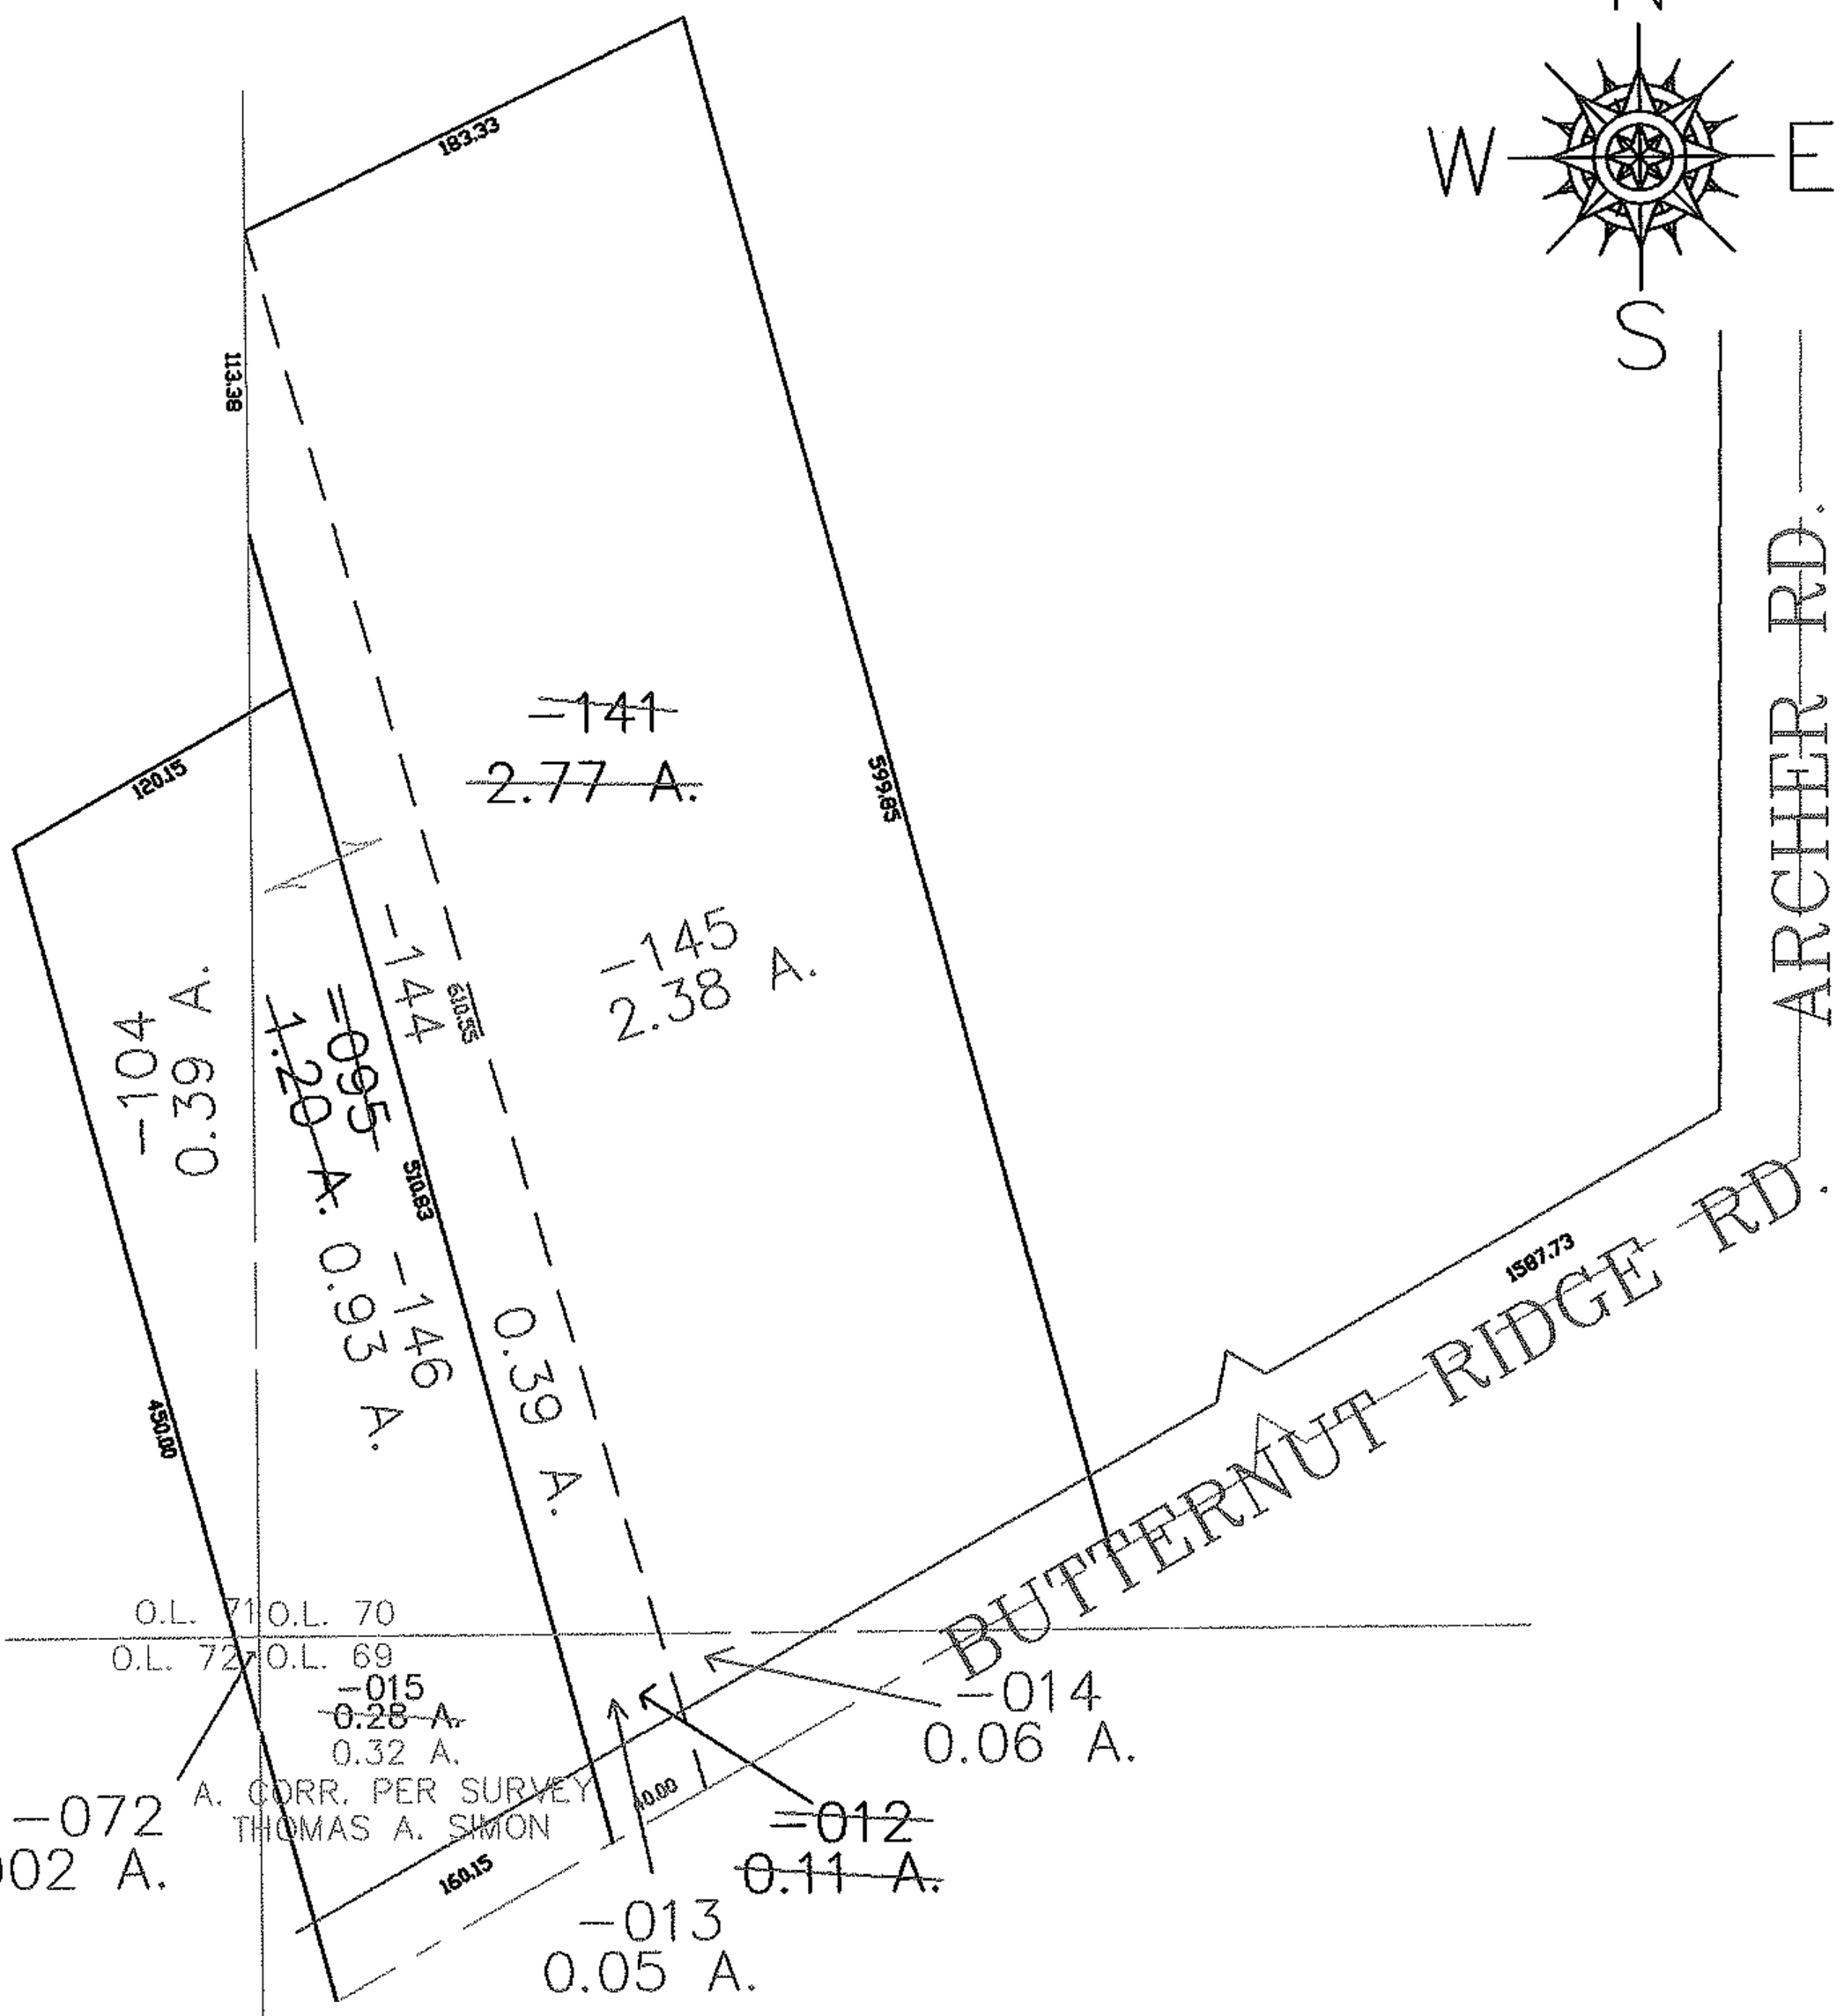

SPLITS/DEEDS PROCESSED

LORAIN COUNTY TAX MAP DEPARTMENT
226 MIDDLE AVE. ELYRIA, OHIO

SURVEYED BY: THOMAS A. SIMON
CLOSURE: 0.00 : 10,000
MAP PAGE(S): 11-00-070-A
APPROVED BY: JAH DATE: 8-17-04
SCALE: 1"= 100 PRIOR INSTRUMENT: 200401622085