PARENT PARCEL: 06-26-048-000-020

CHILD PARCEL: --SAME--

STARTING POINT: S/L 329 IN HEMAN ELY'S TOWN PLAT V 3 P 14

09-01774-C

DEPTH CORR PER DEED

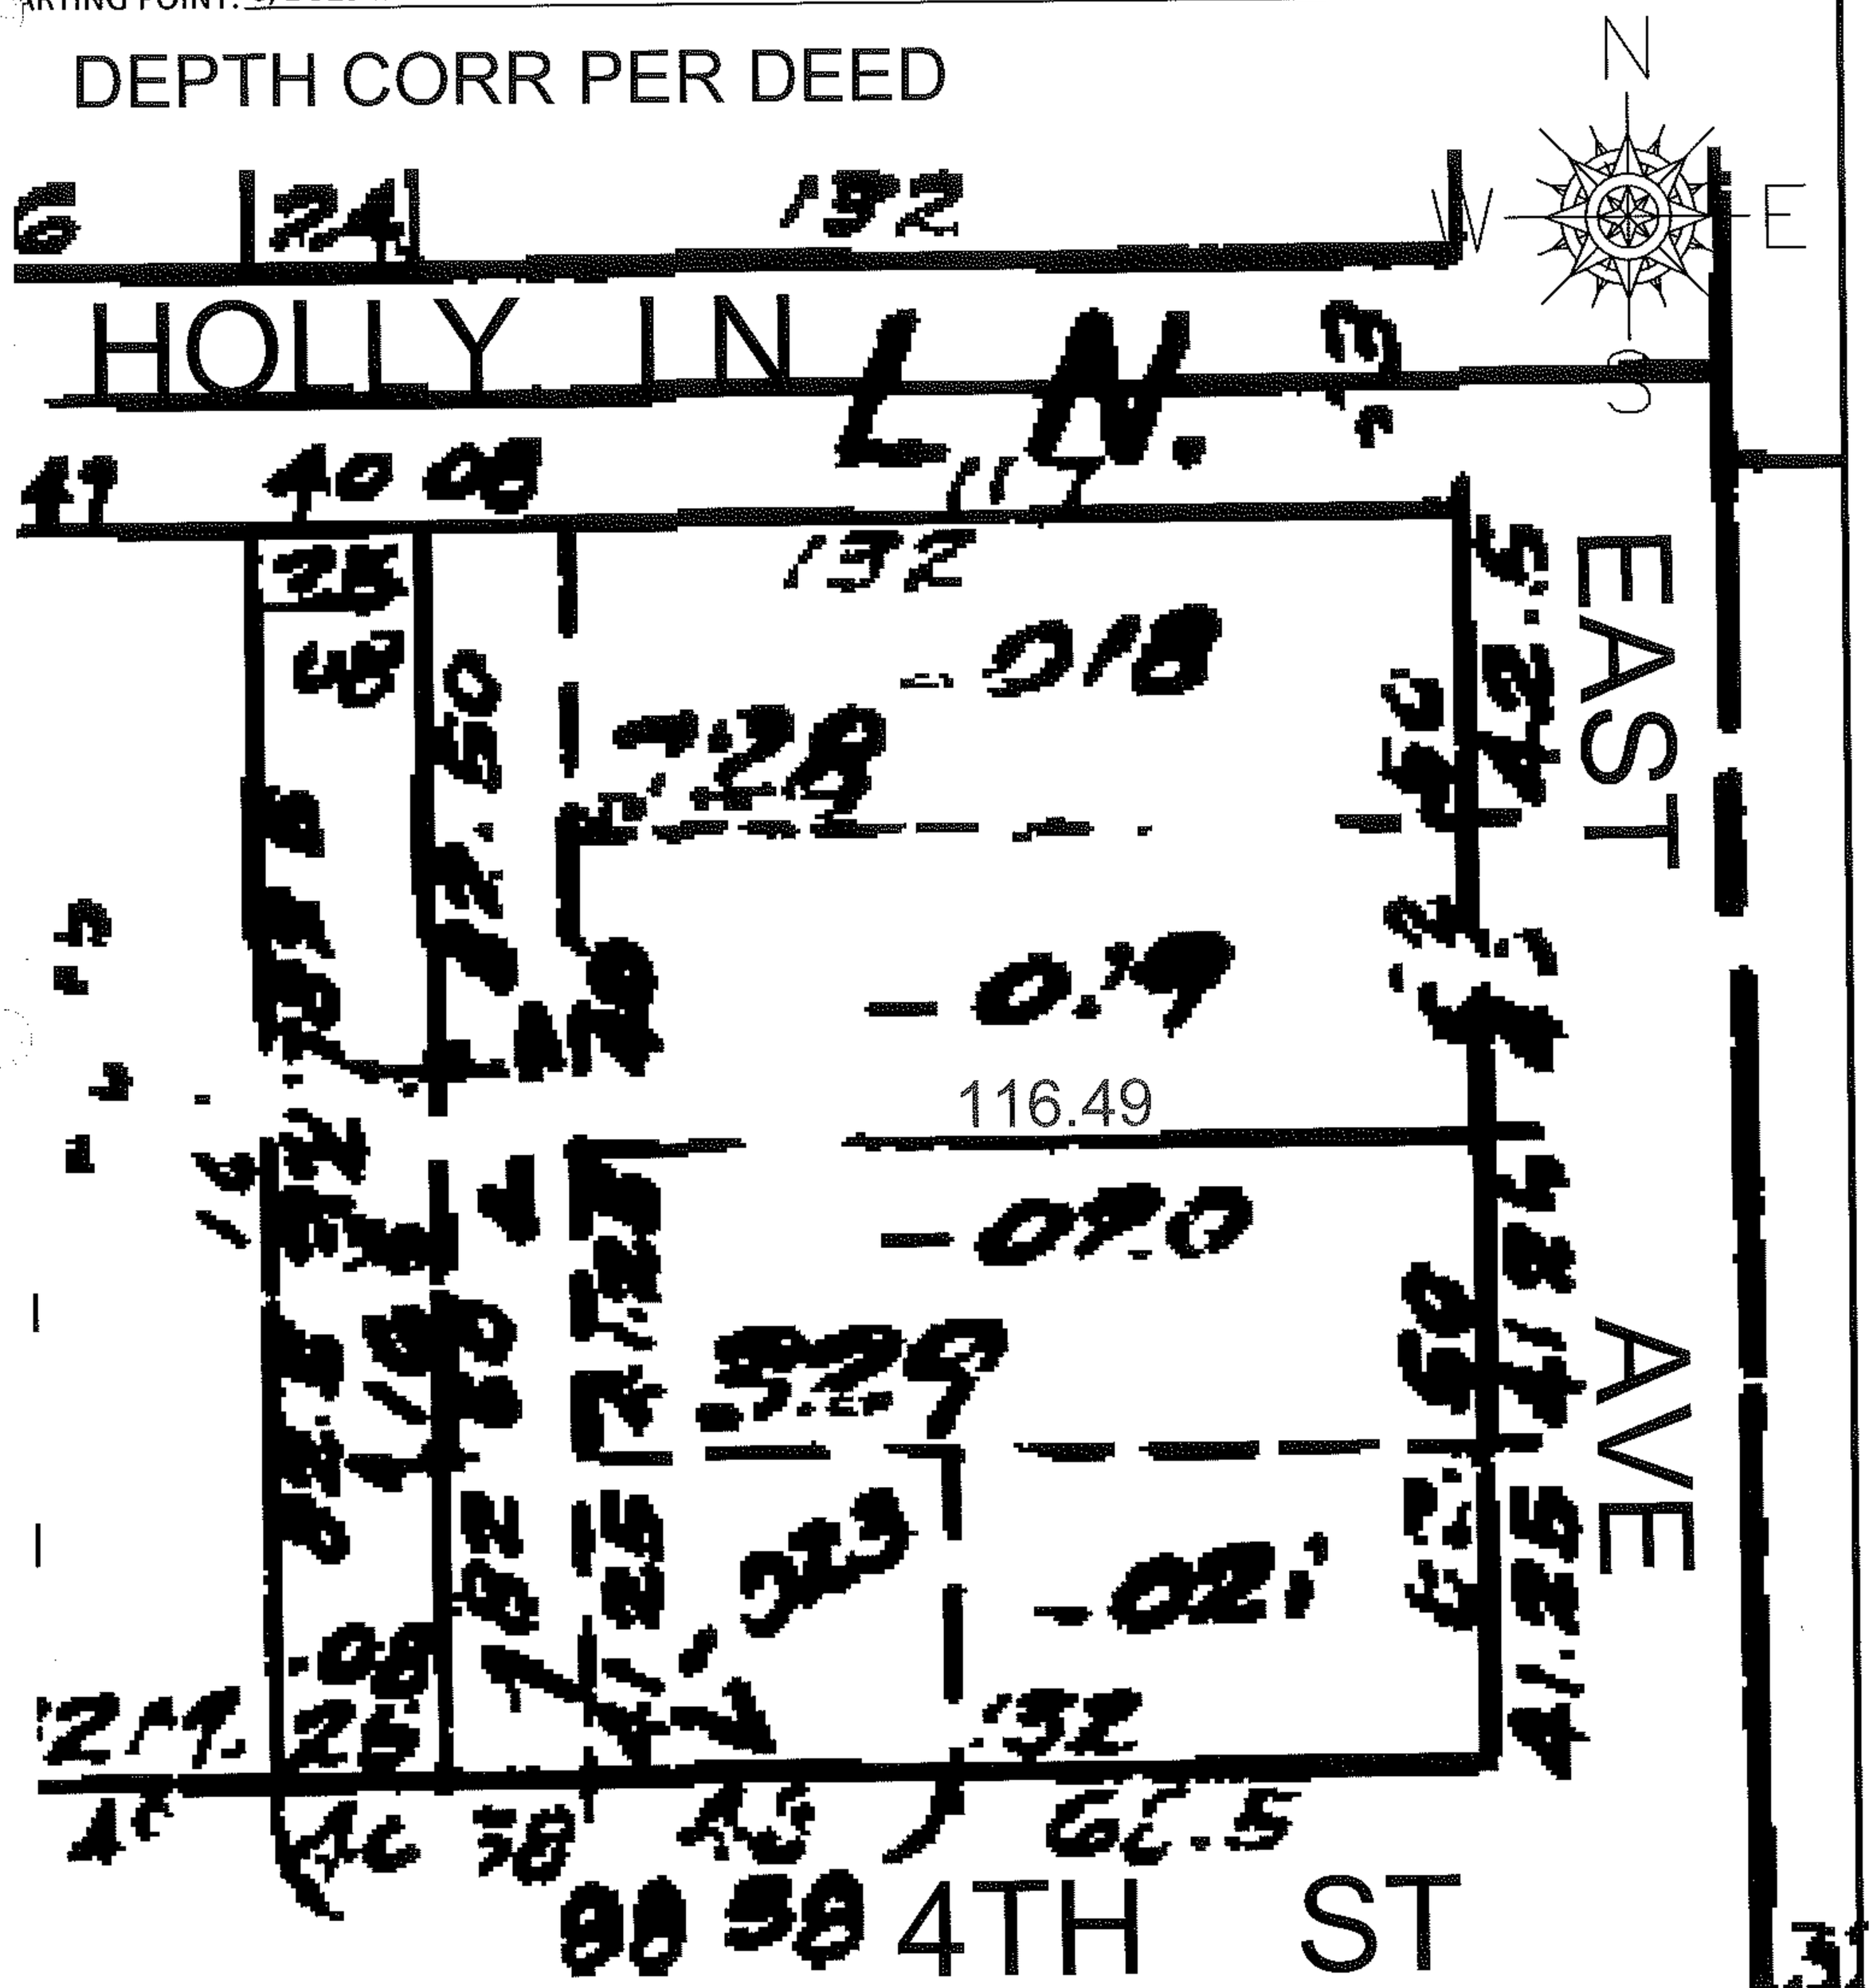

SPLITS/DEEDS PROCESSED

LORAIN COUNTY TAX MAP DEPARTMENT

226 MIDDLE AVE. ELYRIA, OHIO

SURVEYED BY: N/A

CLOSURE: N/A

MAP PAGE(S): 06-120

APPROVED BY: DRH DATE: 6/15/2009

SCALE: NOT TO SCALE PRIOR INST.: 20080275558