PARENT PARCEL: 06-25-020-108-037

CHILD PARCEL: --SAME--

STARTING POINT: S/L 31 IN THE CLEVELAND ST. ALLOTMENT PV 13 P 41

09-01792-C

DEPTH CORR PER PLAT AND DEED
NO MAP CORR

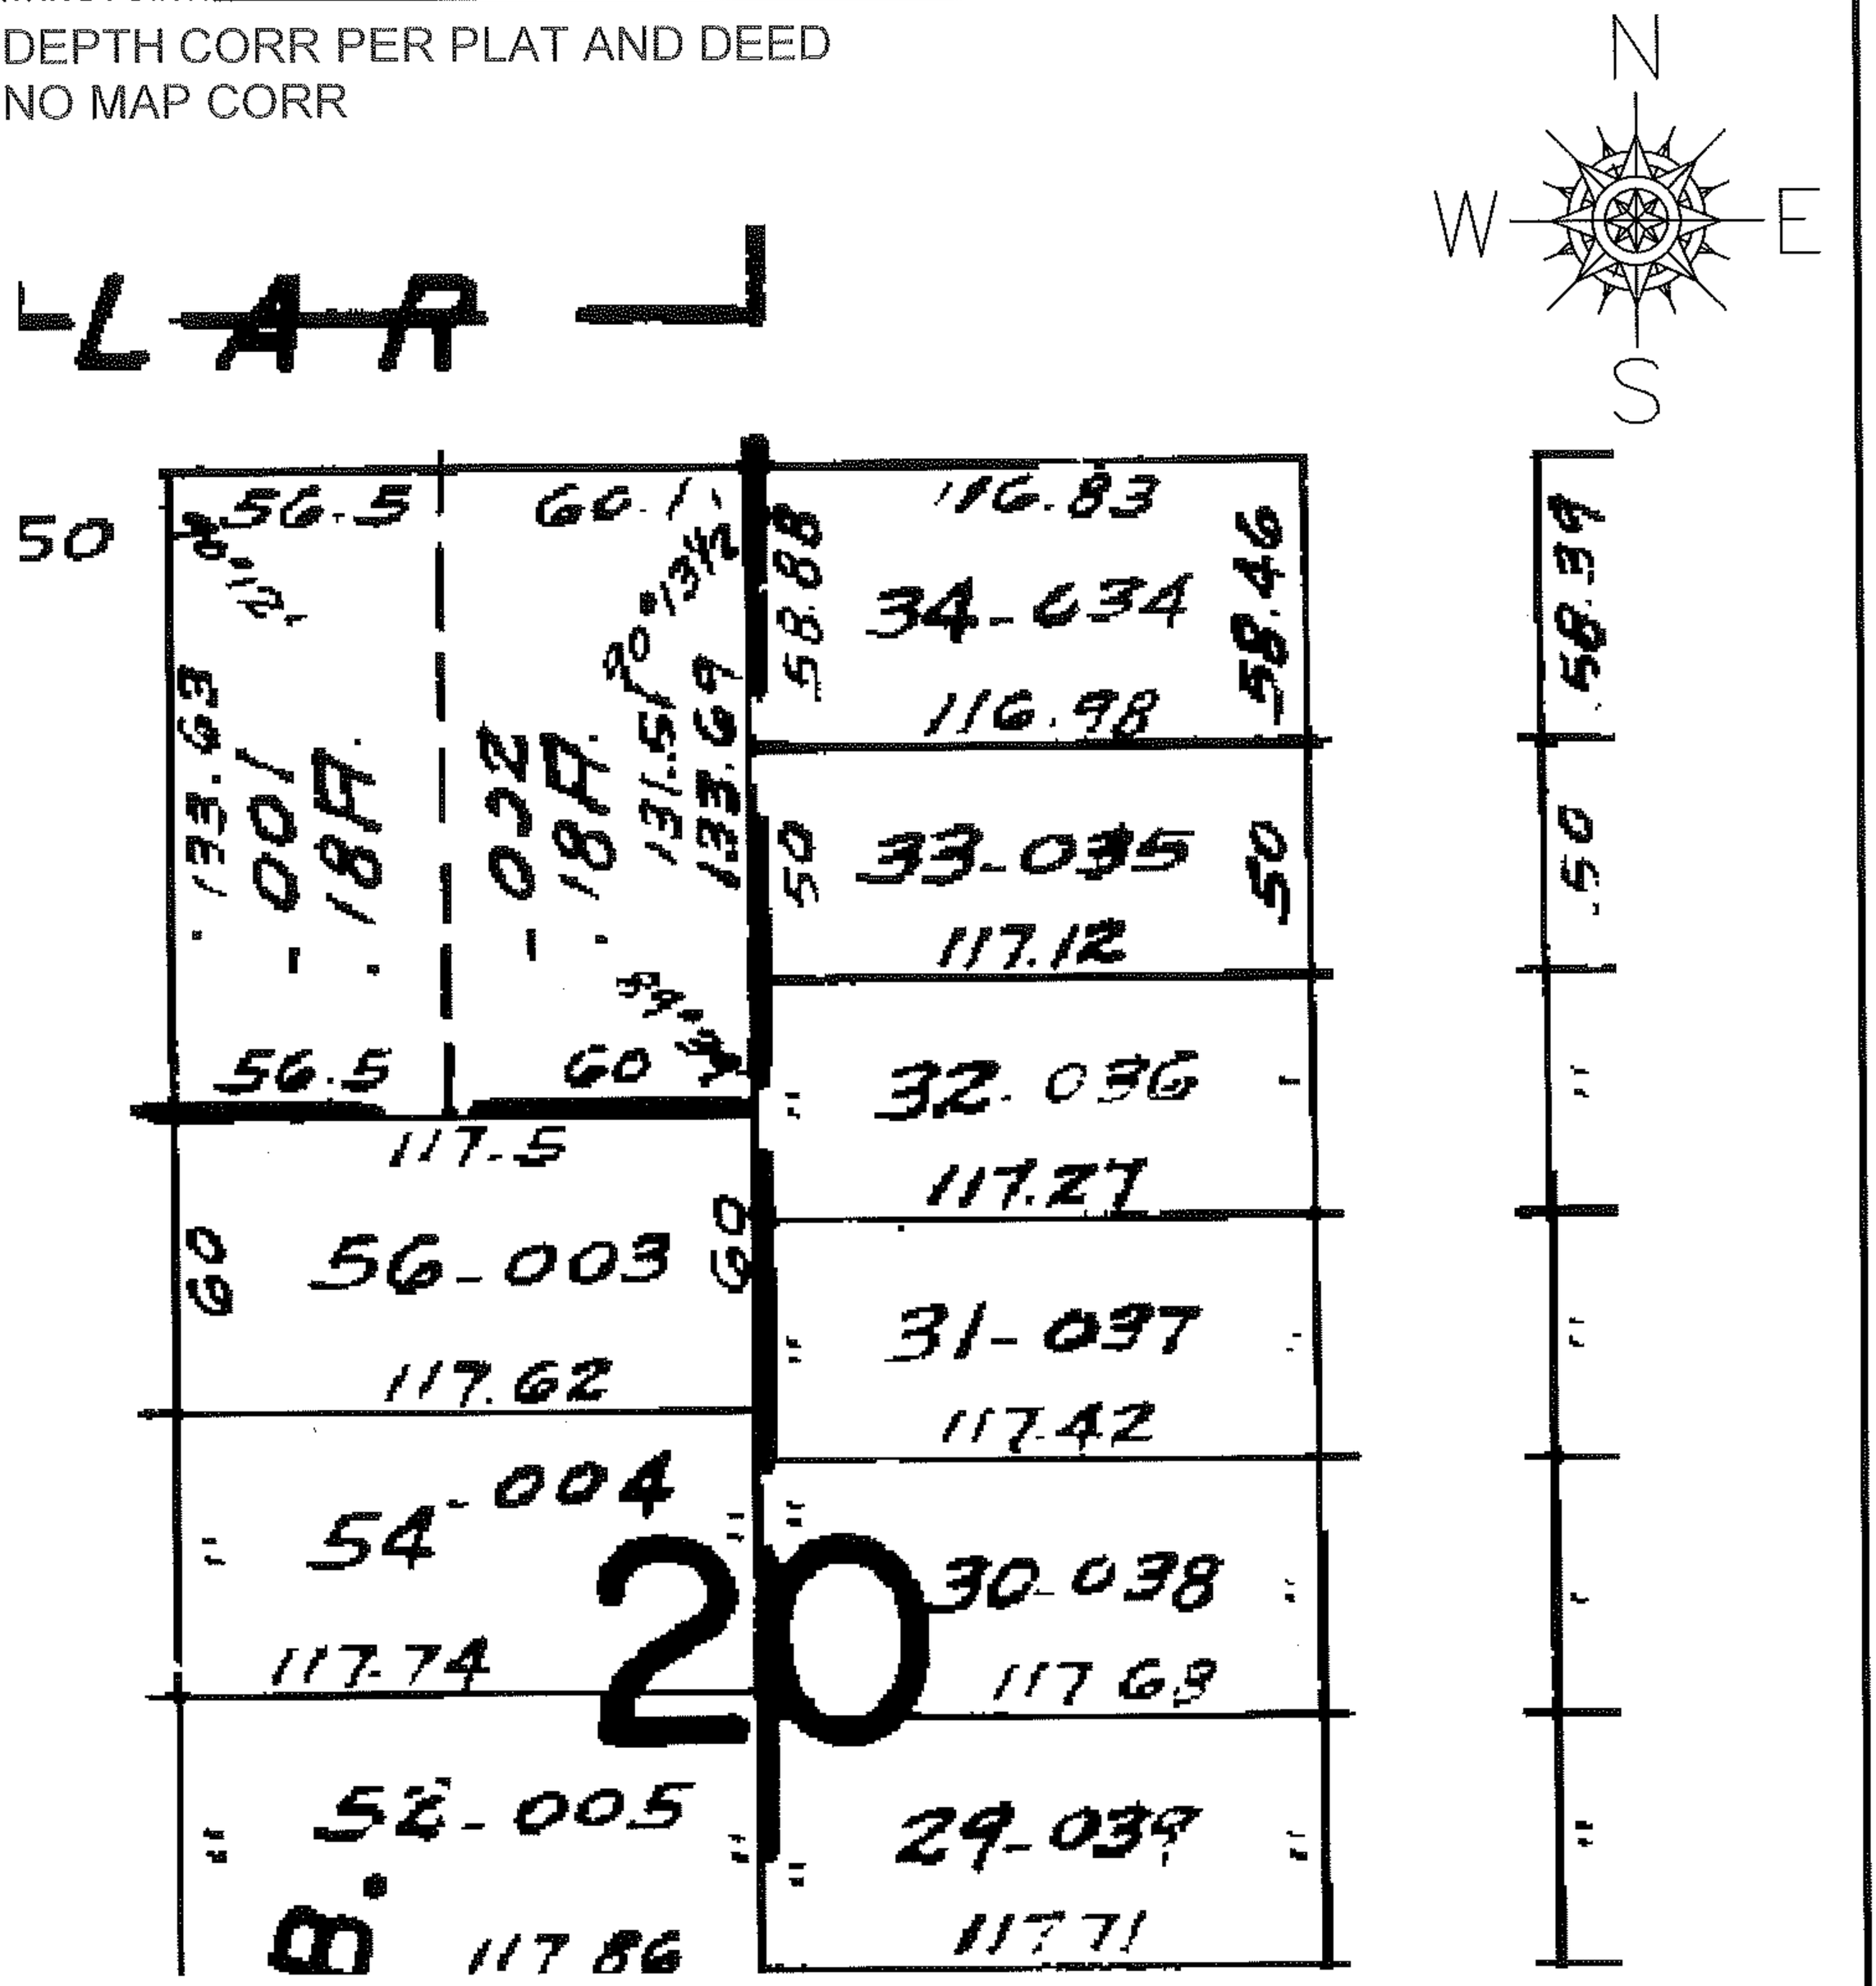

SPLITS/DEEDS PROCESSED

LORAIN COUNTY TAX MAP DEPARTMENT
226 MIDDLE AVE. ELYRIA, OHIO

SURVEYED BY: N/A

CLOSURE: N/A

MAP PAGE(S): 06-088

APPROVED BY: DRH DATE: 6/15/2009

SCALE: NOT TO SCALE PRIOR INST.: 20090291527