RASTER

PARENT PARCEL: 06-24-115-000-003

CHILD PARCEL: 06-24-115-000-004, -005

STARTING POINT: CENTERLINE OF WEST 3RD ST. & WEST RIVER RD. NORTH

NO. 1808

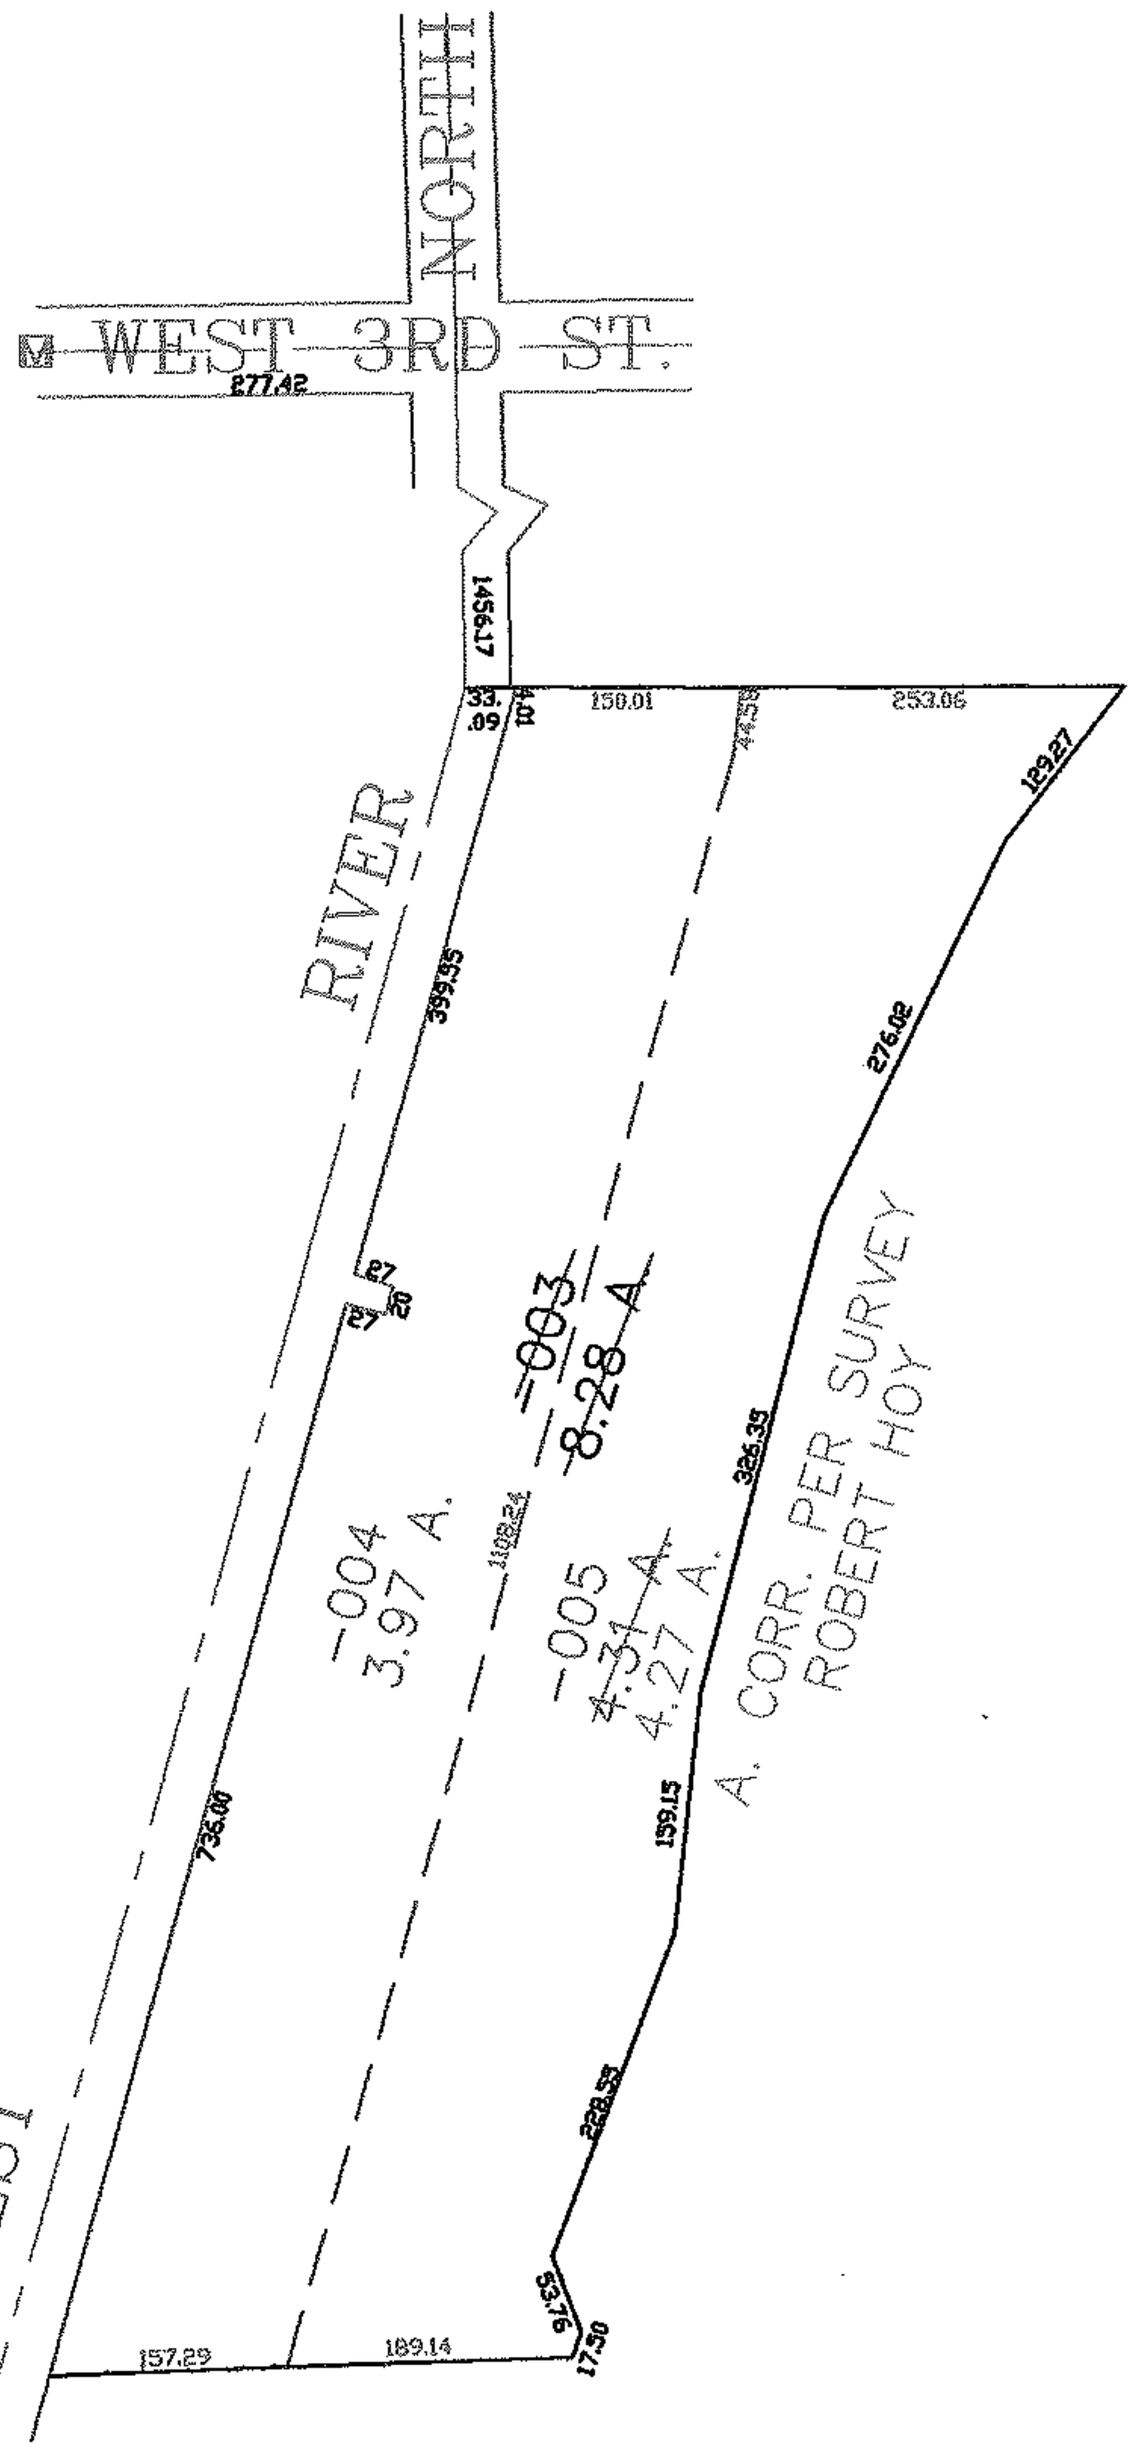

N
W E
S

SPLITS/DEEDS PROCESSED

LORAIN COUNTY TAX MAP DEPARTMENT
226 MIDDLE AVE. ELYRIA, OHIO

SURVEYED BY: ROBERT HOY

CLOSURE: 0.00 : 10,000

MAP PAGE(S): 6-136

APPROVED BY: JAH DATE: 1-4-04

SCALE: 1"= 200 PRIOR INSTRUMENT: DV 1191/463