RASTER

PARENT PARCEL: 07-00-023-102-045

CHILD PARCEL: 07-00-023-102-065, -066

STARTING POINT: CENTER LINE OF HAMKER CT. & DEER RUN DR.

NO. 01817

N

W E

S

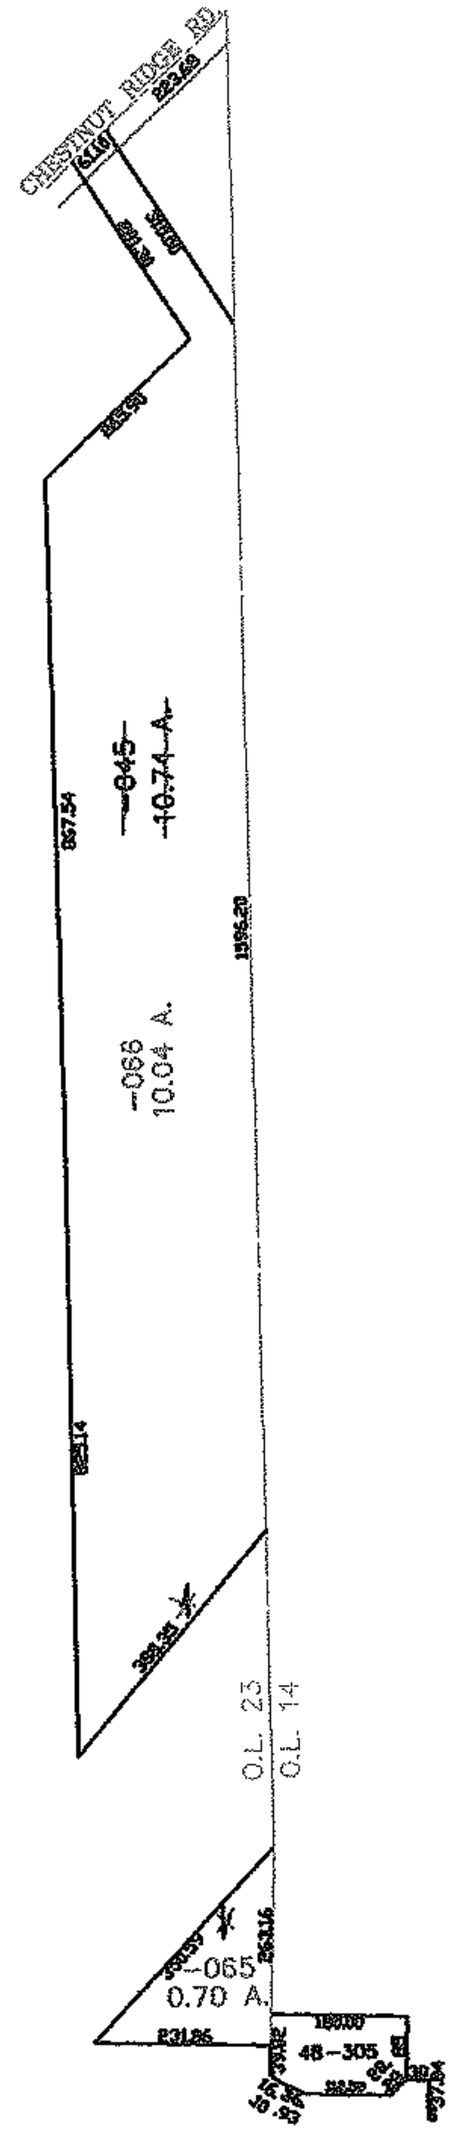

SPLITS/DEEDS PROCESSED

LORAIN COUNTY TAX MAP DEPARTMENT
226 MIDDLE AVE. ELYRIA, OHIO

SURVEYED BY: DANE HAPONEK

CLOSURE: 0.00 : 10,000

MAP PAGE(S): 07-00-023-0

APPROVED BY: JAH DATE: 12-20-04

SCALE: 1"= 400 PRIOR INSTRUMENT: OR 788/374