

RASTER

PARENT PARCEL: 04-00-023-103-018

CHILD PARCEL: N/A

STARTING POINT: Southwest corner of parcel 2 at centerline of Keller St.

09-01821-C


Frontage and Depth Correction

04-00-023-103-018

~~100.00x183.00~~

100.00x183.30

Correction per Deed

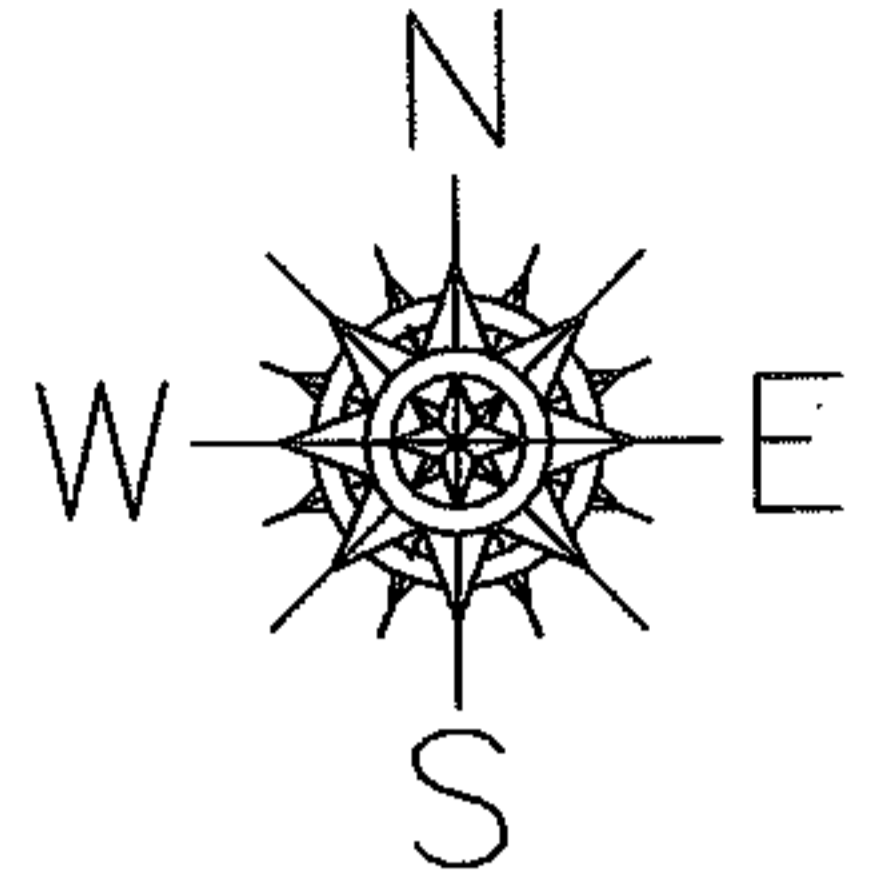


100.00

2

-018

~~183.00~~
183.30

Keller Street

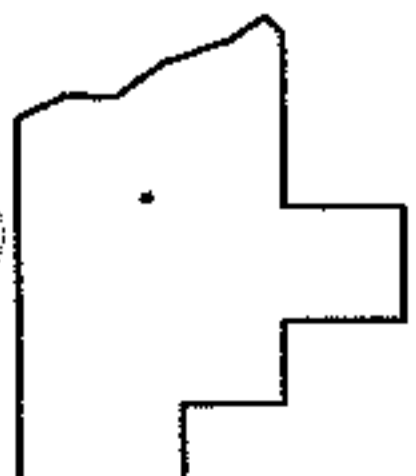

SPLITS/DEEDS PROCESSED

LORAIN COUNTY TAX MAP DEPARTMENT
226 MIDDLE AVE. ELYRIA, OHIO

SURVEYED BY: N/A

CLOSURE: 1:566600000.00

MAP PAGE(S): 04-00-023-B

APPROVED BY: CJB DATE: 5/13/09

SCALE: 1"=50' PRIOR INST.: DV 0861/0589