RASTER

PARENT PARCEL: 06-25-024-103-014, -020, -033
CHILD PARCEL: 06-25-024-103-034, -035
STARTING POINT: CENTERLINE OF CLEVELAND-ELYRIA RD. & JOHN F. KENNEDY PKWY

NO. 01822

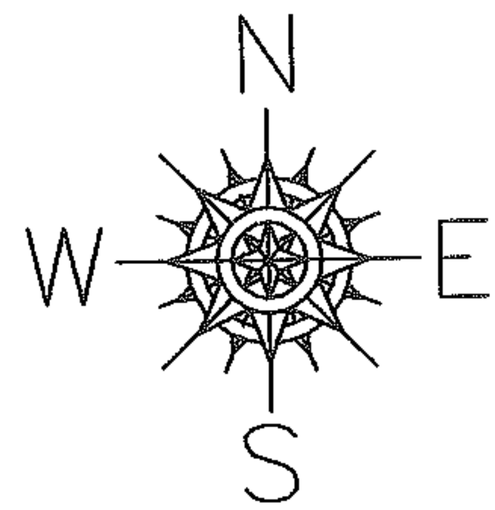

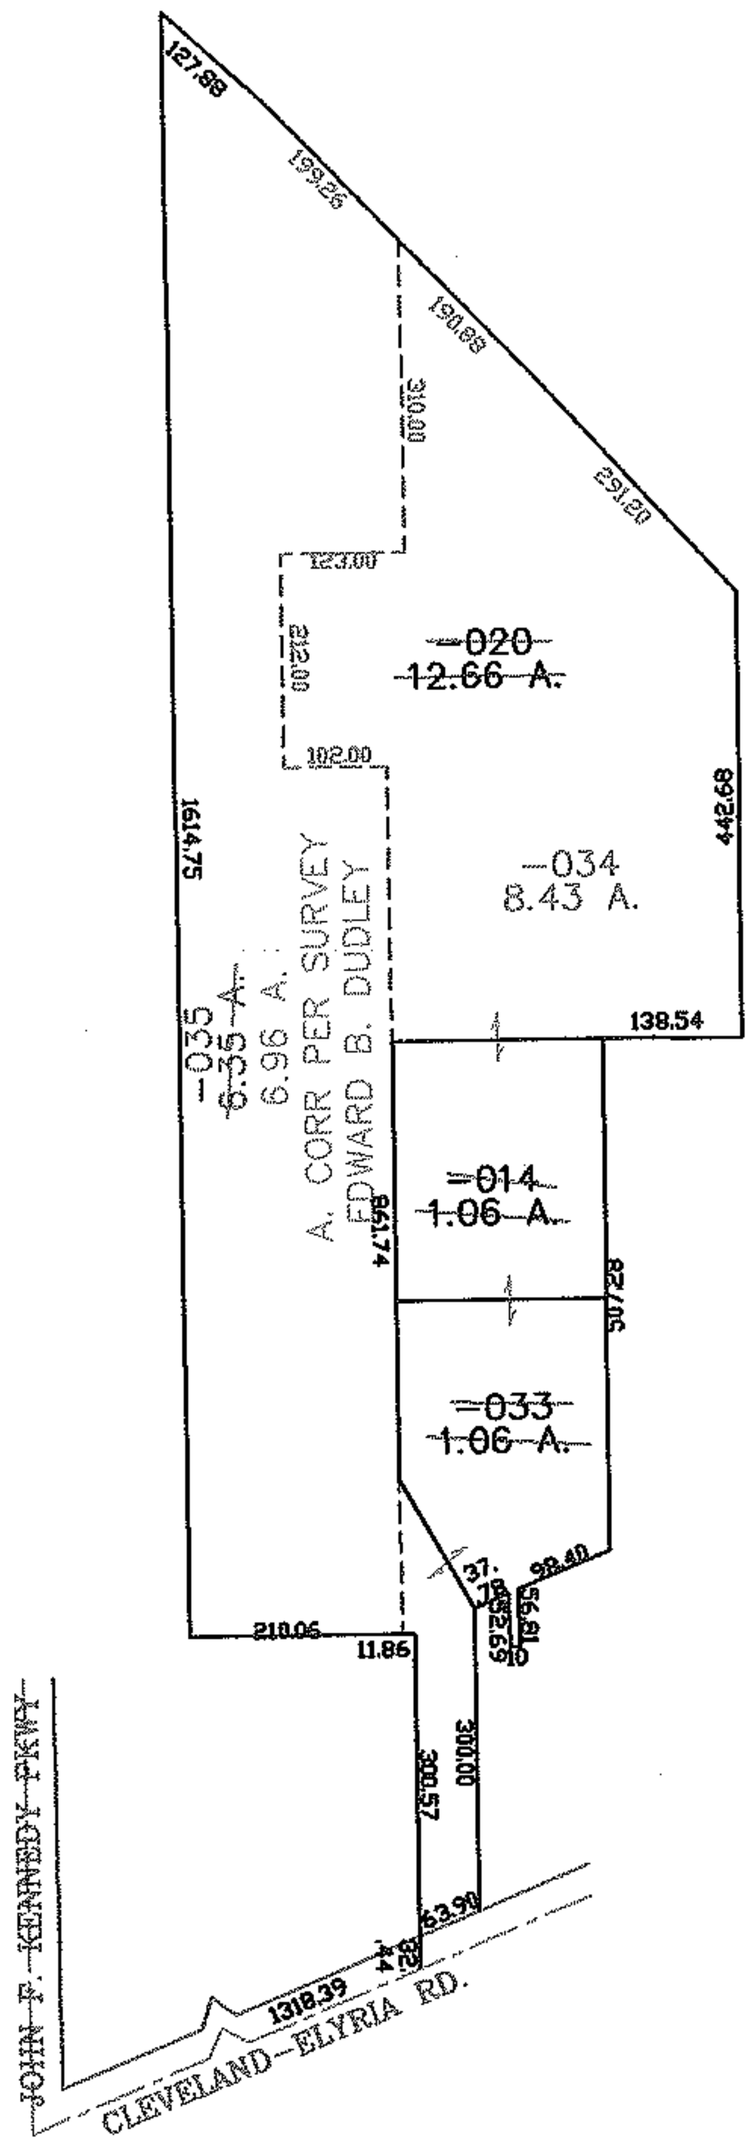

SPLITS/DEEDS PROCESSED
LORAIN COUNTY TAX MAP DEPARTMENT
226 MIDDLE AVE. ELYRIA, OHIO

SURVEYED BY: EDWARD DUDLEY
CLOSURE: 0.00 : 10,000
MAP PAGE(S): 6-90
APPROVED BY: JAH DATE: 12-22-04
SCALE: 1"= 300 PRIOR INSTRUMENT: 20030887991