PARENT PARCEL: 11-00-098-000-044

CHILD PARCEL: 11-00-098-000-149, -150

STARTING POINT: CENTERLINE OF ELYRIA-GRAFTON RD. & O.L. 98

NO. 01828

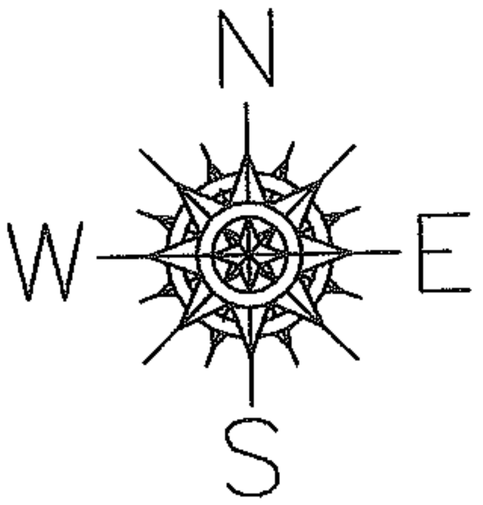

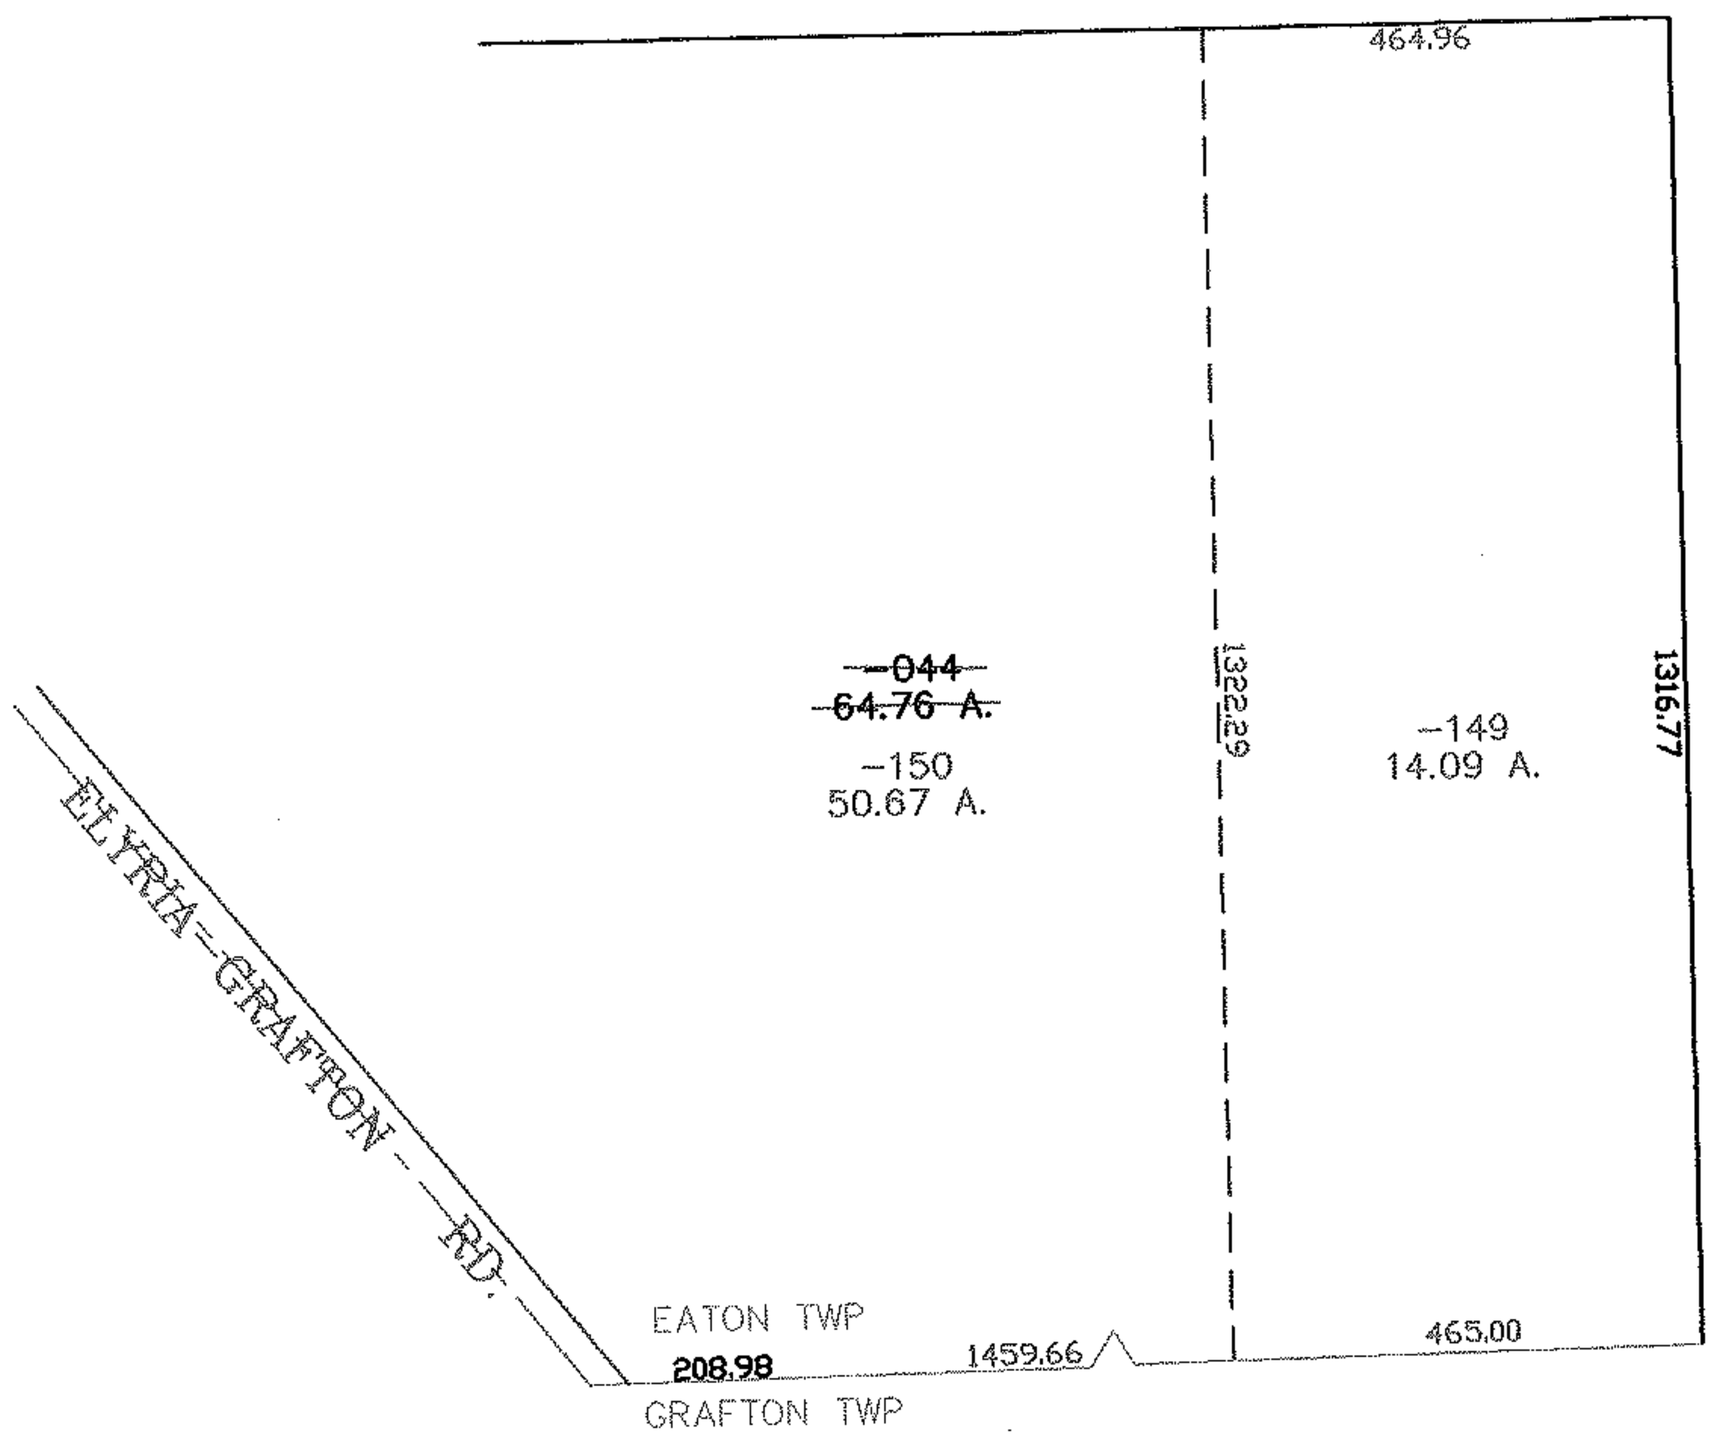

SPLITS/DEEDS PROCESSED

LORAIN COUNTY TAX MAP DEPARTMENT
226 MIDDLE AVE. ELYRIA, OHIO

SURVEYED BY: TREVOR BIXLER

CLOSURE: 0.00 : 10,000

MAP PAGE(S): 11-00-098-A

APPROVED BY: JAH DATE: 12-28-04

SCALE: 1"= 300 PRIOR INSTRUMENT: 20020853838