RASTER

PARENT PARCEL: 09-00-027-000-004
CHILD PARCEL: 09-00-027-000-027 THRU -030
STARTING POINT: CENTERLINE OF RUSSIA RD. & O.L. 27

NO. 01834

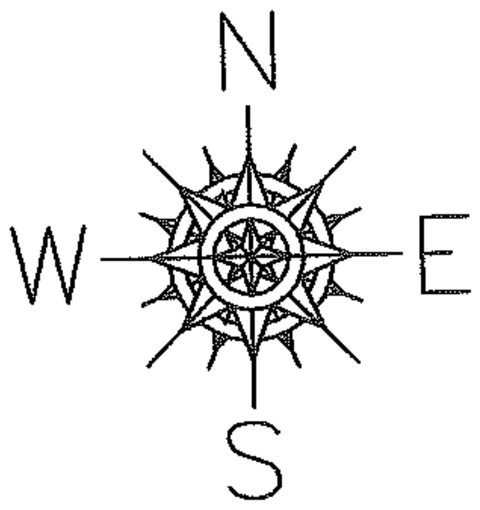

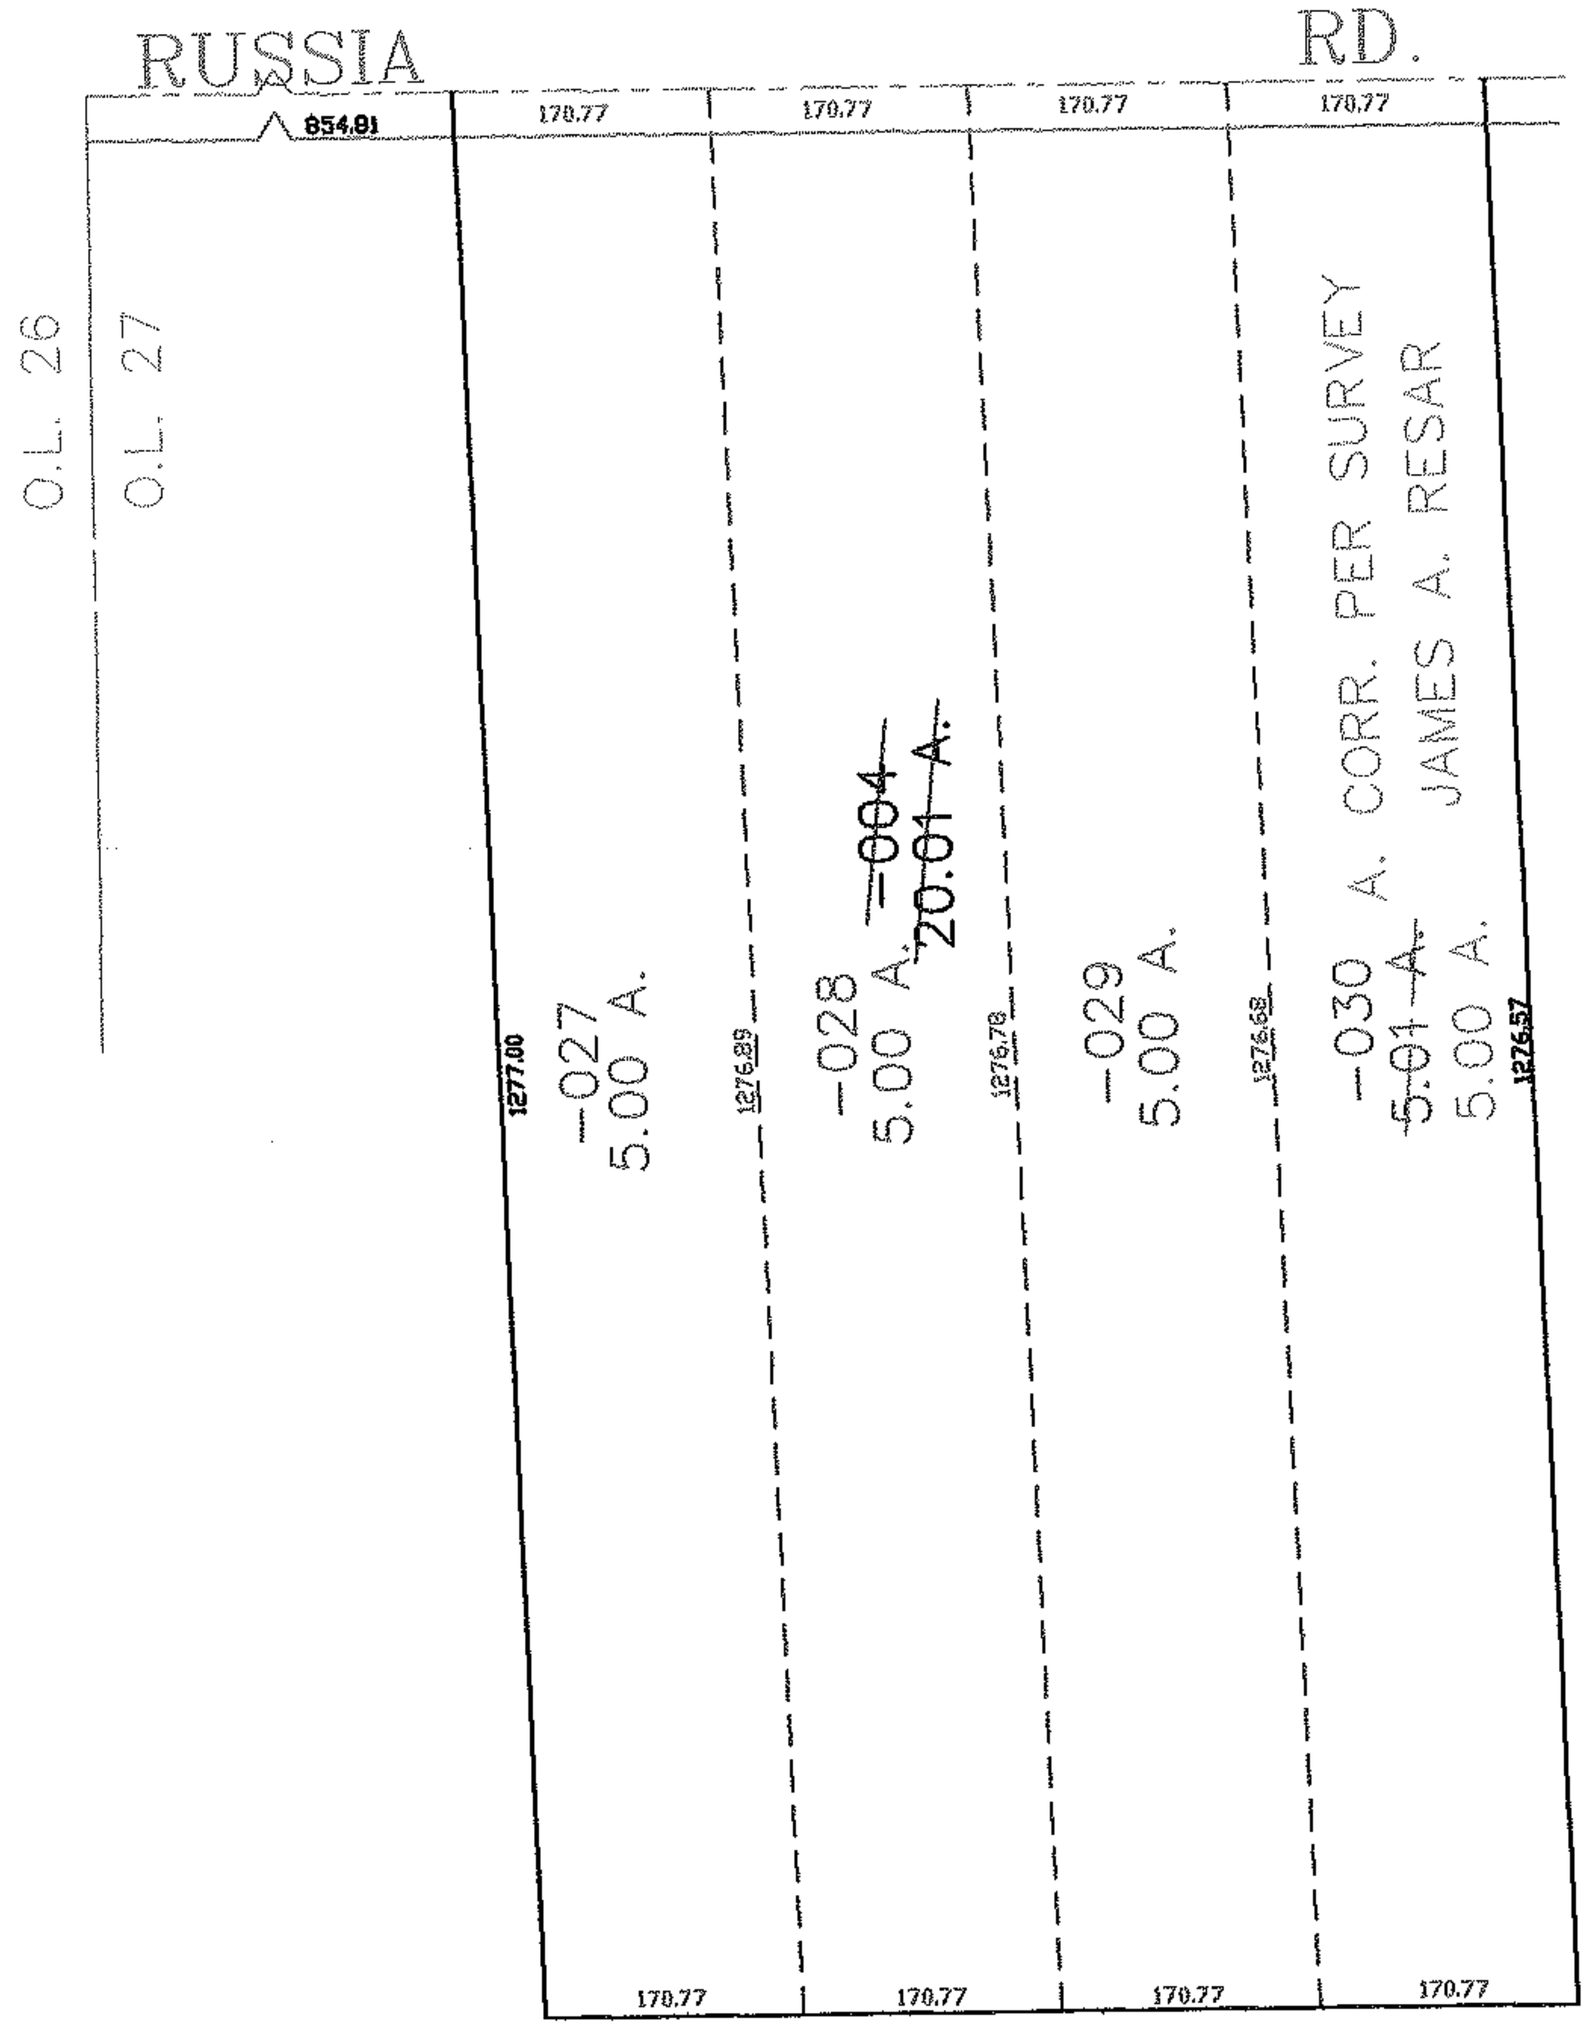

SPLITS/DEEDS PROCESSED

LORAIN COUNTY TAX MAP DEPARTMENT
226 MIDDLE AVE. ELYRIA, OHIO

SURVEYED BY: JAMES A. RESAR
CLOSURE: 0.00 : 10,000
MAP PAGE(S): XX-XX-XXX
APPROVED BY: 09-00-027 DATE: 1-12-05
SCALE: 1"= 200 PRIOR INSTRUMENT: 20040047134