RASTER

PARENT PARCEL: 15-00-046-106-008

CHILD PARCEL: --SAME--

STARTING POINT: INT CL DILL'S CT AND MAIN ST.

09-01842-C

MAP CORR. ONLY
FRONTAGE CORR.
PER DEED

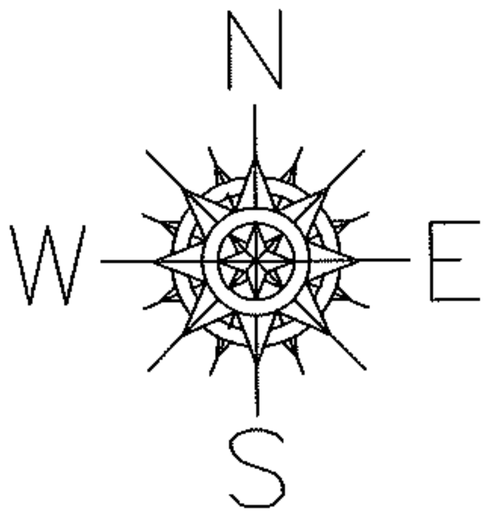

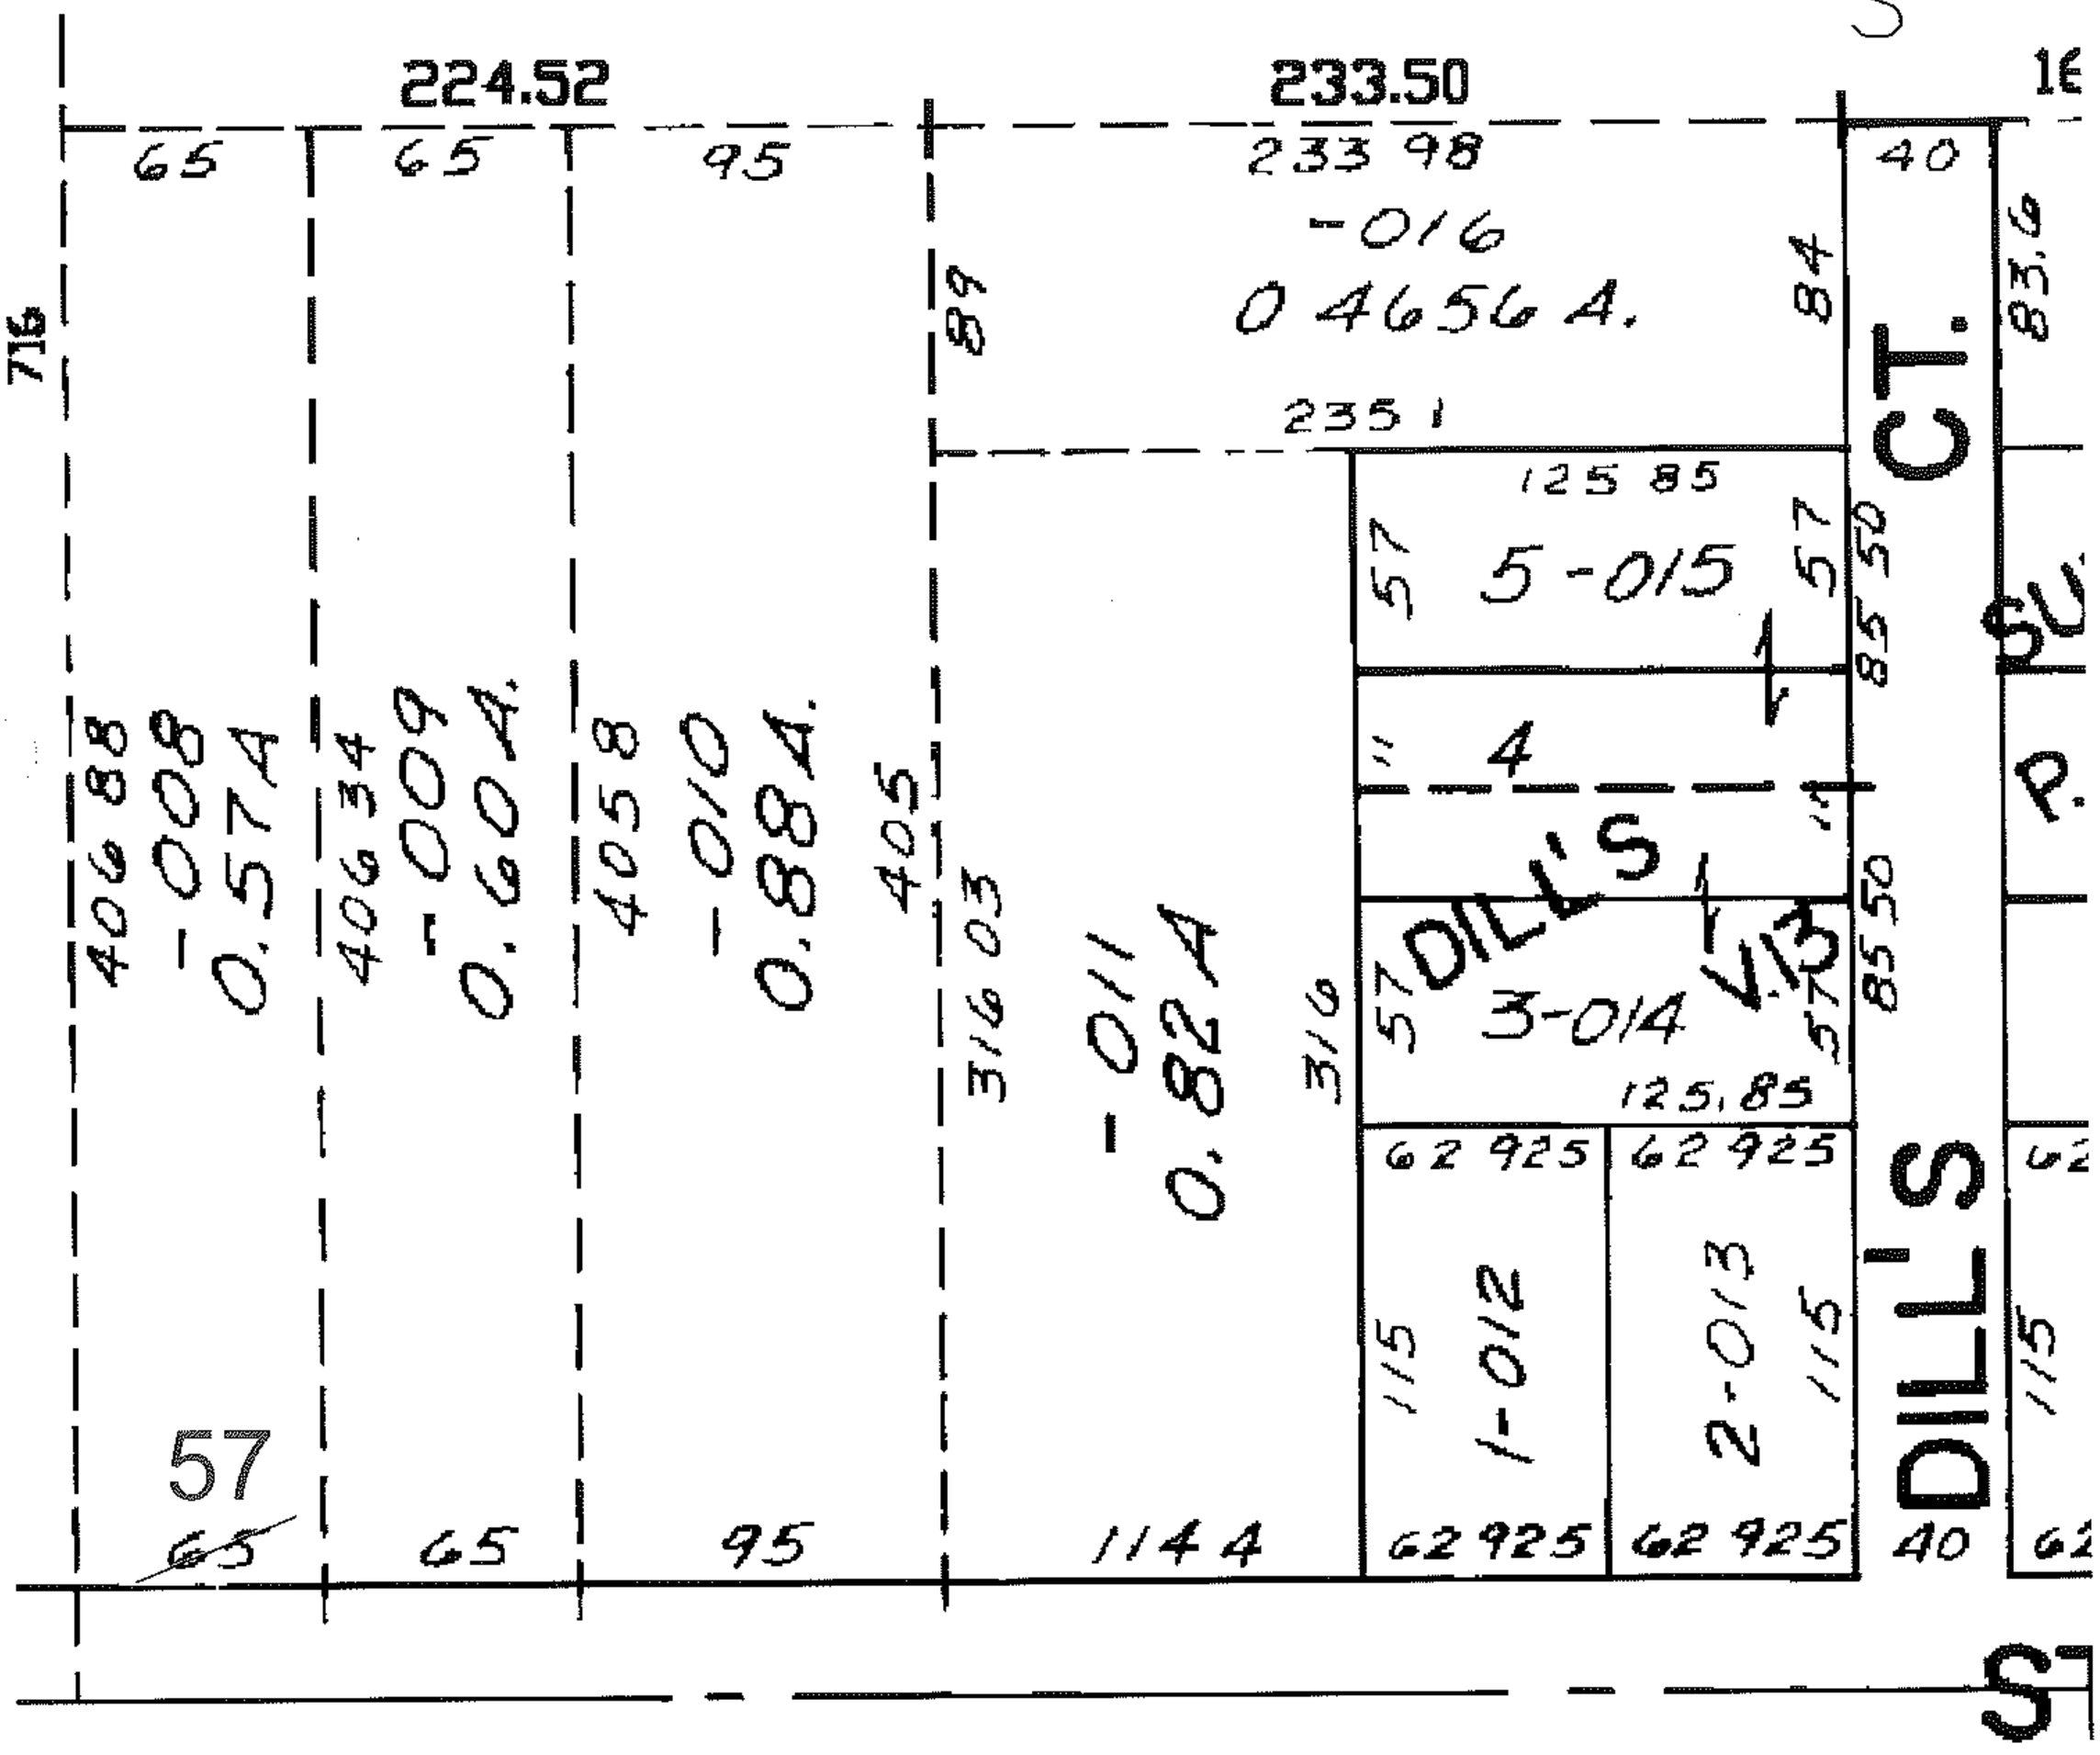

SPLITS/DEEDS PROCESSED

LORAIN COUNTY TAX MAP DEPARTMENT
226 MIDDLE AVE. ELYRIA, OHIO

SURVEYED BY: N/A

CLOSURE: N/A

MAP PAGE(S): 15-00-046-B

APPROVED BY: DRH DATE: 6/15/2009

SCALE: NOT TO SCALE PRIOR INST.: 20030967802