RASTER

PARENT PARCEL: ADD TO DUPLICATE

CHILD PARCEL: 07-00-045-108-020 & -027

STARTING POINT: INT DYKE AVE AND WATSON AVE

09-01850-X

ADD TO DUP
PER VACATION ORD 2881-94

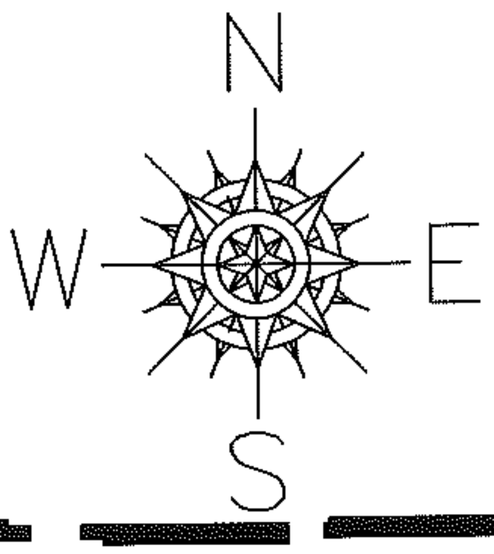

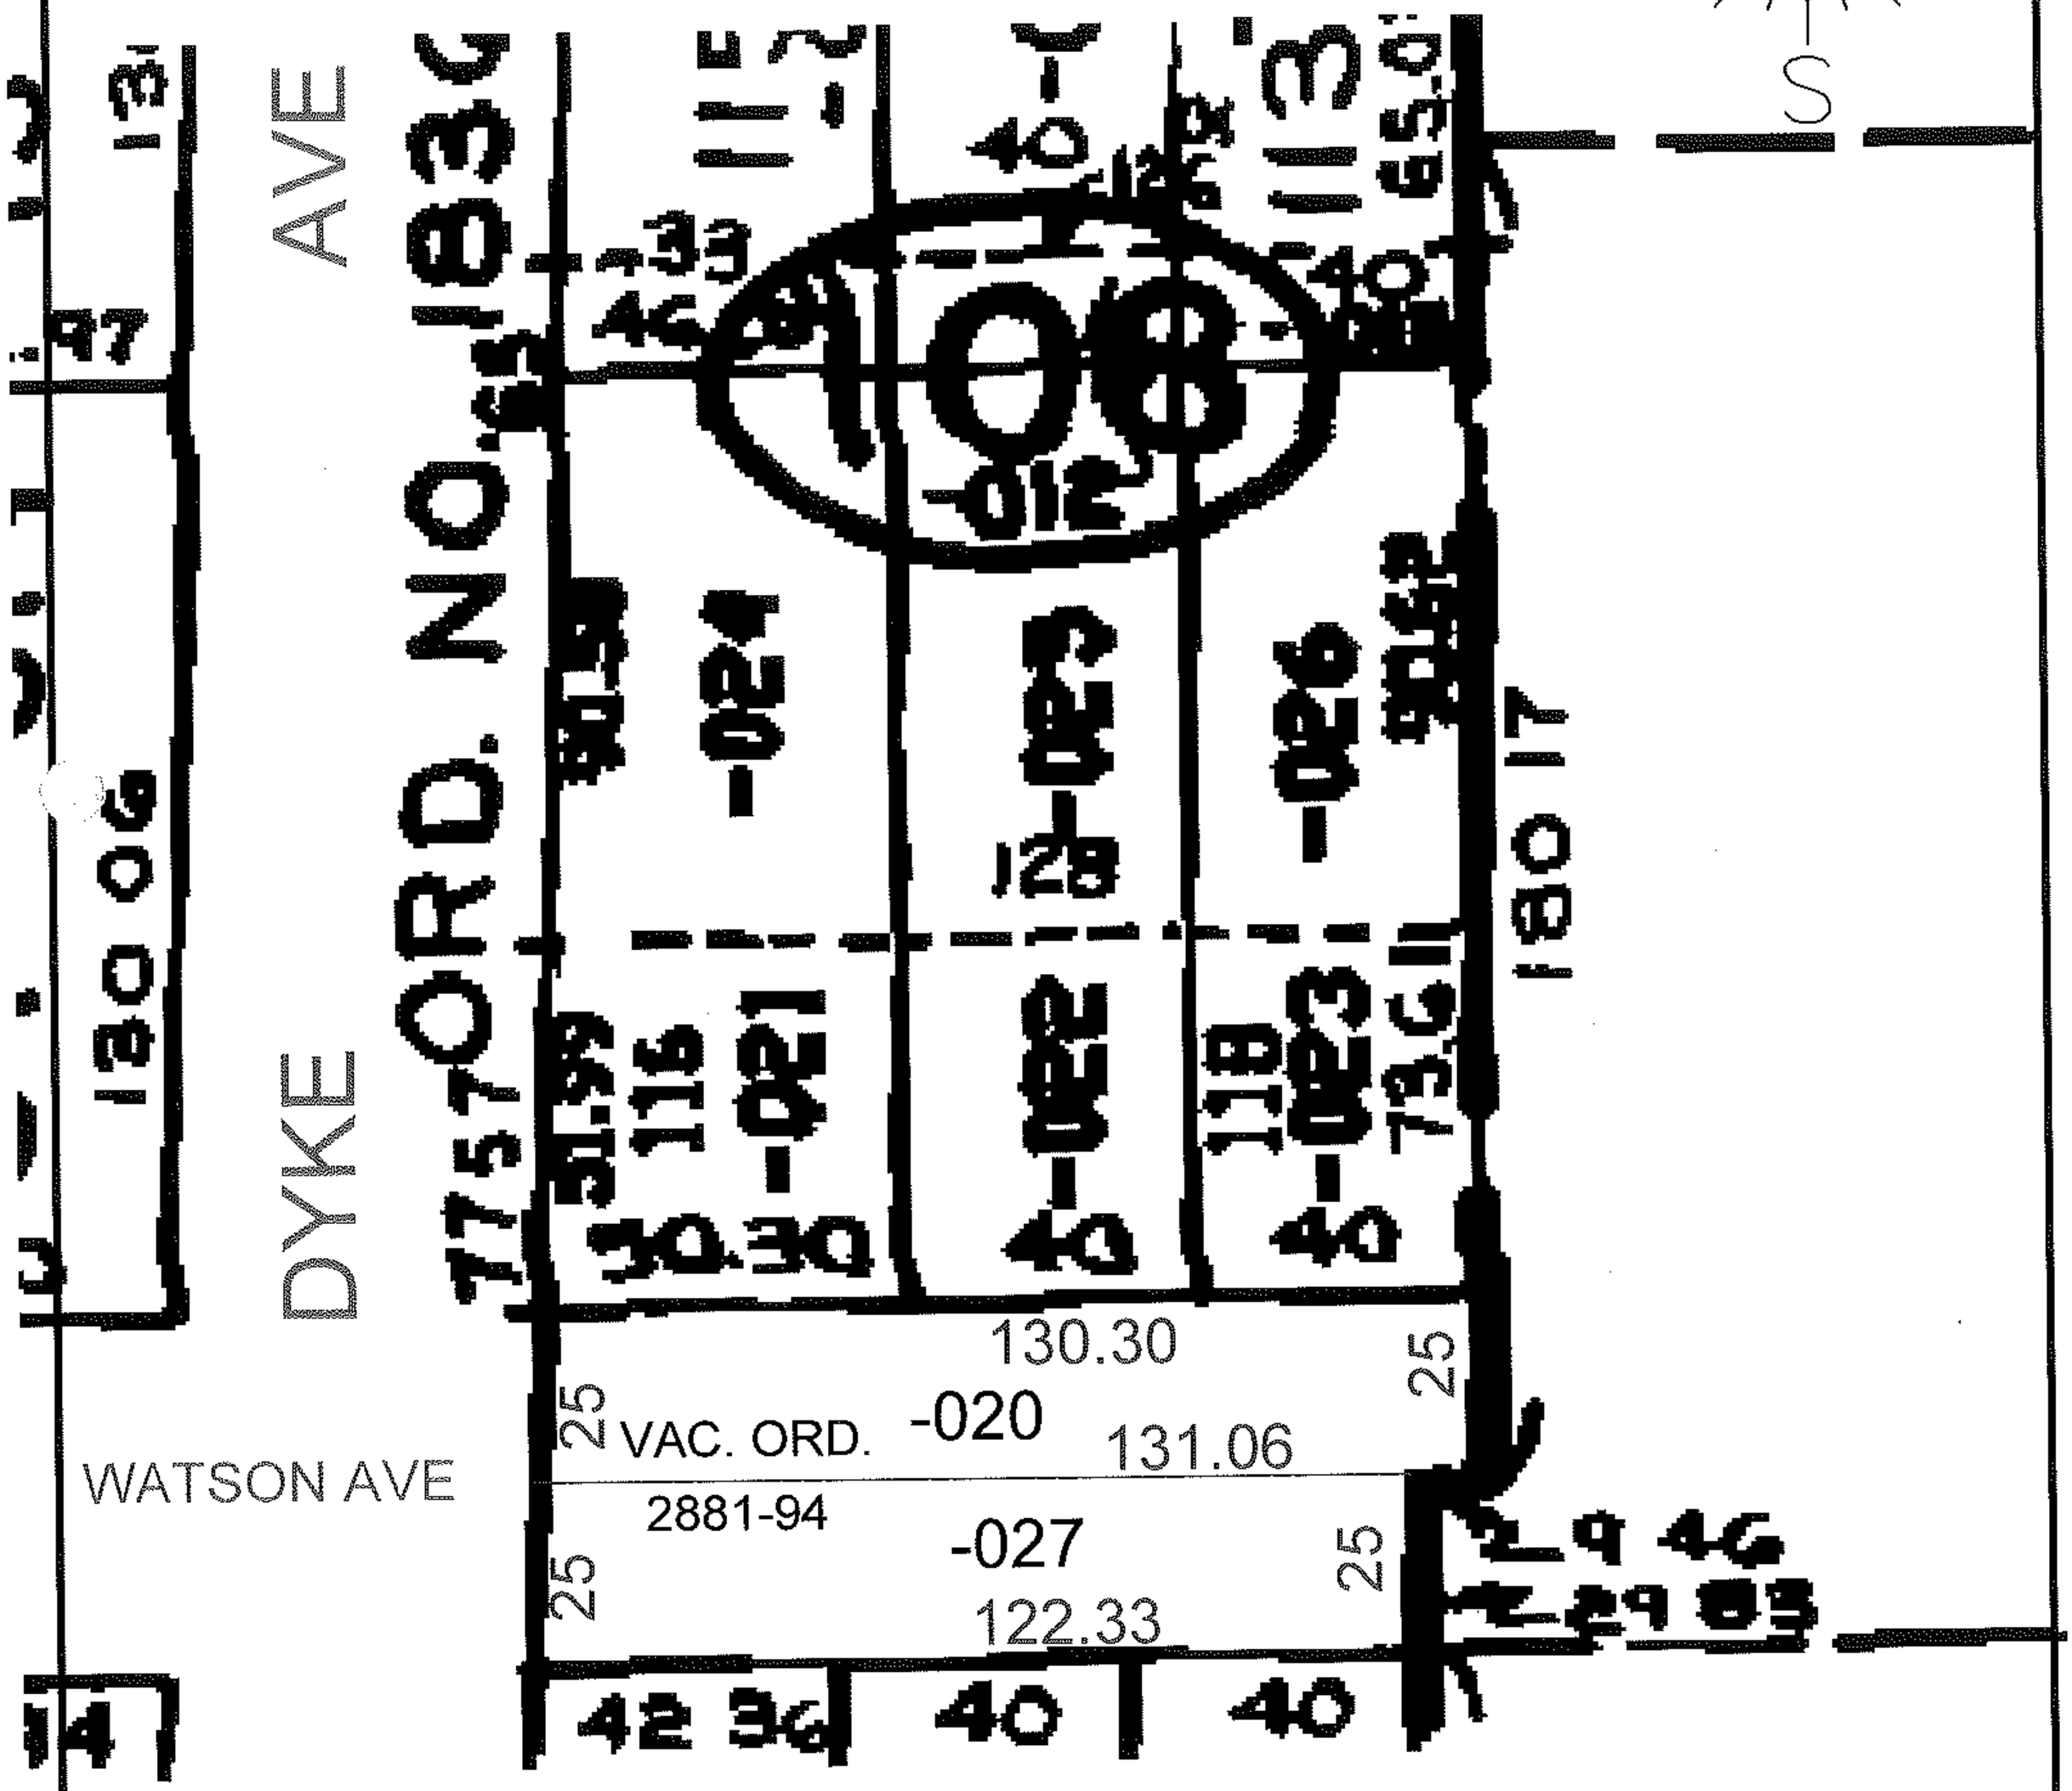

SPLITS/DEEDS PROCESSED

LORAIN COUNTY TAX MAP DEPARTMENT
226 MIDDLE AVE. ELYRIA, OHIO

SURVEYED BY: N/A

CLOSURE: N/A

MAP PAGE(S): 07-00-045-C

APPROVED BY: DRH DATE: 6/25/2009

SCALE: NOT TO SCALE PRIOR INST.: VAC ORD 2881-94