

RASTER

PARENT PARCEL: 21-12-000-000-019

CHILD PARCEL: 21-12-000-000-102, -103


STARTING POINT: CENTERLINE OF HAWLEY RD. & BURSLEY RD.

NO. 01857

BURSLEY RD.

HAWLEY RD.

HAWLEY

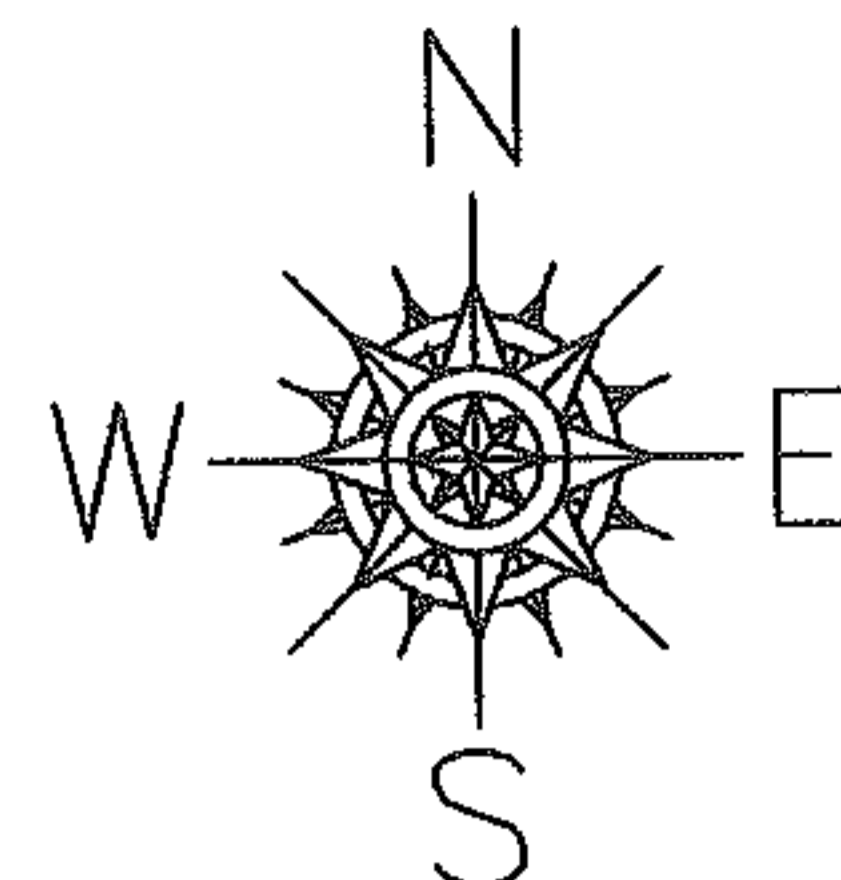

1852.23

910.68

350.02

485.95

677.33

368.30

297.17

-102
12.93 A.

1153.22

~~-019~~
~~26.55 A.~~

-103
~~13.62 A.~~
12.87 A.

A. CORR. PER SURVEY
JAMES D. WELLERT


831.26

482.96

681.59

472.23

190.01

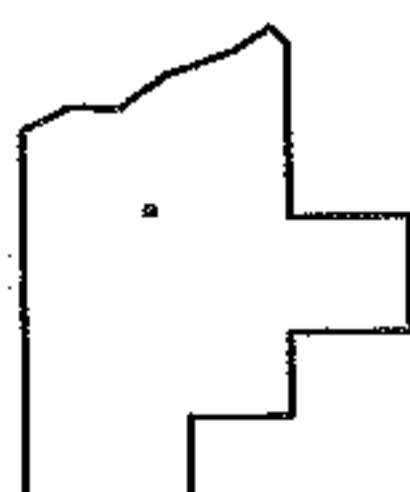

SPLITS/DEEDS PROCESSED

LORAIN COUNTY TAX MAP DEPARTMENT
226 MIDDLE AVE. ELYRIA, OHIO

SURVEYED BY: JAMES D. WELLERT

CLOSURE: 0.00 : 10.000

MAP PAGE(S): 21-D

APPROVED BY: JAH DATE: 2-15-05

SCALE: 1" = 200 PRIOR INSTRUMENT: OR 1415/506