RASTER

PARENT PARCEL: 07-00-037-000-107

CHILD PARCEL: 07-00-037-000-108 THRU -111

STARTING POINT: CENTERLINE OF BENDER RD. & CHESTNUT RIDGE RD.

NO. 01863

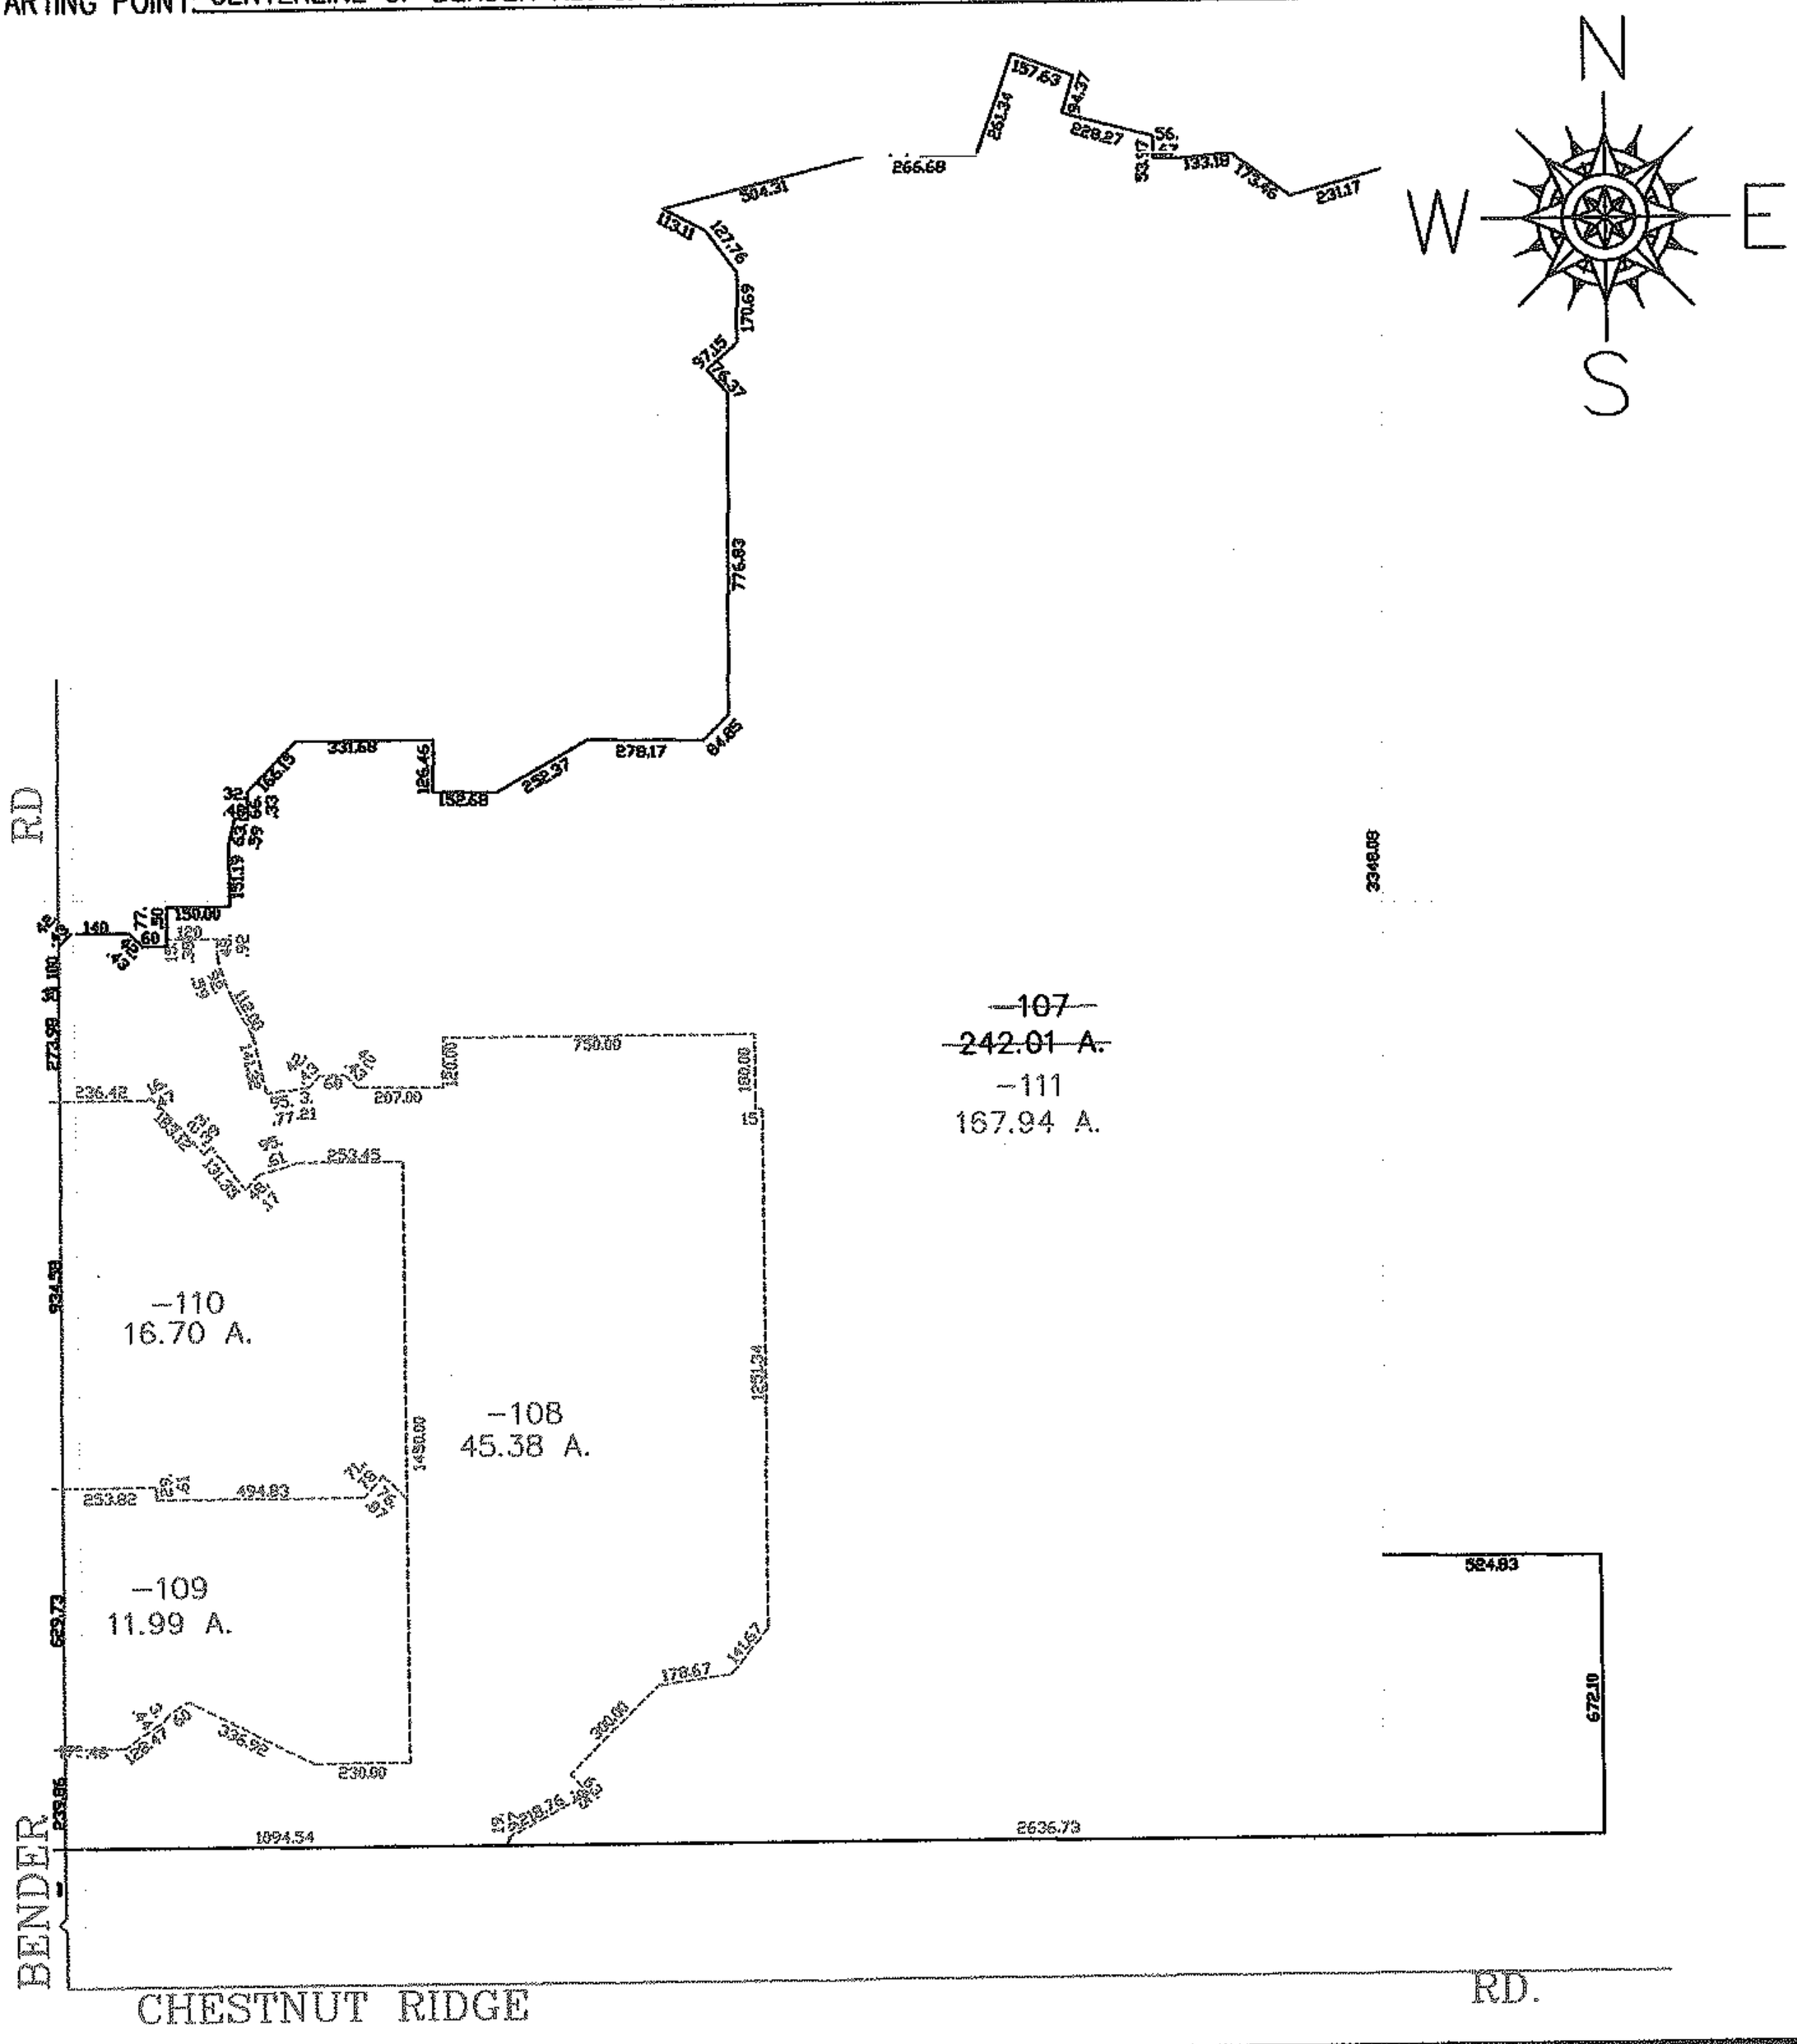

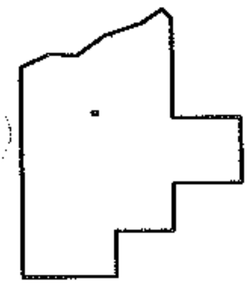

SPLITS/DEEDS PROCESSED

LORAIN COUNTY TAX MAP DEPARTMENT
226 MIDDLE AVE. ELYRIA, OHIO

SURVEYED BY: KENNETH L. BOHNING

CLOSURE: 0.00 : 10,000

MAP PAGE(S): 07-00-037-C

APPROVED BY: JAH DATE: 2-23-05

SCALE: 1"= 600 PRIOR INSTRUMENT: PL VL 77/7