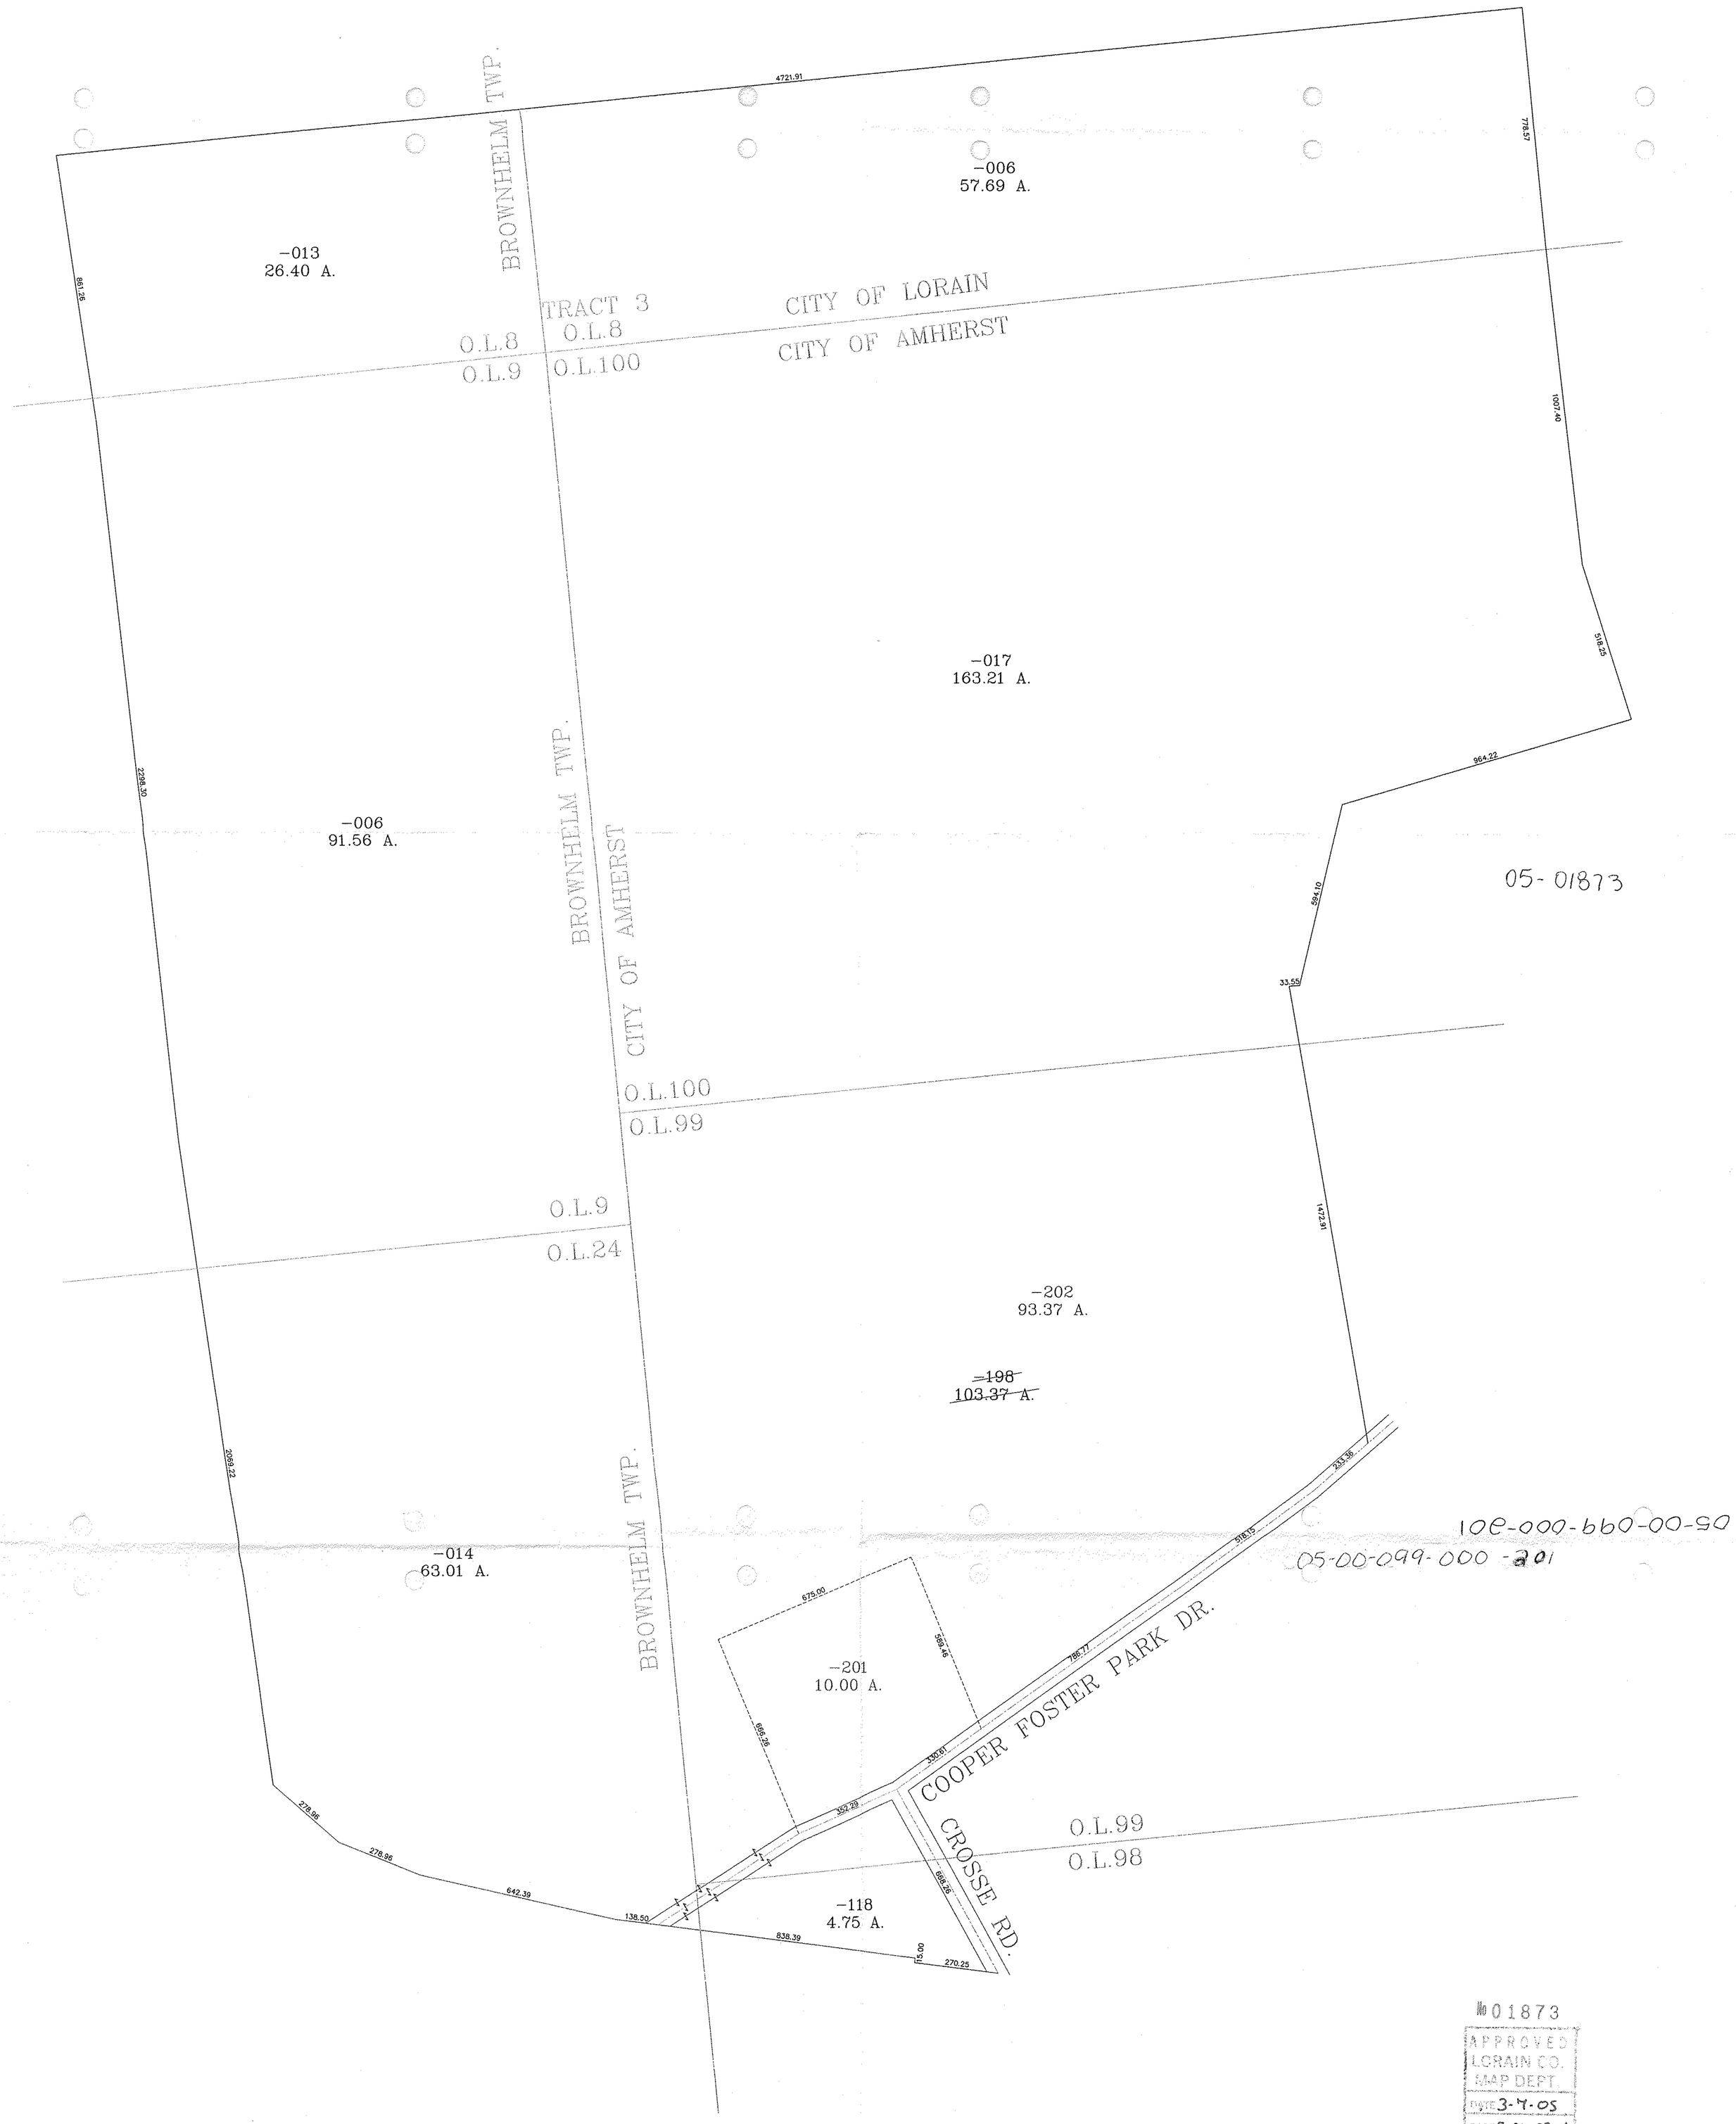
BROWNHELM TWP.
-006
57.69 A.
-013
26.40 A.
TRACT 3
O.L.8
O.L.8
O.L.9
O.L.100
CITY OF LORAIN
CITY OF AMHERST
-017
163.21 A.
-006
91.56 A.
BROWNHELM TWP.
CITY OF AMHERST
O.L.100
O.L.99
O.L.9
O.L.24
-202
93.37 A.
~~-198~~
~~103.37 A.~~
05-01873
-014
63.01 A.
BROWNHELM TWP.
-201
10.00 A.
COOPER FOSTER PARK DR.
CROSSE RD.
O.L.99
O.L.98
-118
4.75 A.
10E-000-660-00-50
05-00-099-000-201
861.26
4721.91
778.57
1007.40
518.25
964.22
594.10
33.55
1,472.91
2298.30
2069.22
675.00
589.45
666.26
330.61
786.77
518.15
233.36
352.29
278.96
278.96
642.39
138.50
838.39
15.00
270.25
666.26
SCALE
1" = 250"
№ 01873
APPROVED
LORAIN CO.
MAP DEPT.
DATE 3-7-05
PARCEL S-00099-A
BY R. MAINES
05-01873