RASTER

PARENT PARCEL: 05-00-046-000-012, -021 05-00-047-000-002, -009, -021
CHILD PARCEL: 05-00-047-000-024 THRU -028 05-00-046-000-036 THRU -038
STARTING POINT: CENTERLINE OF OBERLIN NORTH RD. & O.L. 46

NO. 01878

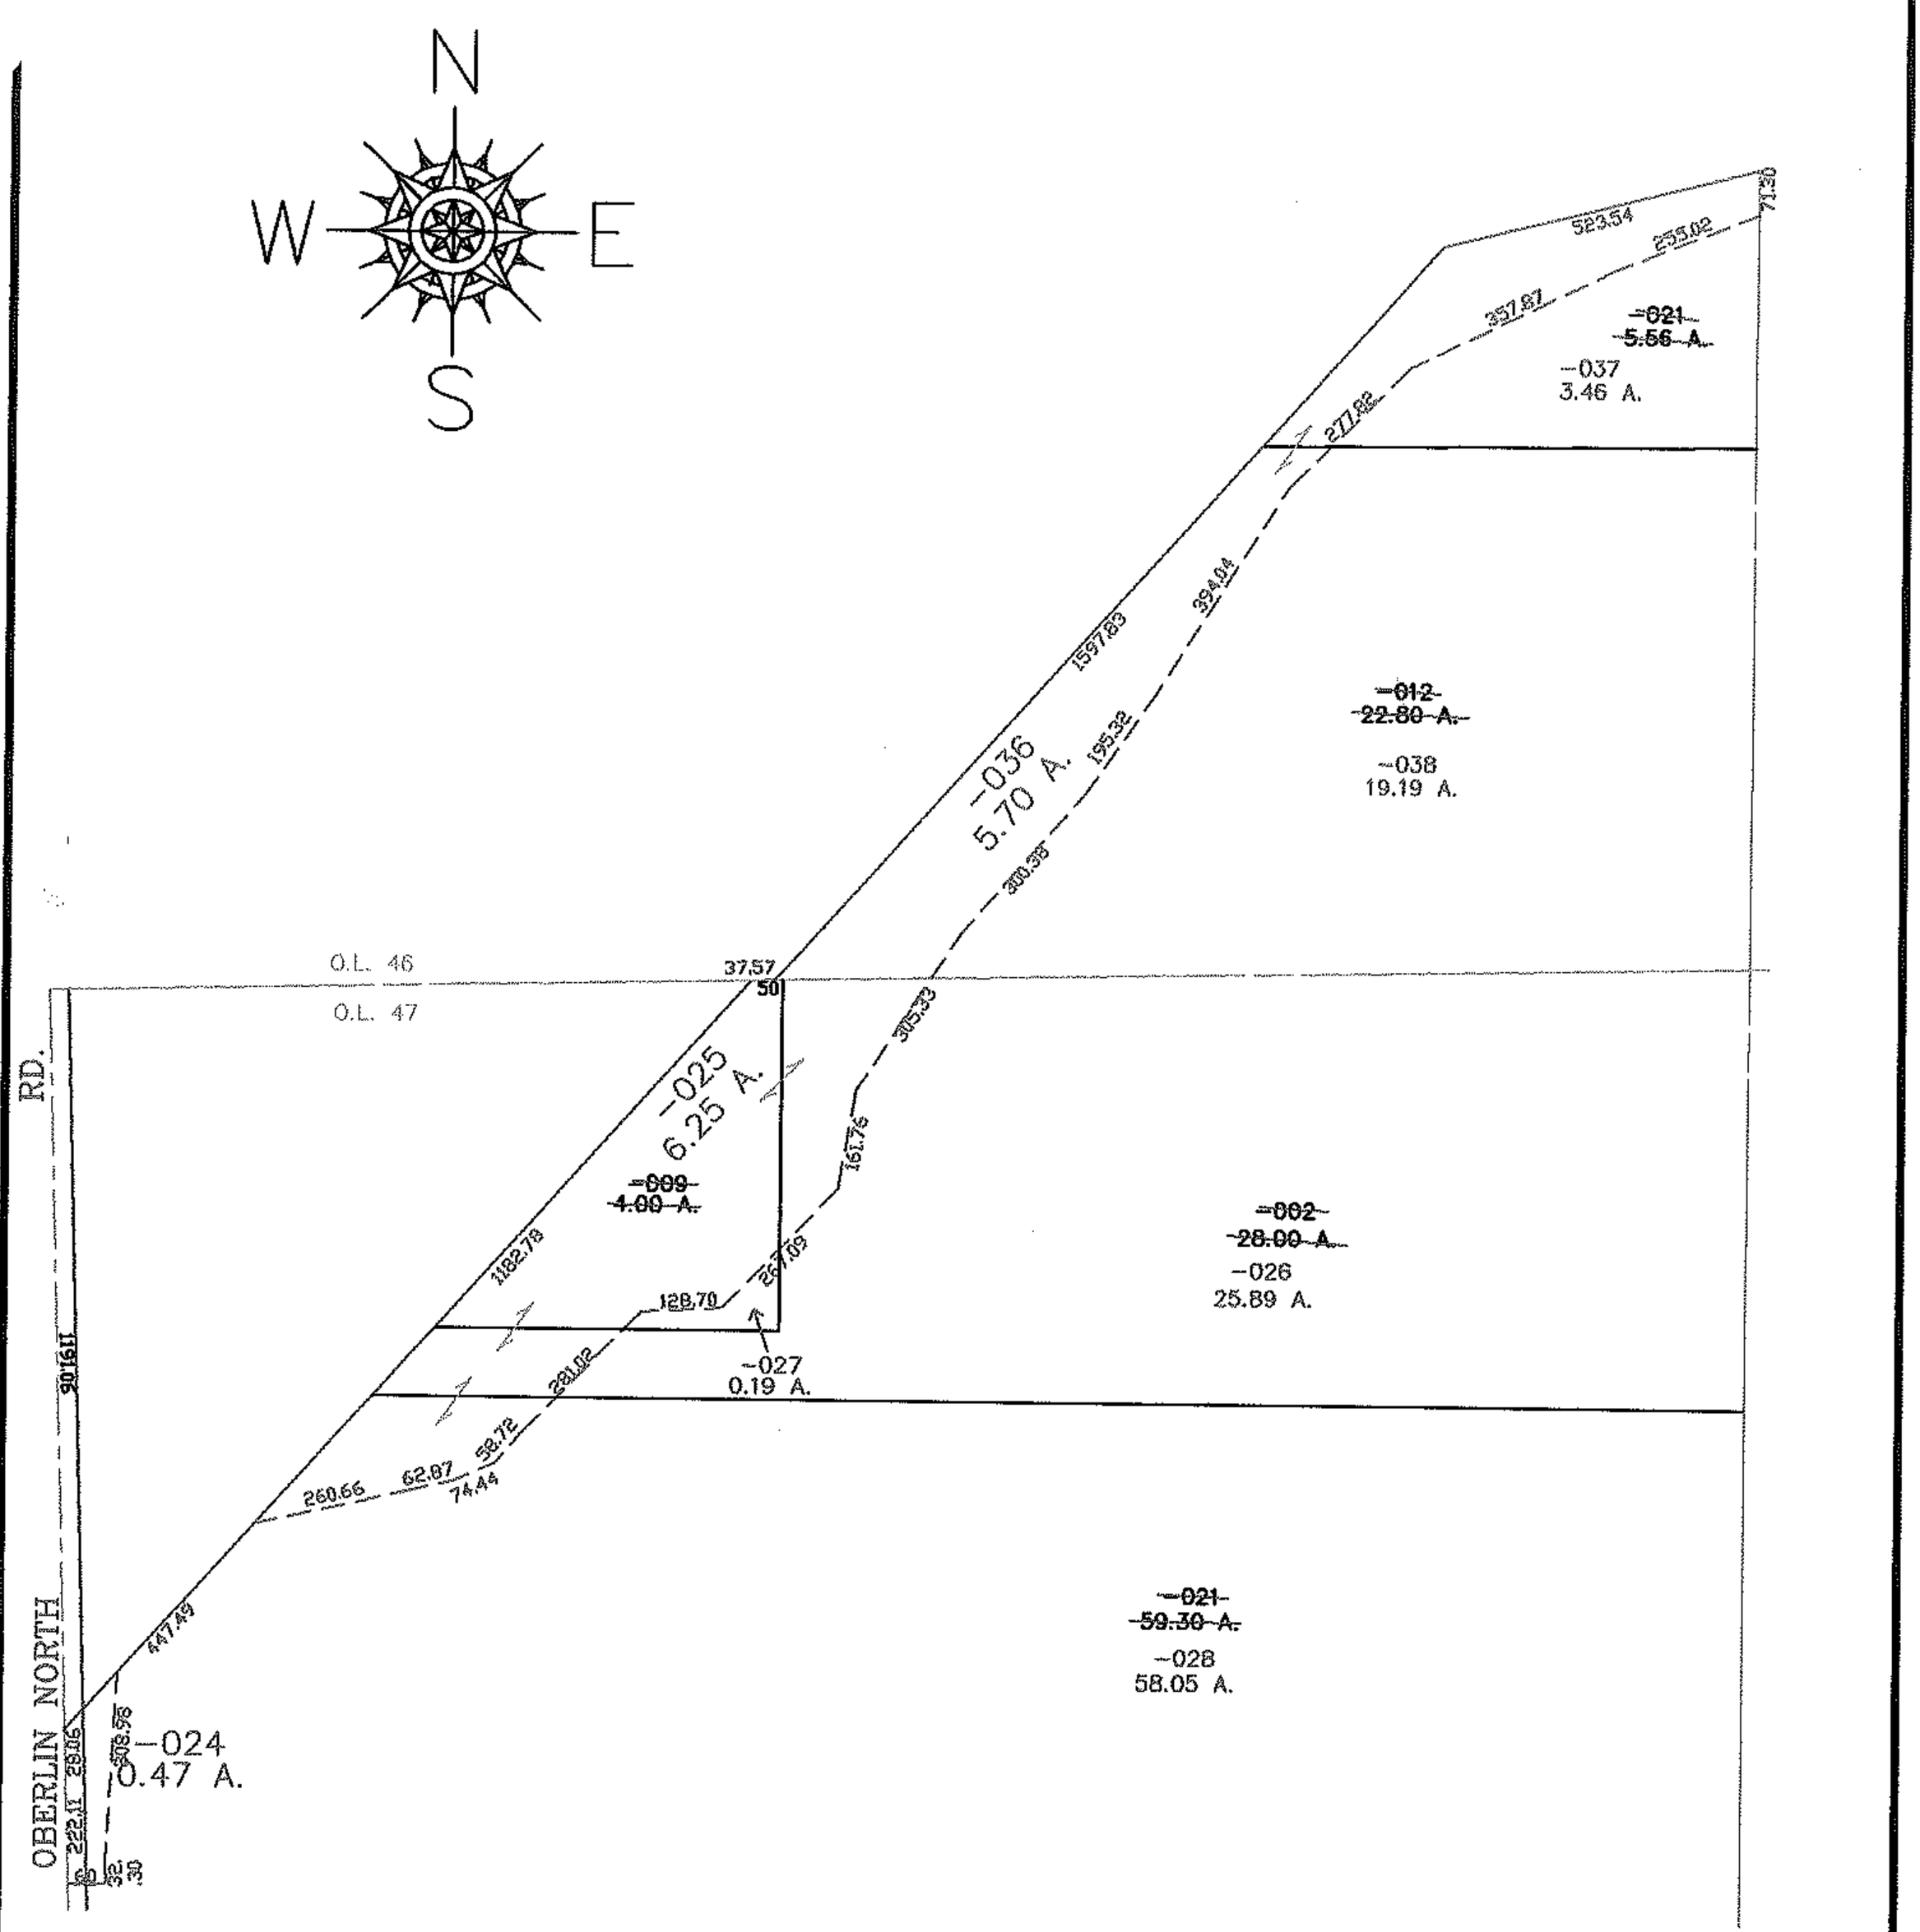

SPLITS/DEEDS PROCESSED
LORAIN COUNTY TAX MAP DEPARTMENT
226 MIDDLE AVE. ELYRIA, OHIO

SURVEYED BY: JOSEPH WILIN
CLOSURE: 0.00 : 10.000
MAP PAGE(S): 5-G
APPROVED BY: JAH DATE: 3-14-05
SCALE: 1"= 400 PRIOR INSTRUMENT: DV 1256/678