RASTER

PARENT PARCEL: 03-00-040-113-001 THRU -004

CHILD PARCEL: 03-00-040-113-071, -072

STARTING POINT: SIDELINE OF GRANTWOOD AVE & RICHELIEU AVE

NO. 01880

N

W E

S

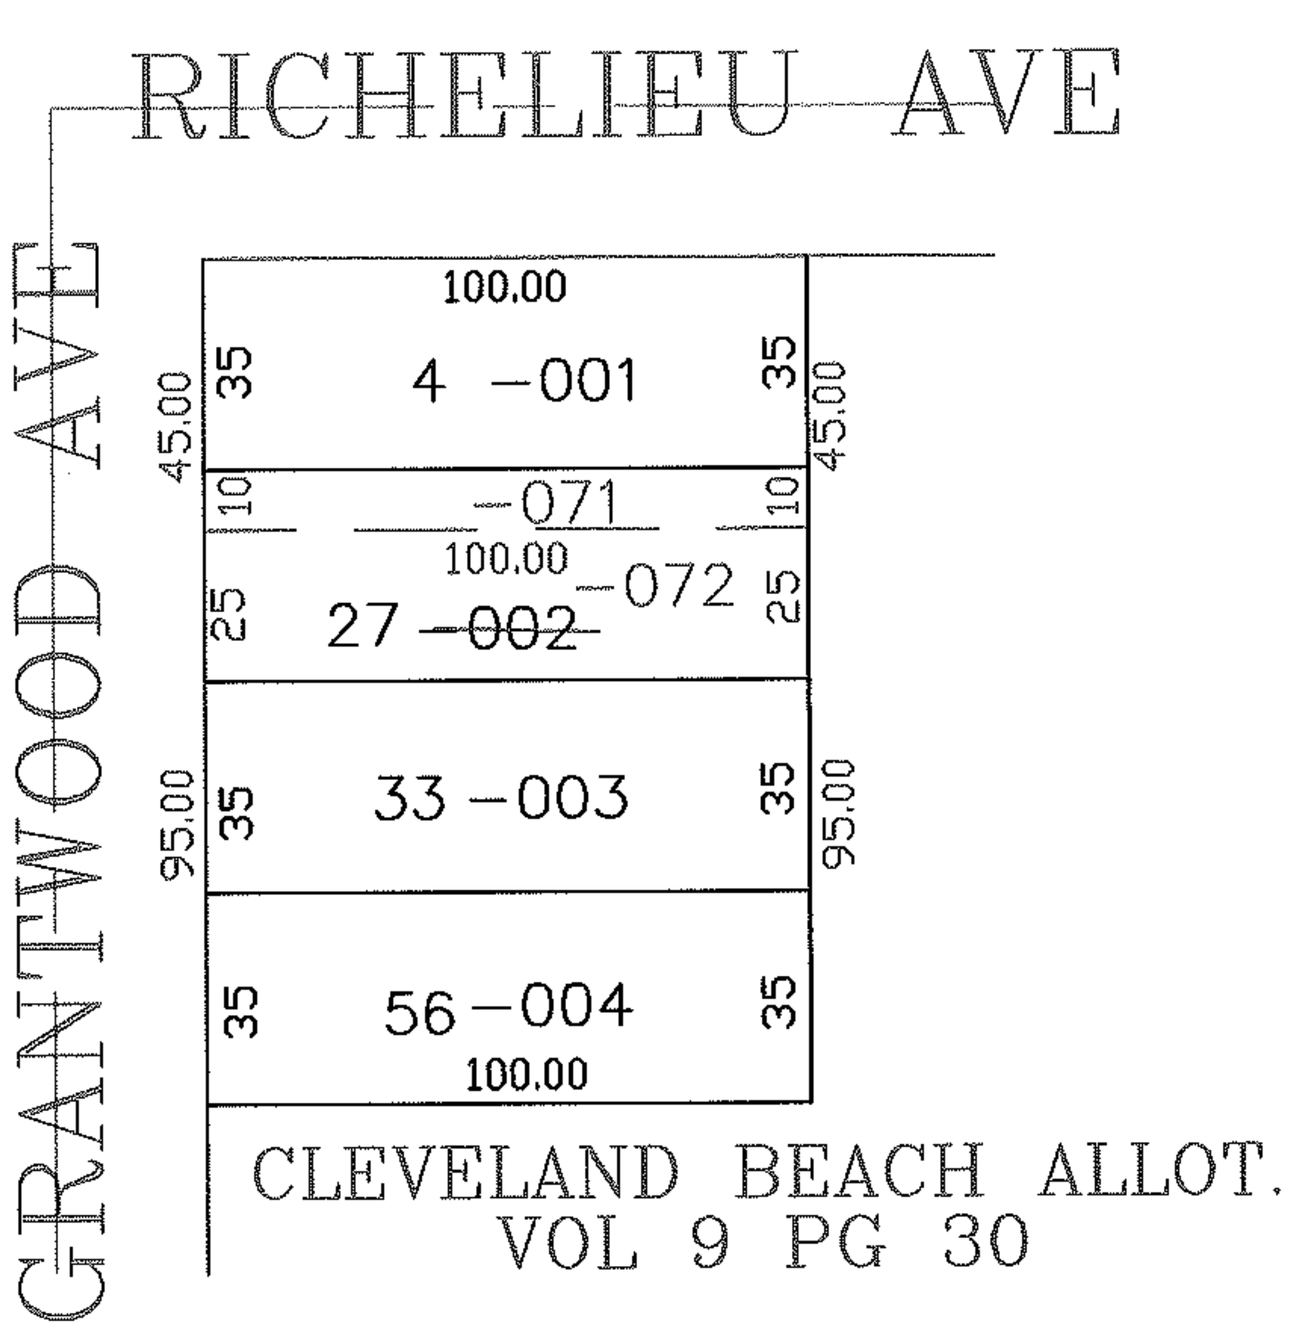

SPLITS/DEEDS PROCESSED

LORAIN COUNTY TAX MAP DEPARTMENT
226 MIDDLE AVE. ELYRIA, OHIO

SURVEYED BY: JAMES RESAR

CLOSURE: 0.00 : 10,000

MAP PAGE(S): 03-00-040

APPROVED BY: JAH DATE: 3-15-05

SCALE: 1"= 100 PRIOR INSTRUMENT: PL VOL 9/30