RASTER

PARENT PARCEL: 14-00-146-000-013,-014

CHILD PARCEL: 14-00-146-000-016 THRU -022, 14-00-145-000-011 THRU -013

STARTING POINT: CENTERLINE OF MERRIAM RD. & ASHLAND-OBERLIN RD.

NO. 01882

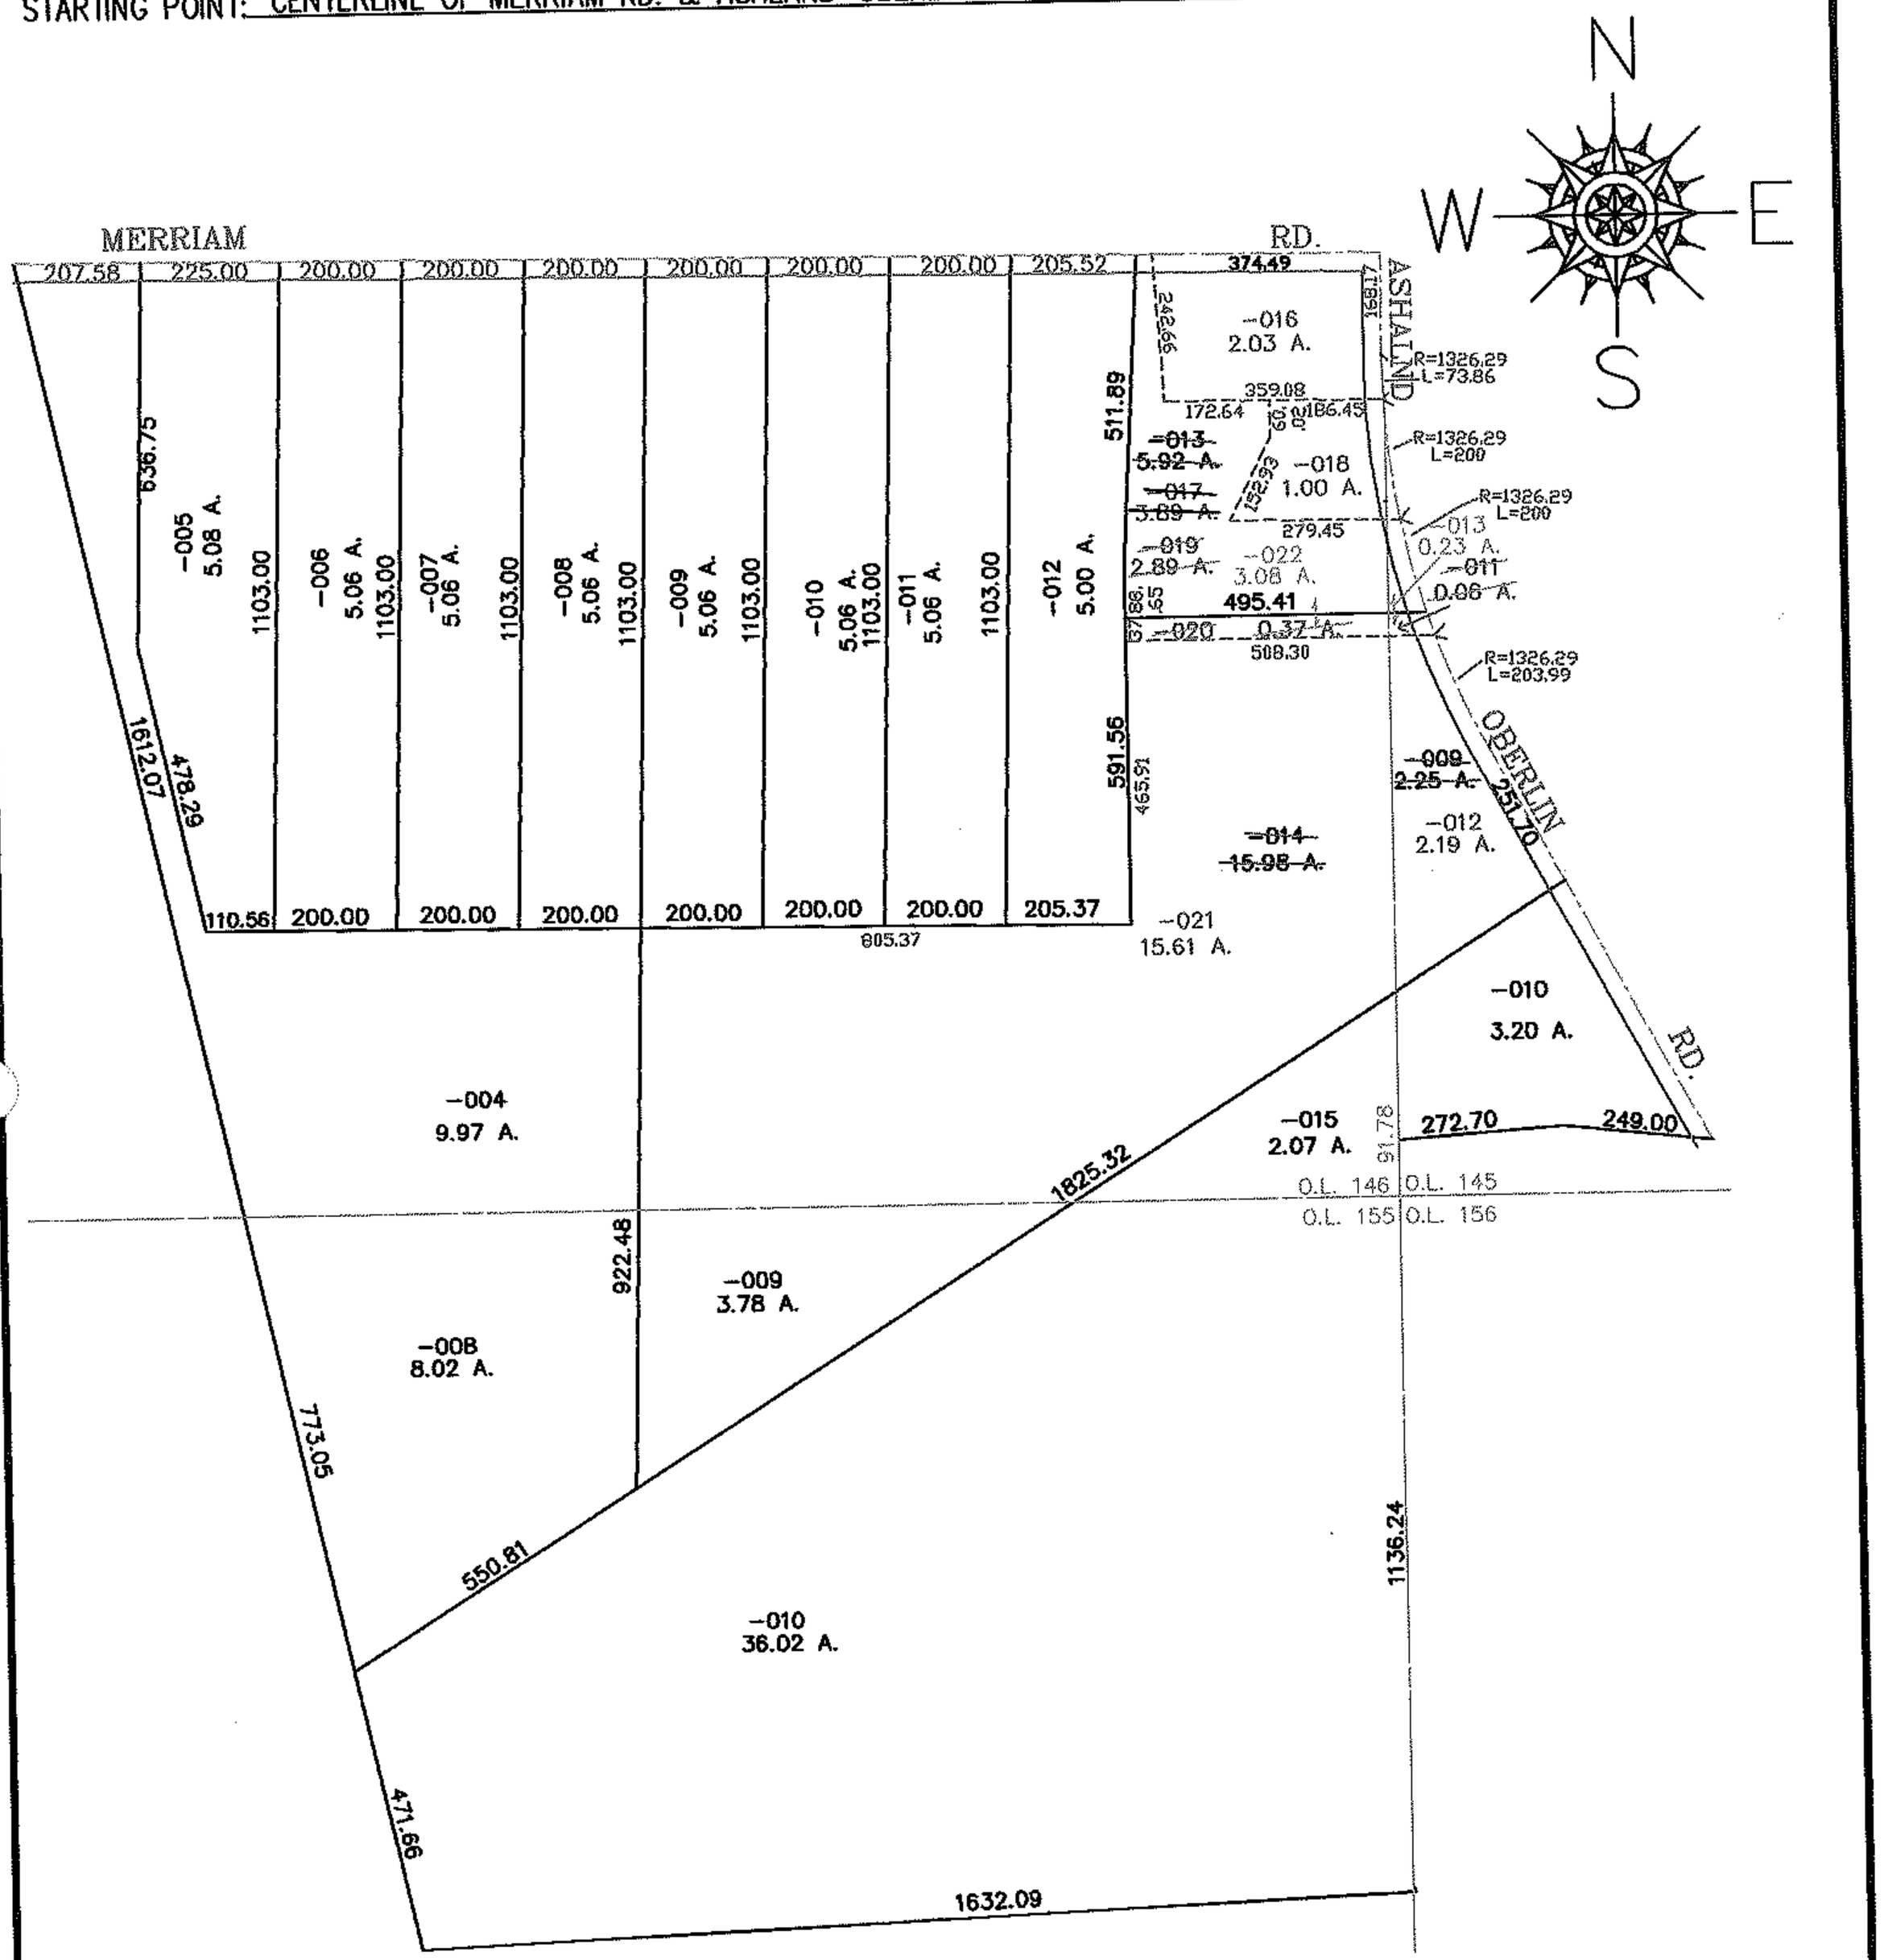

SPLITS/DEEDS PROCESSED

LORAIN COUNTY TAX MAP DEPARTMENT
226 MIDDLE AVE. ELYRIA, OHIO

SURVEYED BY: THOMAS M SNEZEK

CLOSURE: 0.00 : 10,000

MAP PAGE(S): 14-F

APPROVED BY: JAH DATE: 3-18-05

SCALE: 1"= 400 PRIOR INSTRUMENT: 20020855031