RASTER

PARENT PARCEL: 15-00-077-000-008,-009,-010

CHILD PARCEL: 15-00-077-000-017 THRU -025

STARTING POINT: INTERSECTION OF C/L OF WHITEHEAD RD. AND C/L OF WHITNEY RD.

NO. 01884

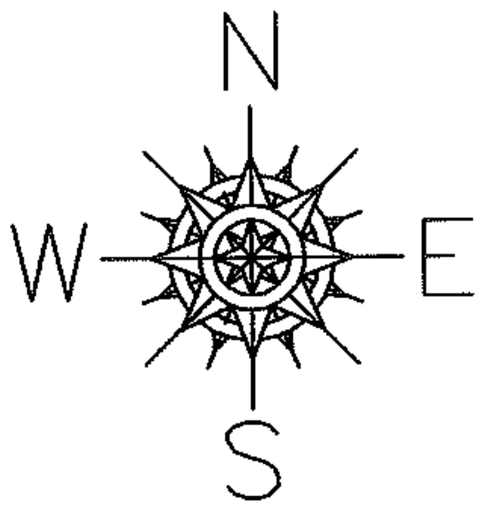

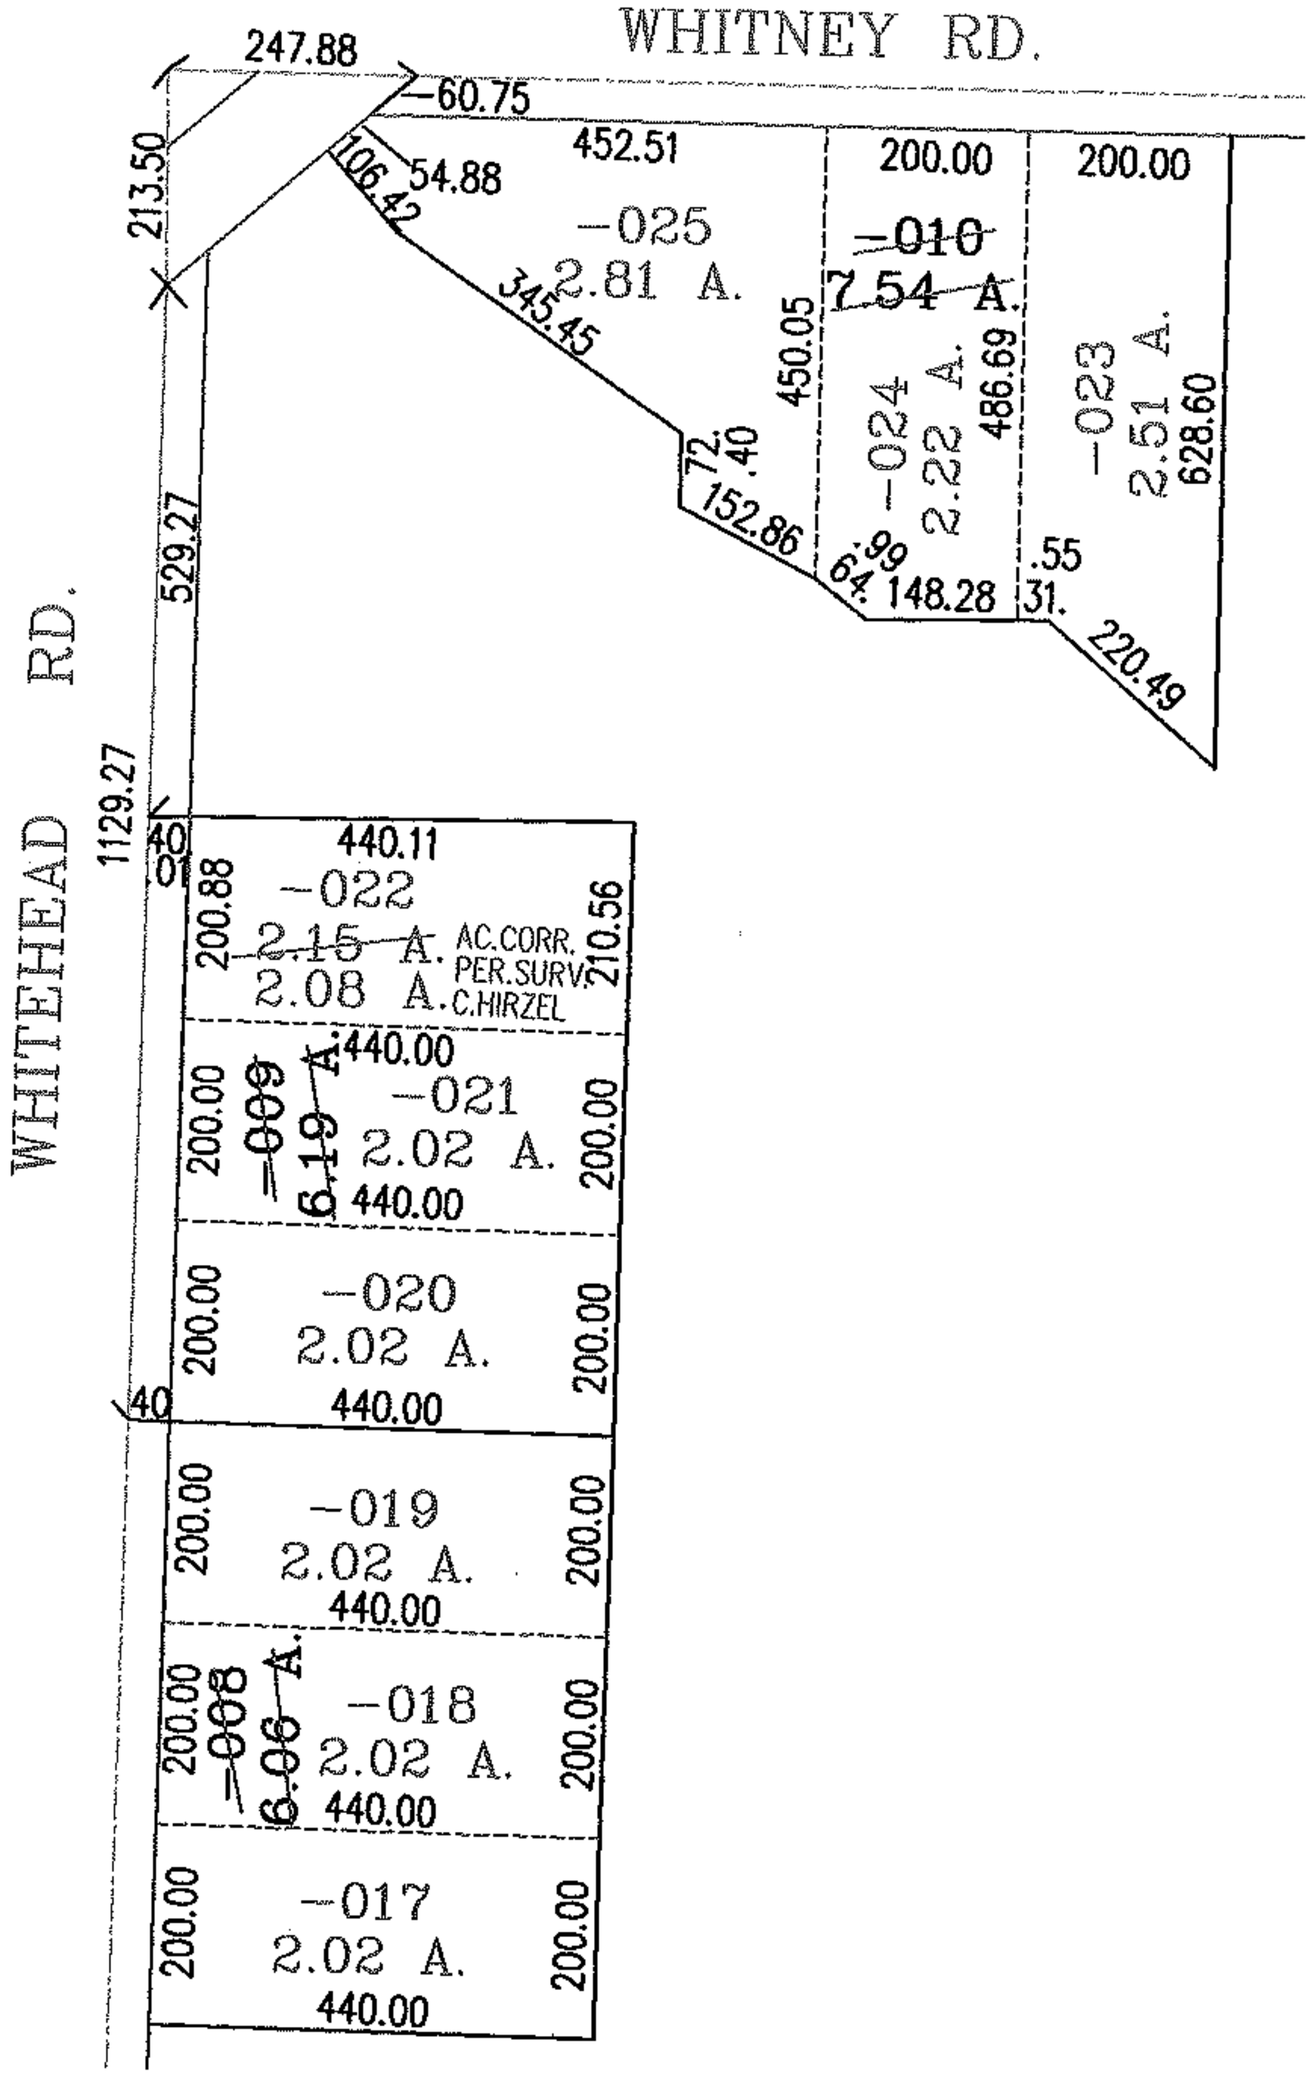

SPLITS/DEEDS PROCESSED

LORAIN COUNTY TAX MAP DEPARTMENT
226 MIDDLE AVE. ELYRIA, OHIO

SURVEYED BY: CHRISTOPHER HIRZEL

CLOSURE: .00:10.000

MAP PAGE(S): 15-00-077-A

APPROVED BY: RRM DATE: 3-22-05

SCALE: 1"= 300 PRIOR INSTRUMENT: 20050054031