RASTER

PARENT PARCEL: 05-00-098-000-116
CHILD PARCEL: 05-00-098-000-119, -120
STARTING POINT: CENTERLINE OF RED DELICIOUS LN. & WEST MARTIN AVE.

NO. 01911

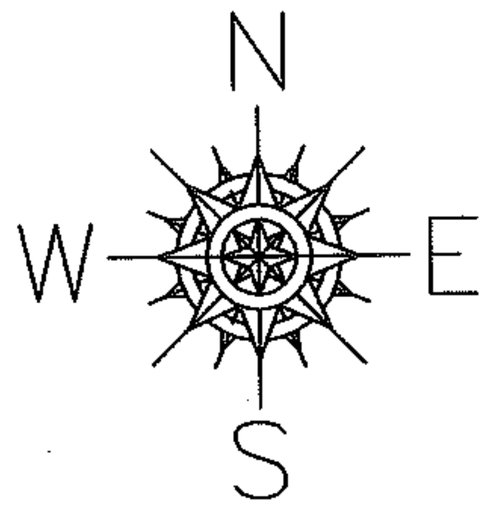

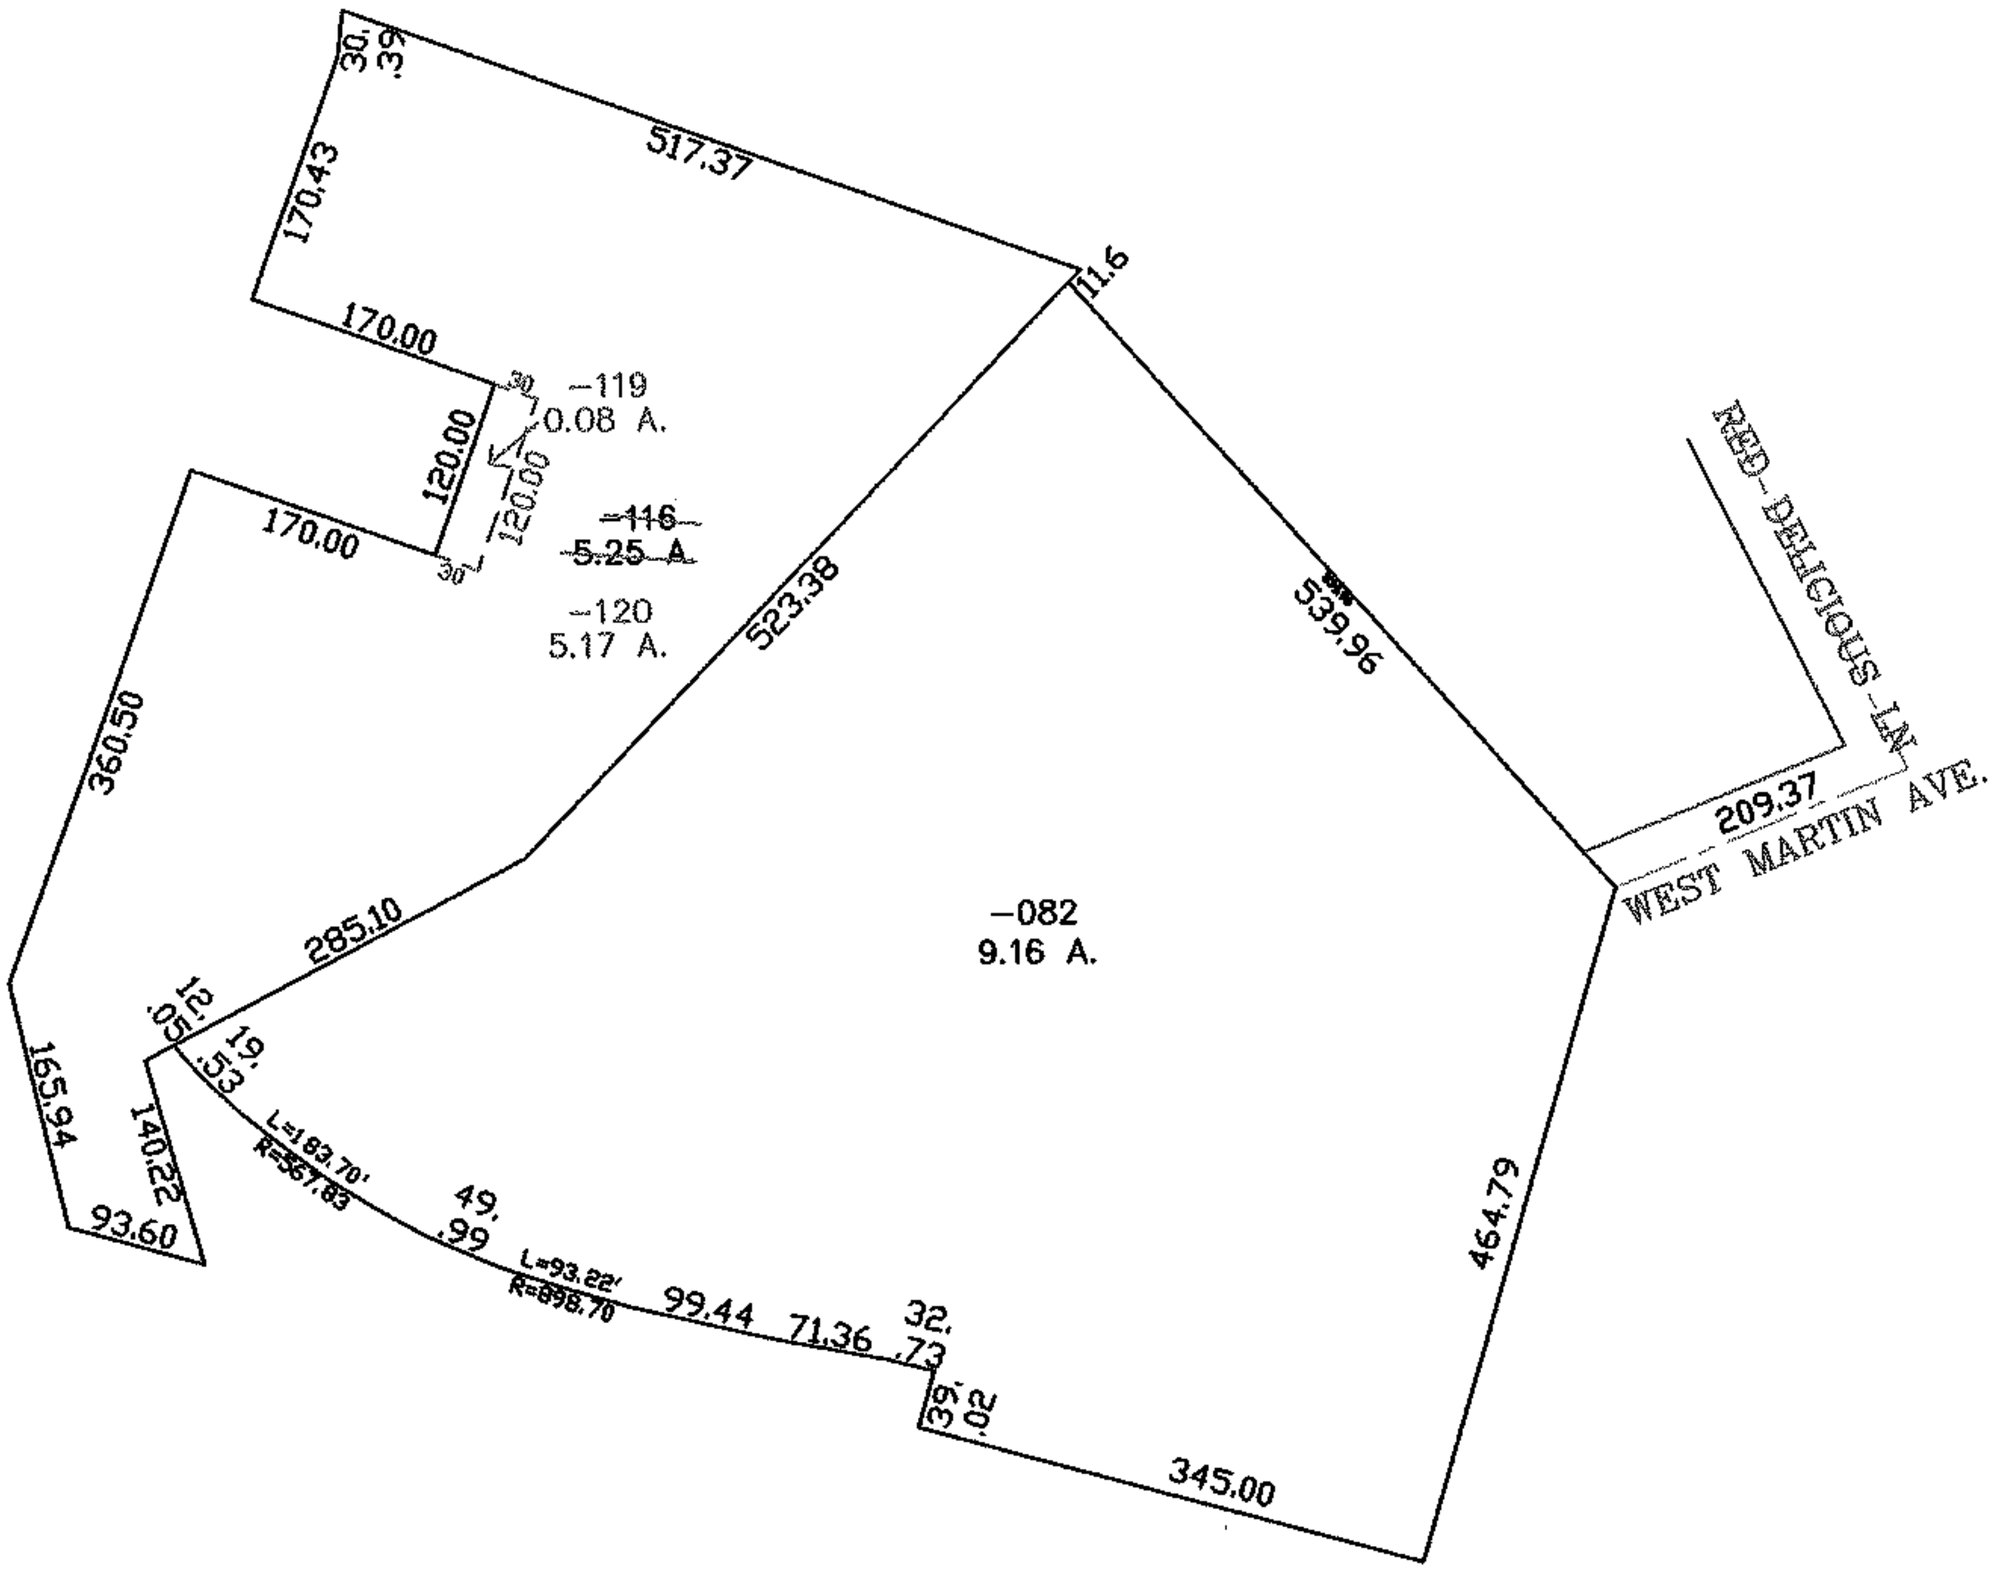

SPLITS/DEEDS PROCESSED
LORAIN COUNTY TAX MAP DEPARTMENT
226 MIDDLE AVE. ELYRIA, OHIO

SURVEYED BY: DAVE ELWELL
CLOSURE: 0.00 : 10,000
MAP PAGE(S): 05-00-098-C
APPROVED BY: JAH DATE: 5-10-05
SCALE: 1"= 200 PRIOR INSTRUMENT: 20040002781