EASTER

PARENT PARCEL: 05-00-024-105-020, -021

CHILD PARCEL: XX-XX-XXX-XXX-XXX

STARTING POINT: SIDELINE OF FOREST ST. & TENNEY ST.

NO. 01916

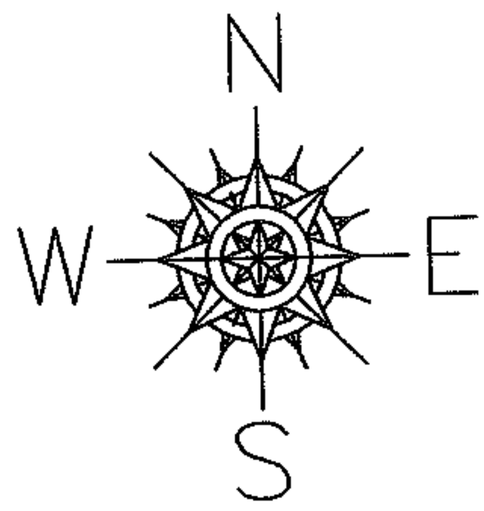

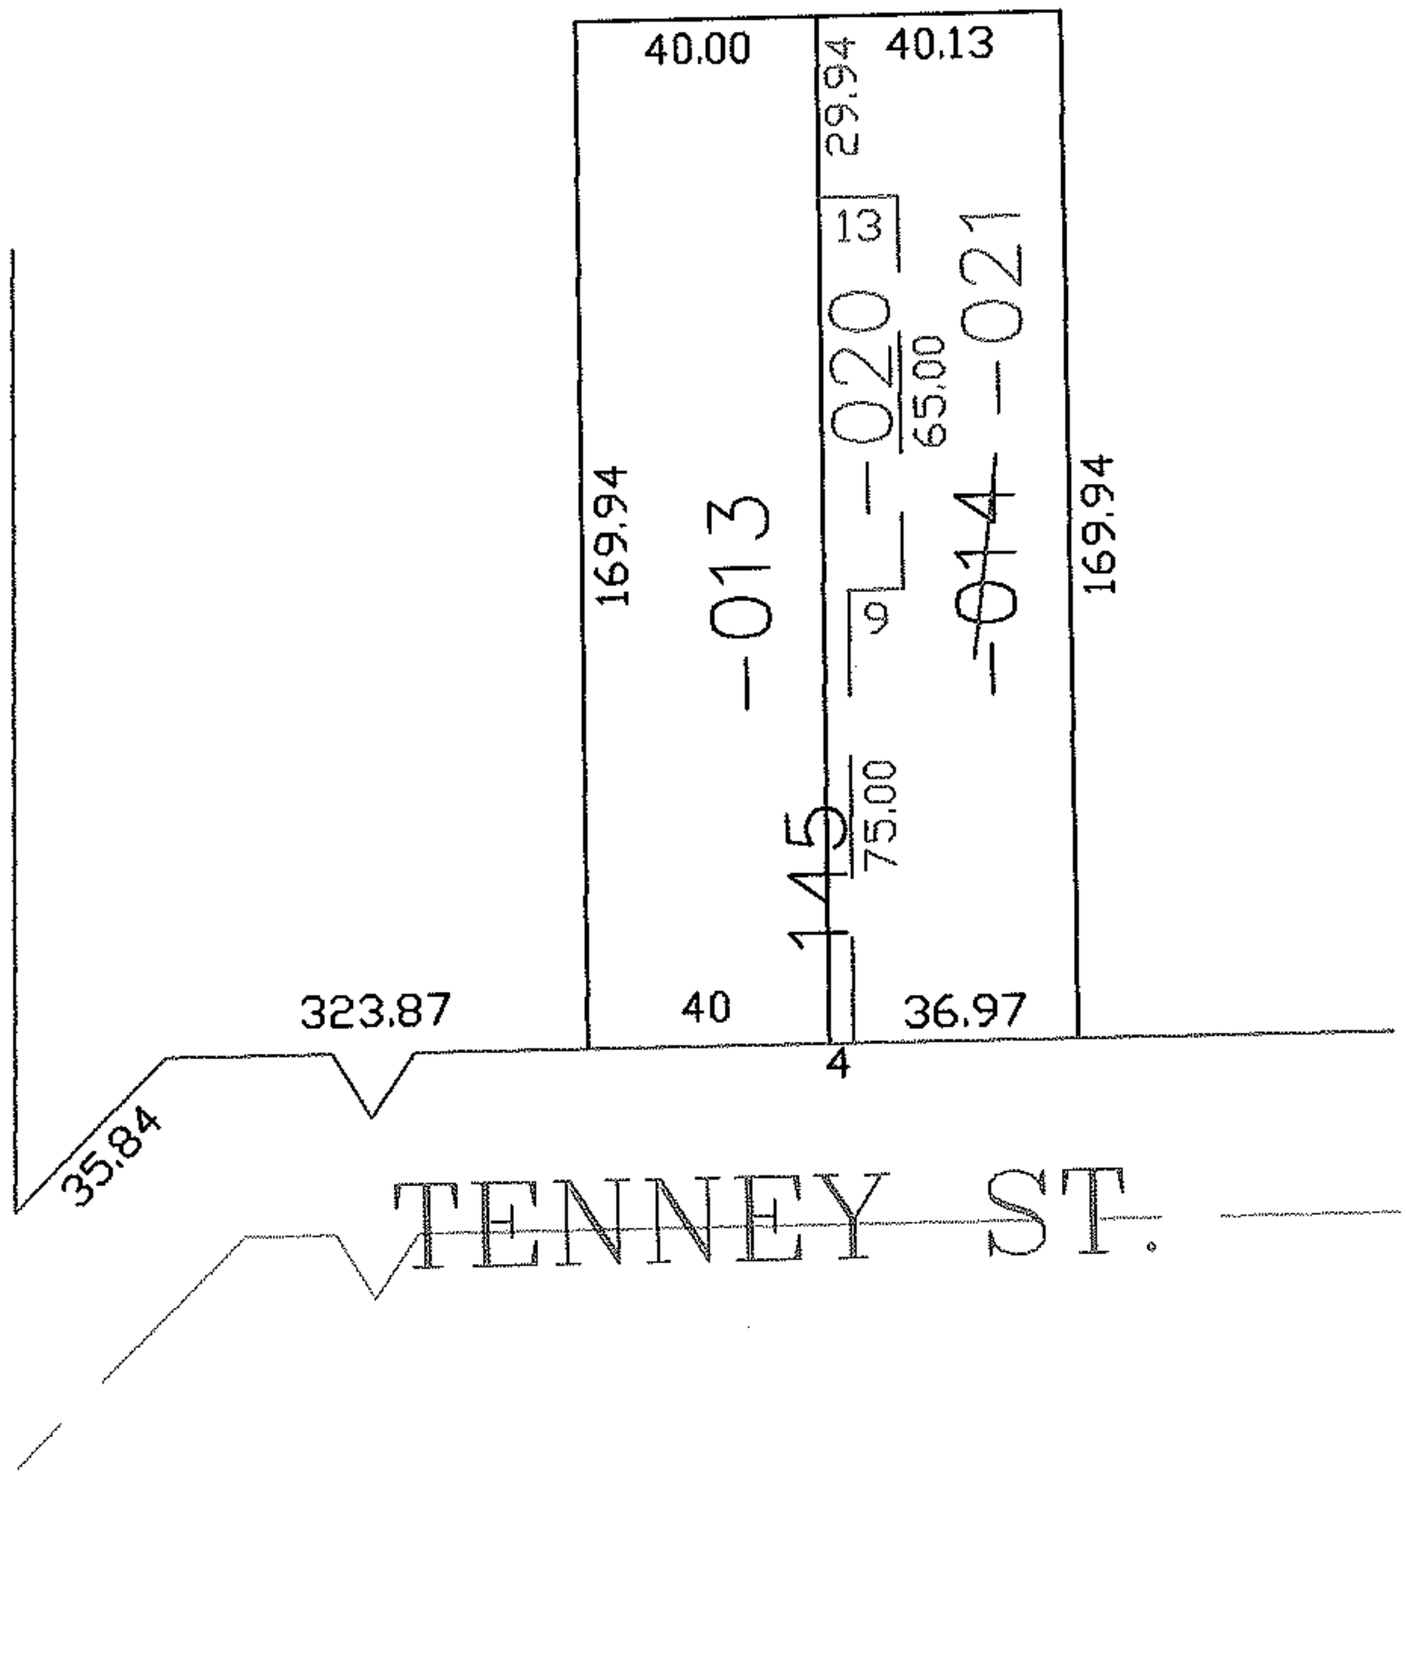

SPLITS/DEEDS PROCESSED

LORAIN COUNTY TAX MAP DEPARTMENT
226 MIDDLE AVE. ELYRIA, OHIO

SURVEYED BY: MICHAEL STRAUB

CLOSURE: 0.00 : 10,000

MAP PAGE(S): 05-00-024-B

APPROVED BY: JAH DATE: 5-16-05

SCALE: 1"= 100 PRIOR INSTRUMENT: 20030906393