RASTER

PARENT PARCEL: SEE BELOW

CHILD PARCEL: XX-XX-XXX-XXX-XXX

STARTING POINT: XXXXXX

09-01937-C

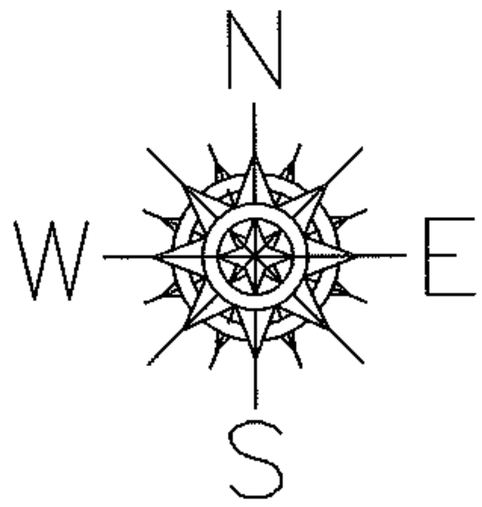

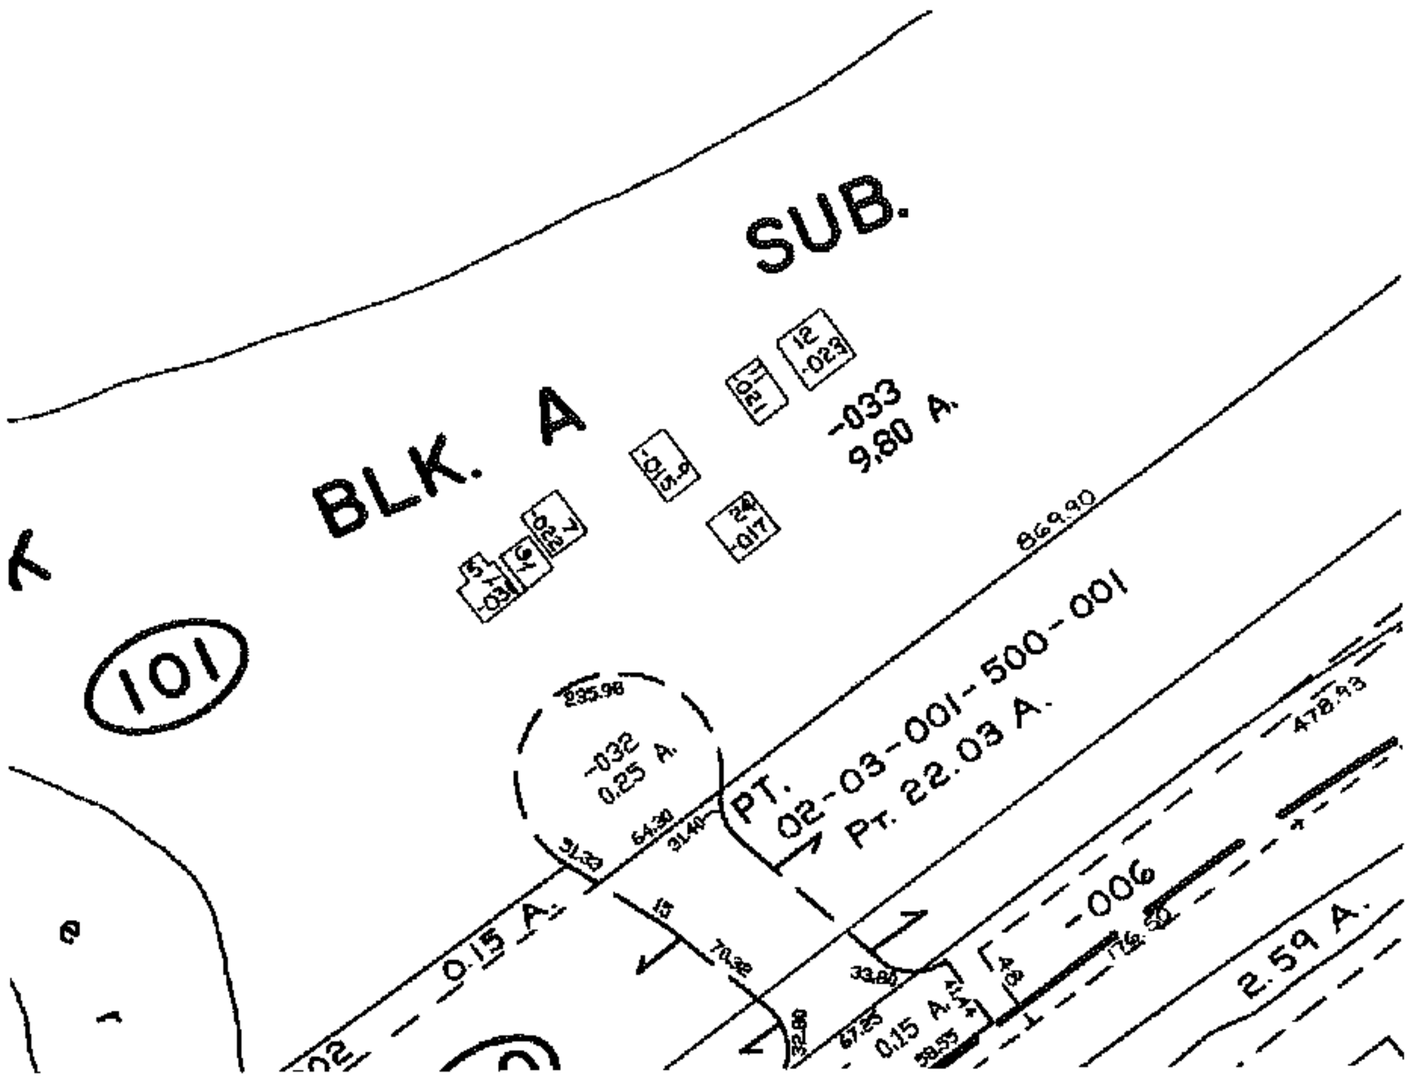

DROP FROM DUPLICATE

02-03-002-101-005
02-03-002-101-006
02-03-002-101-007
02-03-002-101-008
02-03-002-101-010
02-03-002-101-011
02-03-002-101-012
02-03-002-101-013
02-03-002-101-014
02-03-002-101-016
02-03-002-101-020
02-03-002-101-024
02-03-002-101-028
02-03-002-101-029

BUILDINGS NO LONGER EXIST

SPLITS/DEEDS PROCESSED

LORAIN COUNTY TAX MAP DEPARTMENT
226 MIDDLE AVE. ELYRIA, OHIO

SURVEYED BY: NONE

CLOSURE: NONE

MAP PAGE(S): 02-03-002-A

APPROVED BY: TJS DATE: 12/22/09

SCALE: 1"= 100 PRIOR INST.: DV XXXX/XXX