10-01943-C

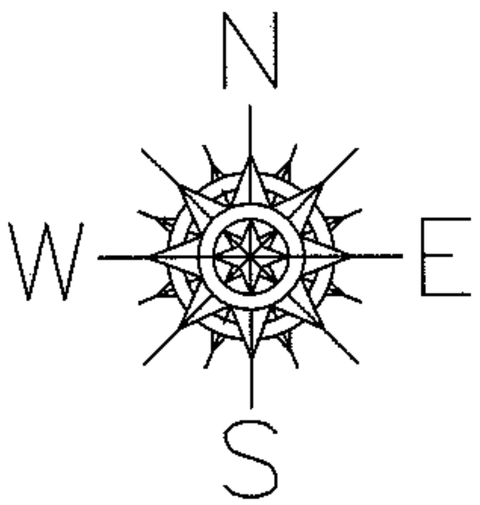

PARENT PARCEL: 03-00-083-101-041

CHILD PARCEL: XX-XX-XXX-XXX-XXX

STARTING POINT: STONE MON. FD. 0.44 FEET NORTH OF CL OF E. 28TH ST. & CL OF GROVE AVE.

ADD TO DUPLICATE

03-00-083-108-016

0.36 A.

ADD PER DEED

INST. # 19990592560

ACREAGE CORRECTION

03-00-083-101-041

~~10.97 A.~~

10.61 A.

CORR. PER DEED

INST. # 19990592560

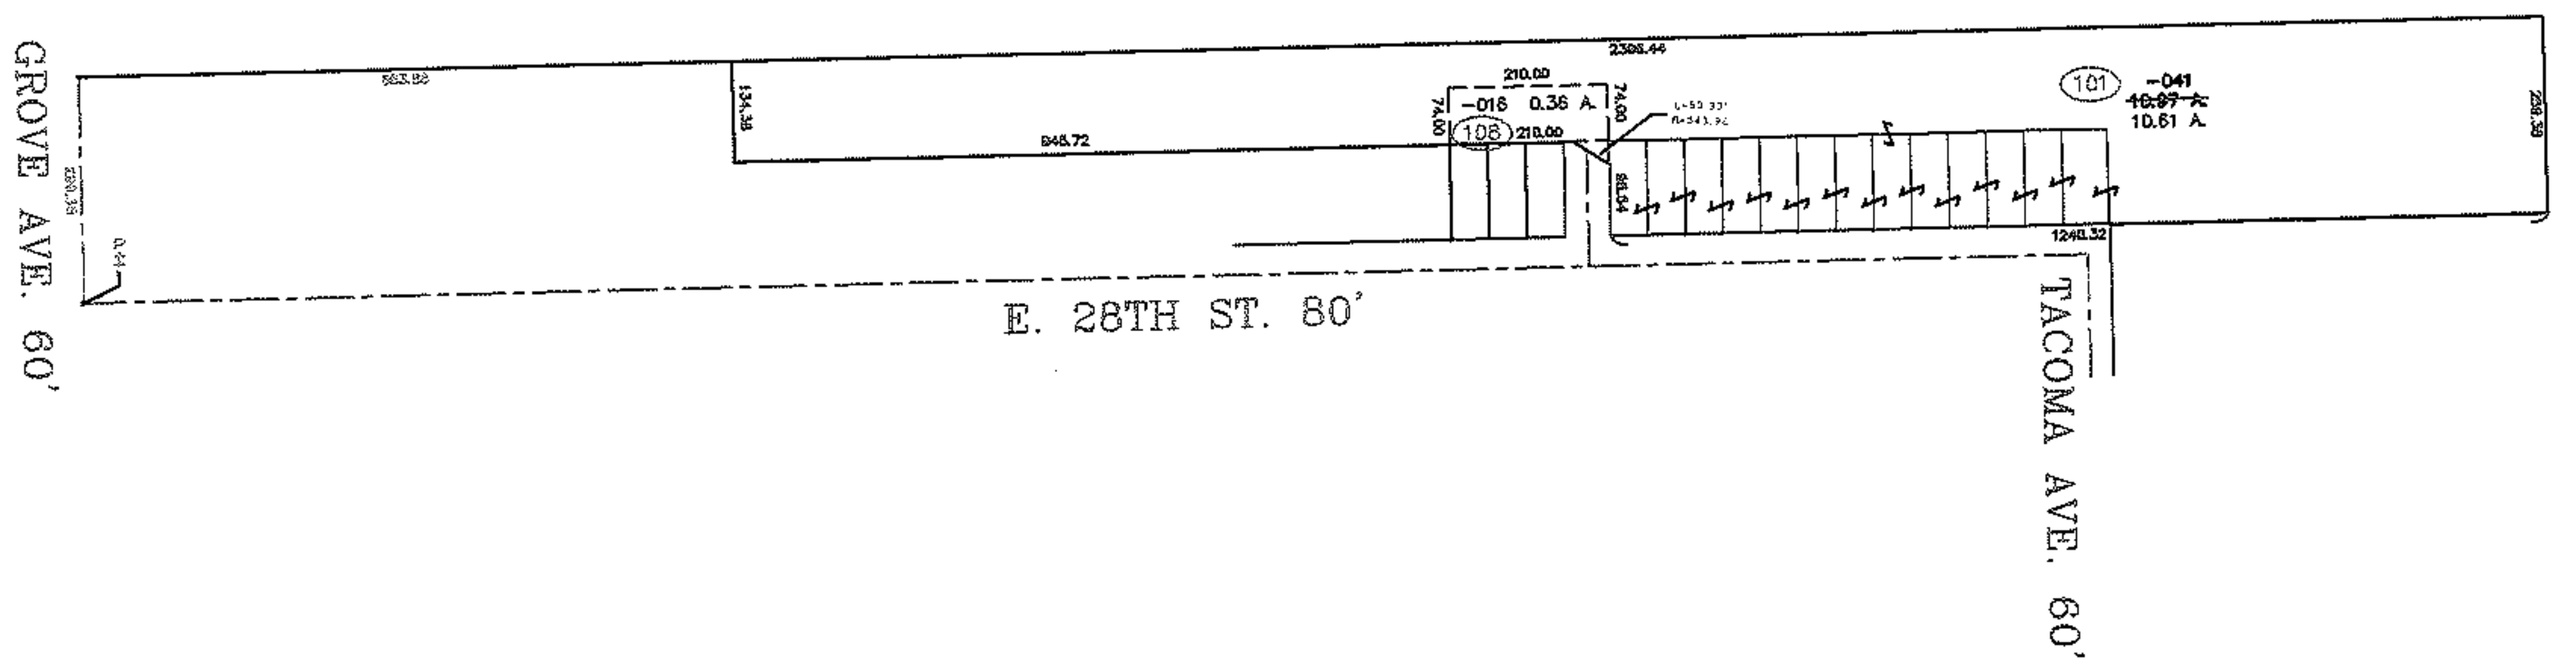

SURVEYED BY: MICHAEL STRAUB

CLOSURE: 0.02 : 10,000

MAP PAGE(S): 3-00-081-A & B

APPROVED BY: TJS DATE: 1/8/10

SCALE: 1"= 400 PRIOR INSTRUMENT: 200802771 6

SPLITS/DEEDS PROCESSED

LORAIN COUNTY TAX MAP DEPARTMENT

226 MIDDLE AVE. ELYRIA, OHIO