RASTER

PARENT PARCEL: 18-00-042-000-002
CHILD PARCEL: 18-00-042-000-012 THRU -014
STARTING POINT: CENTERLINE OF PECK-WADSWORTH RD. & PITTS RD.

NO. 01951

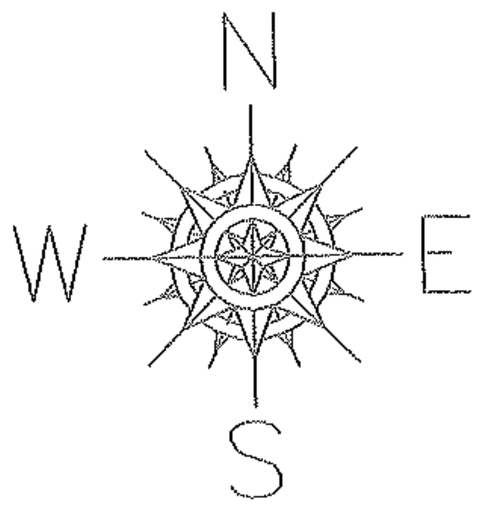

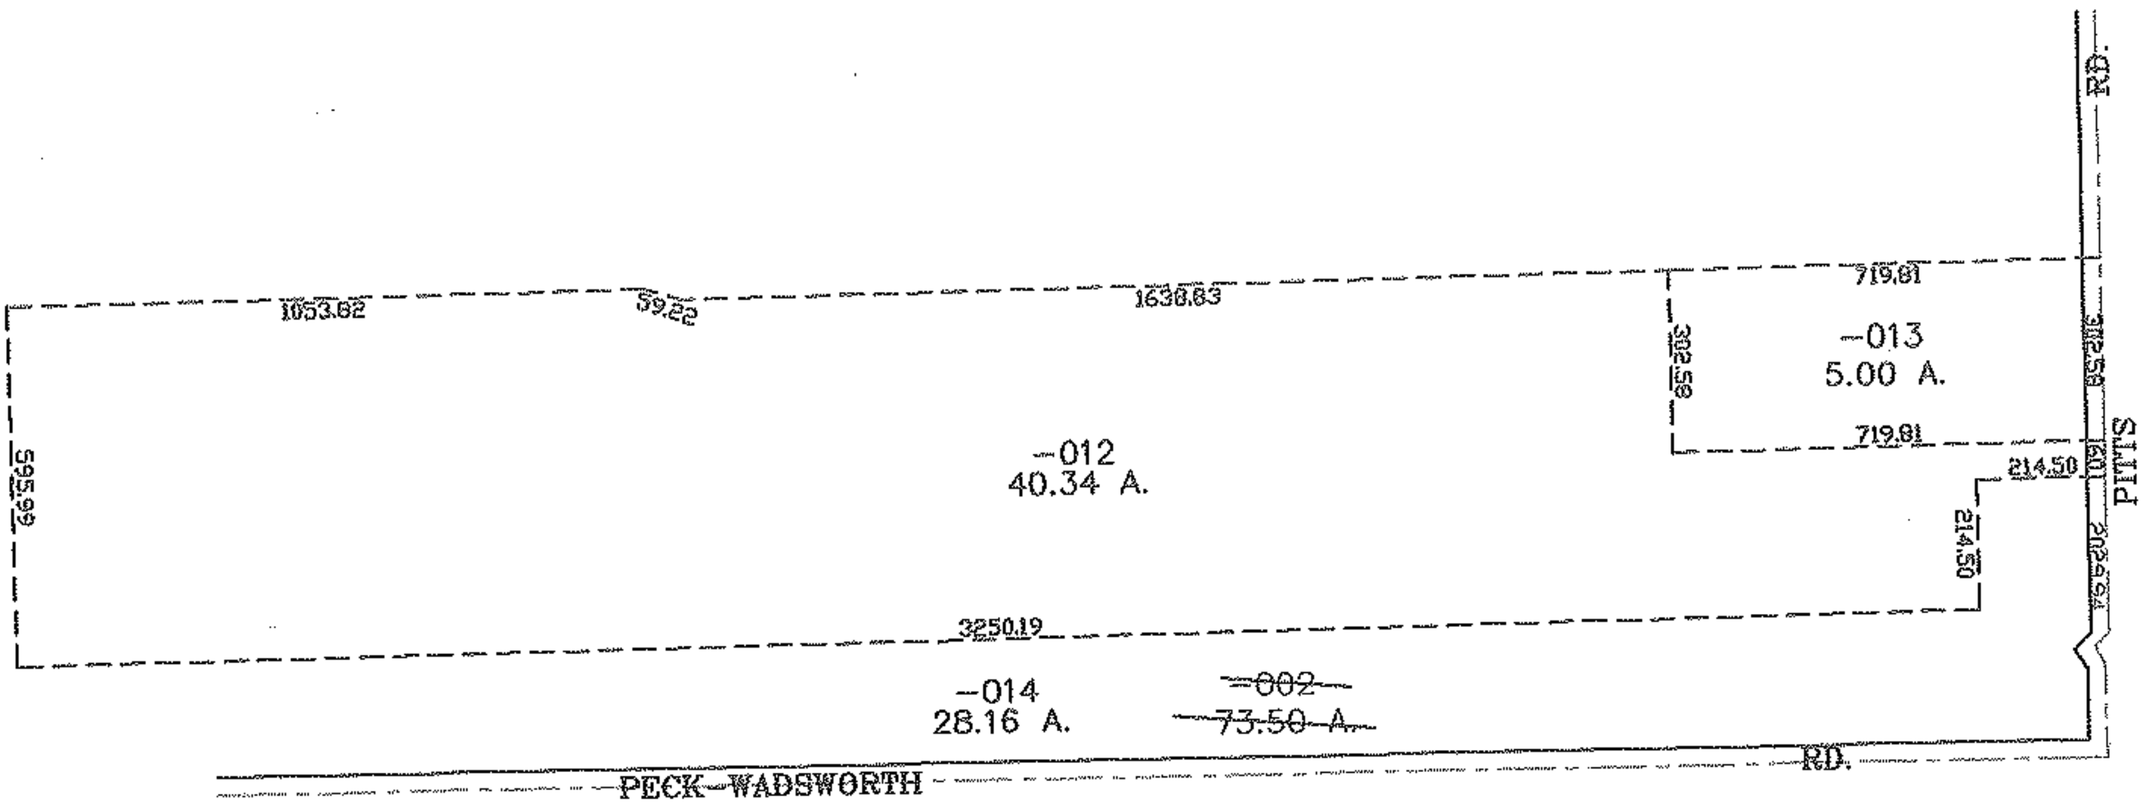

SPLITS/DEEDS PROCESSED

LORAIN COUNTY TAX MAP DEPARTMENT
226 MIDDLE AVE. ELYRIA, OHIO

SURVEYED BY: THOMAS SNEZEK
CLOSURE: 0.00 : 10,000
MAP PAGE(S): 18-00-042-A, B
APPROVED BY: JAH DATE: 7-7-05
SCALE: 1"= 500 PRIOR INSTRUMENT: 20050071017