RASTER

PARENT PARCEL: 11-00-090-000-041, -039 11-00-071-000-101, 103

CHILD PARCEL: 11-00-090-000-042, 11-00-071-000-105

STARTING POINT: CENTERLINE OF BENDER RD. & CHESTNUT RIDGE RD.

NO. 01952

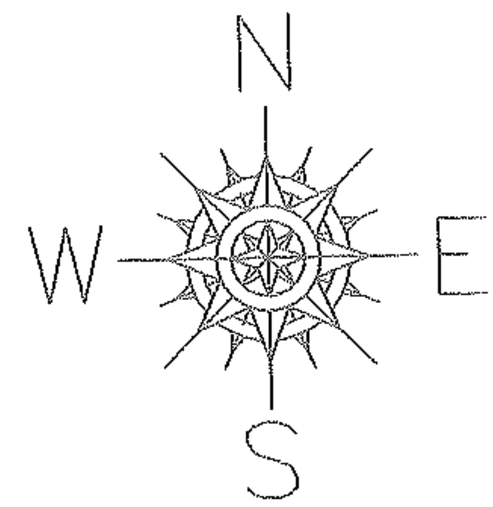

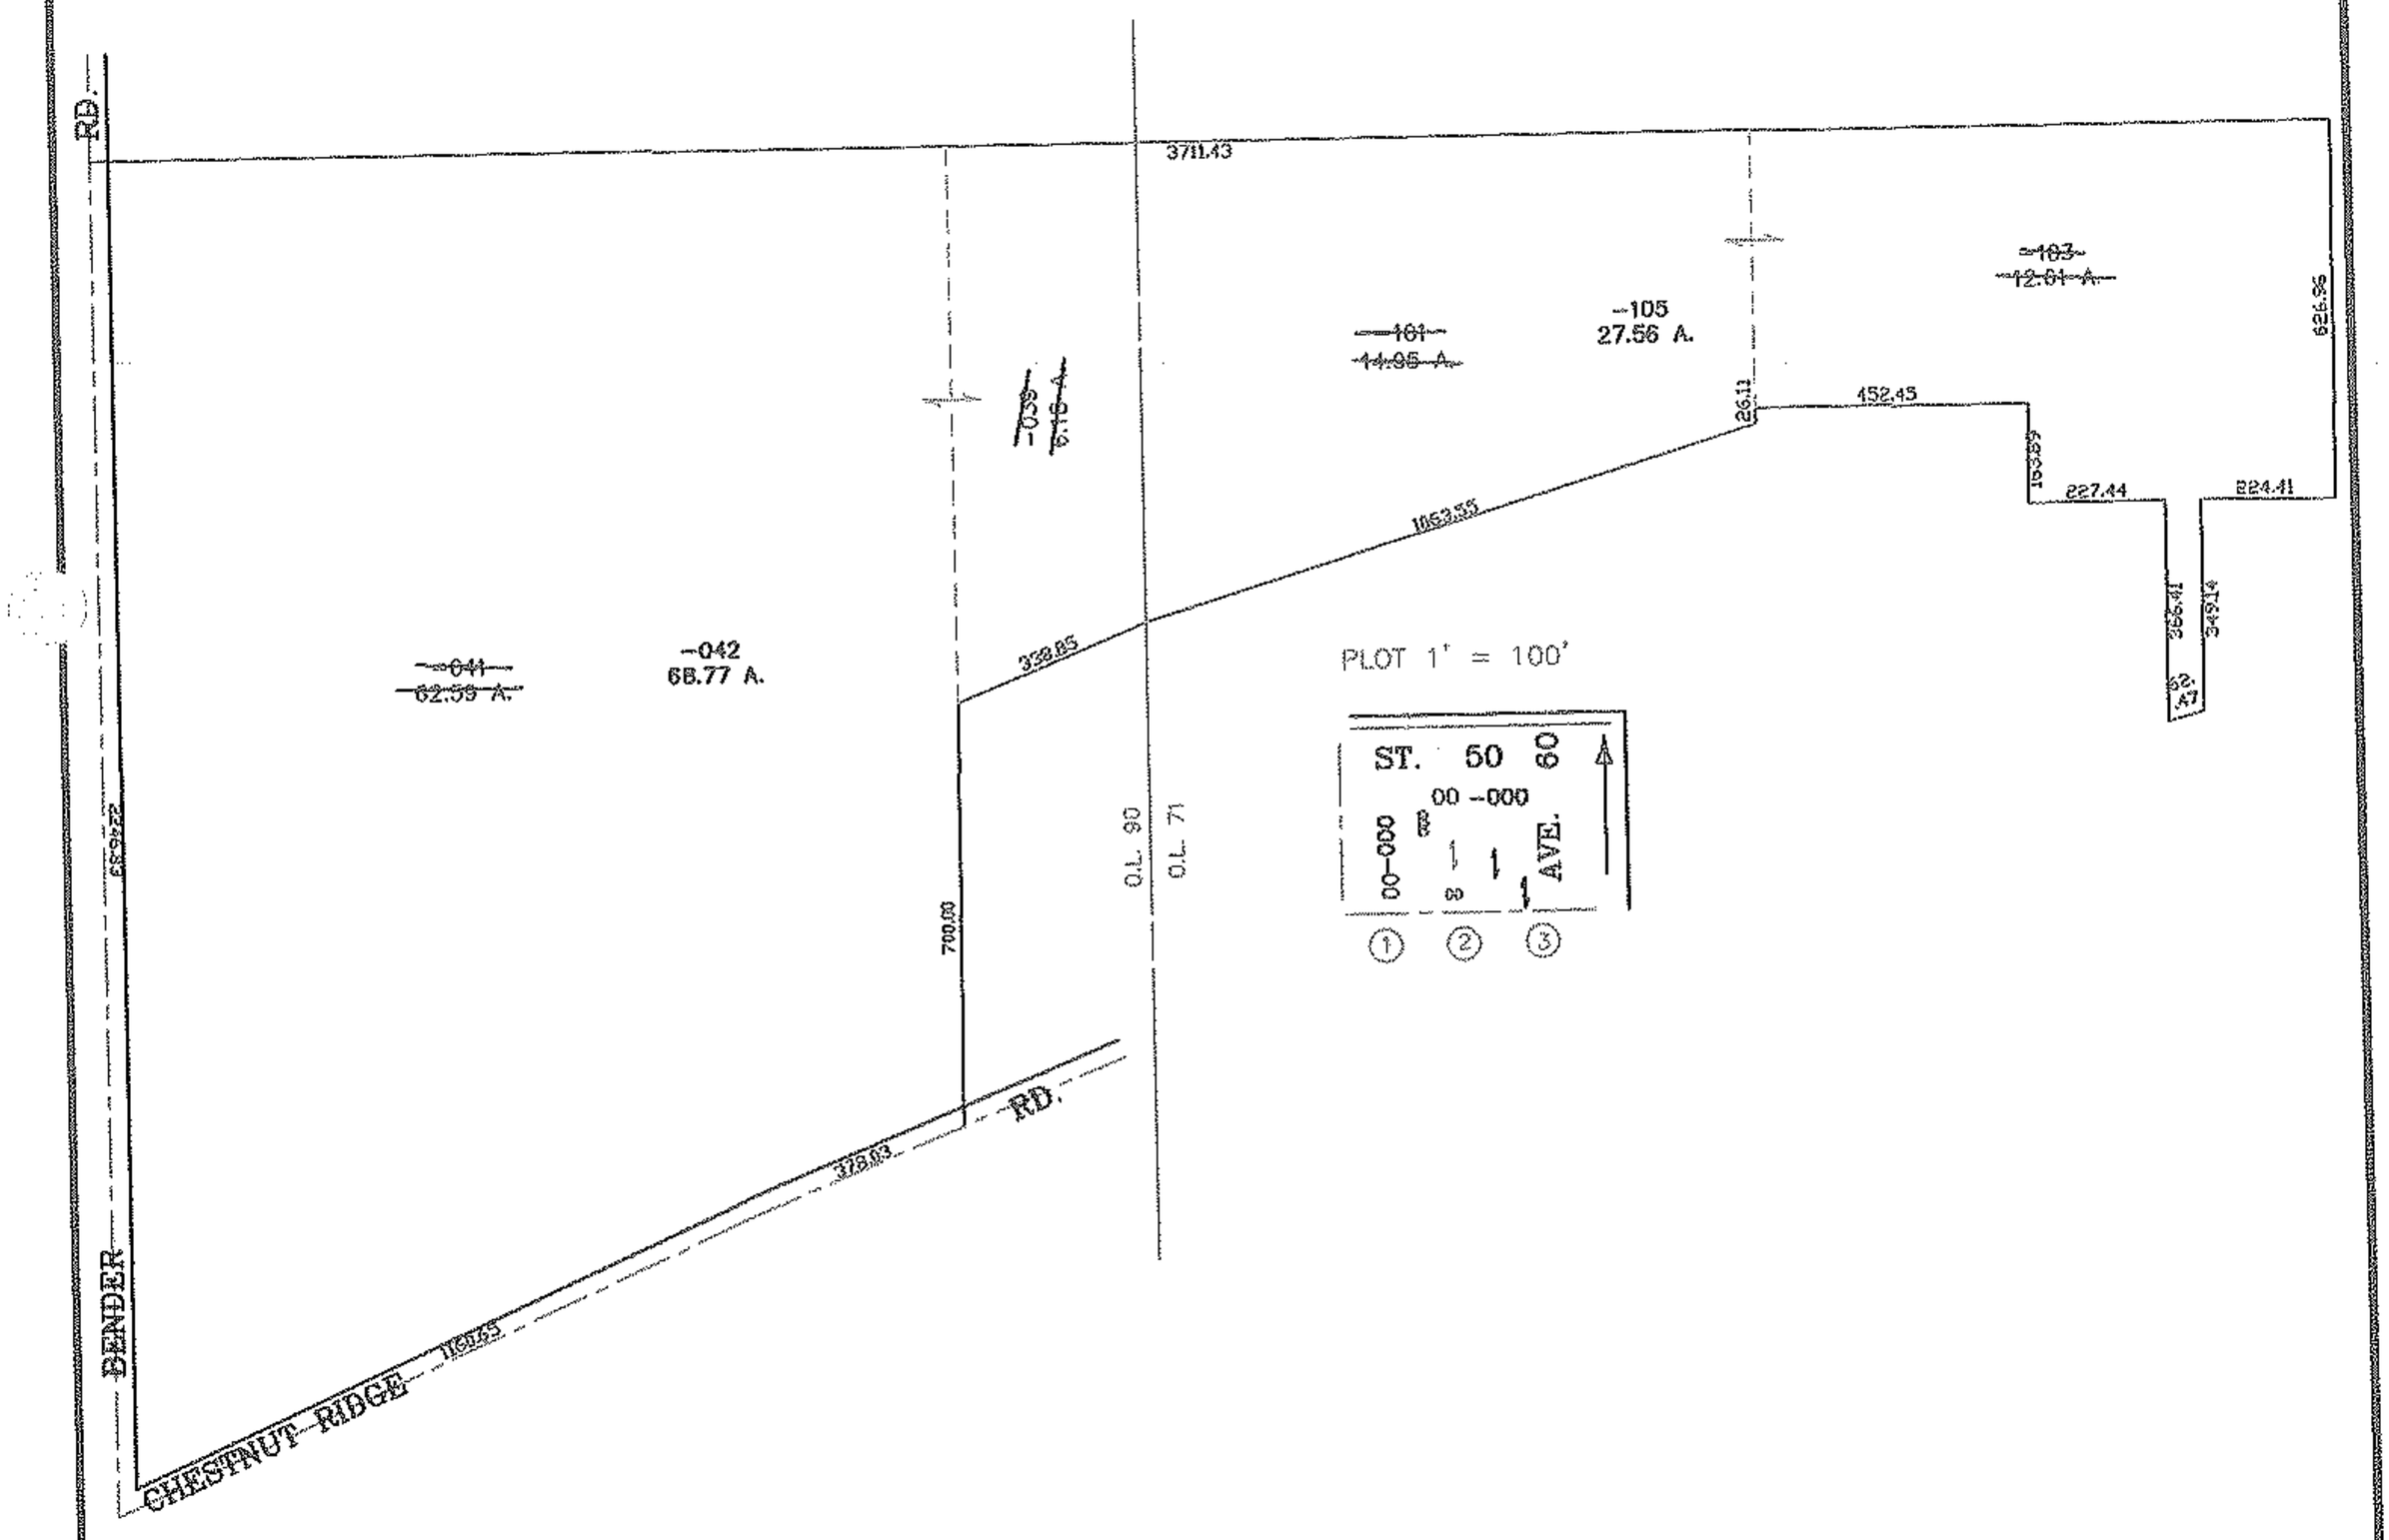

SPLITS/DEEDS PROCESSED

LORAIN COUNTY TAX MAP DEPARTMENT
226 MIDDLE AVE. ELYRIA, OHIO

SURVEYED BY: KENNETH L. BOHNING

CLOSURE: 0.00 : 10,000

MAP PAGE(S): 11-A, 11-00-071-A

APPROVED BY: JAH DATE: 7-11-05

SCALE: 1"= 500 PRIOR INSTRUMENT: 20020810718