RASTER

PARENT PARCEL: 04-00-025-000-014, -015, -217, -218
CHILD PARCEL: 04-00-025-000-348 THRU -355
STARTING POINT: INTERSECTION OF SAVANNAH TRAIL & SOUTHERLY LINE OF AUGUSTA WOODS SUBD.

NO. 01975

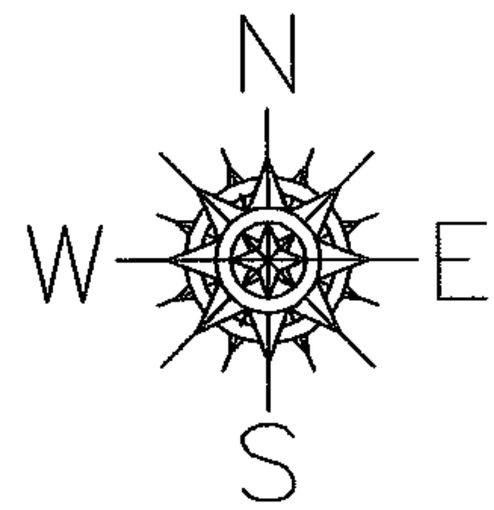

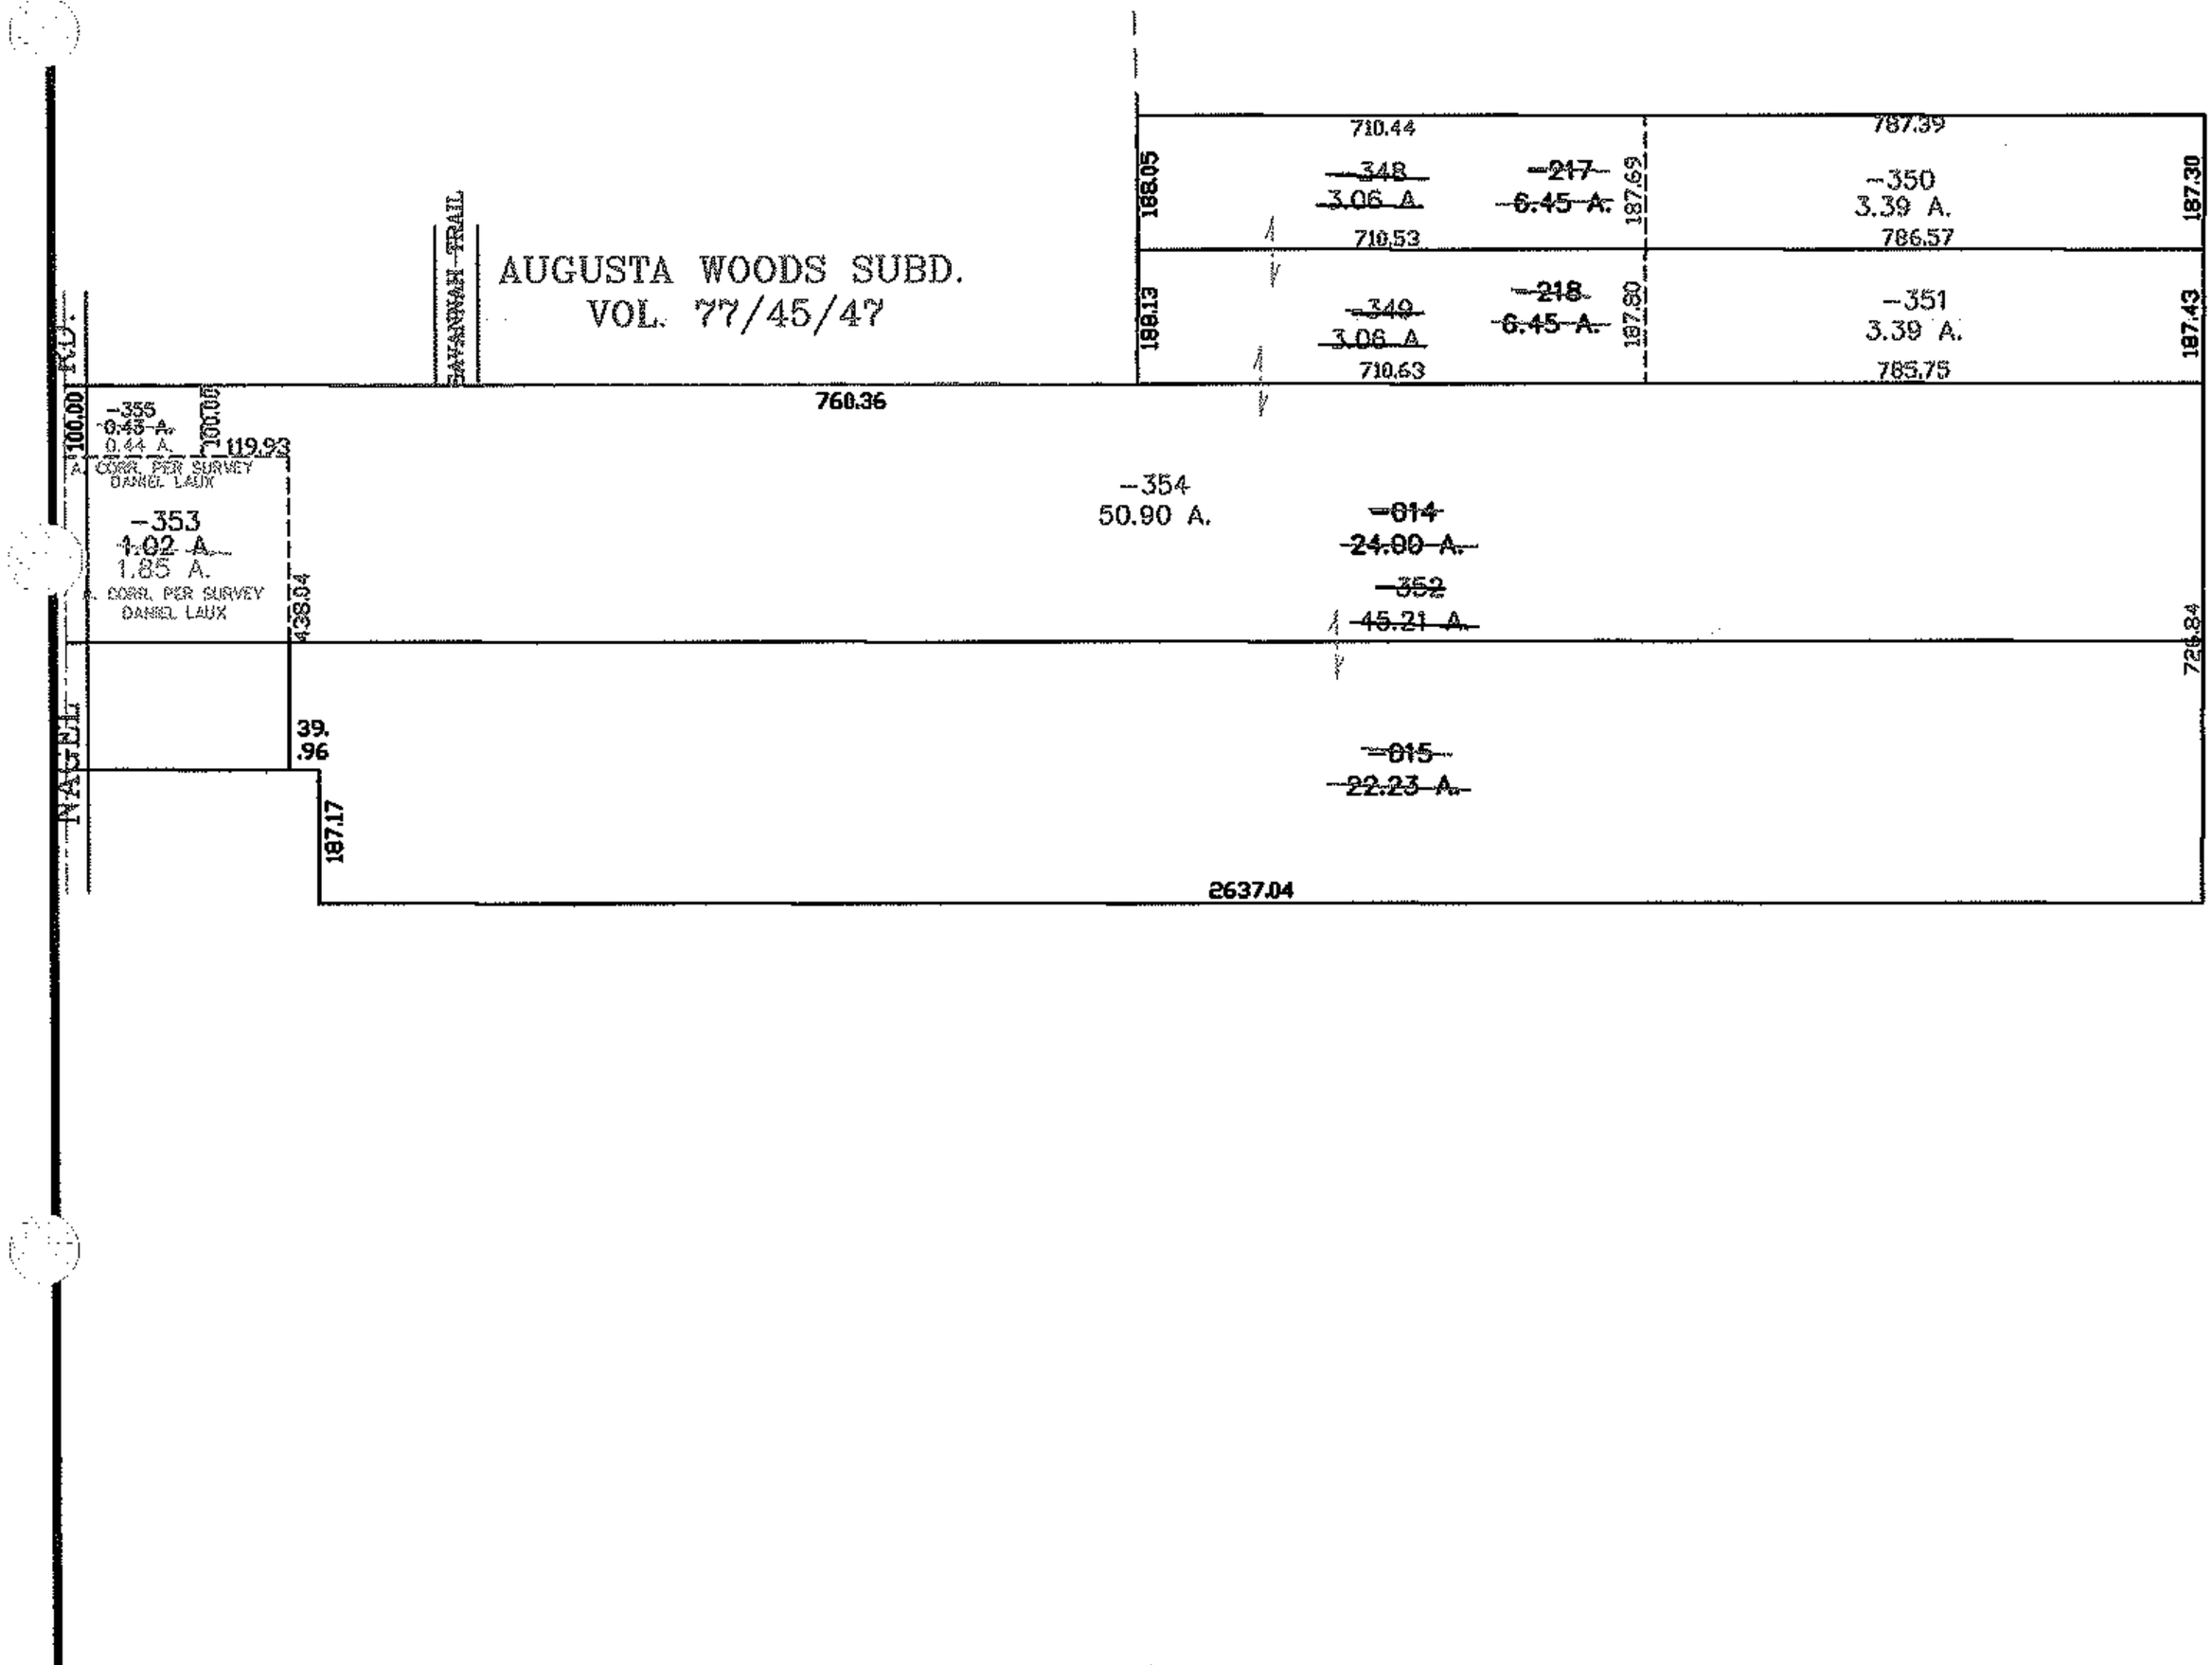

SPLITS/DEEDS PROCESSED
LORAIN COUNTY TAX MAP DEPARTMENT
226 MIDDLE AVE. ELYRIA, OHIO

SURVEYED BY: DANIEL LAUX
CLOSURE: 0.00 : 10,000
MAP PAGE(S): 04-00-025-B
APPROVED BY: JAH DATE: 8-9-05
SCALE: 1"= 400 PRIOR INSTRUMENT: 20030949050