RASTER

PARENT PARCEL: 03-00-060-000-009

CHILD PARCEL: 03-00-060-000-048, -049

STARTING POINT: CENTERLINE OF LAKE BREEZE RD & COLORADO AVE

NO. 01980

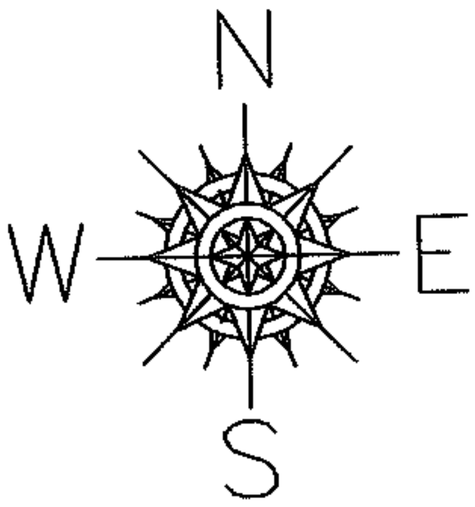

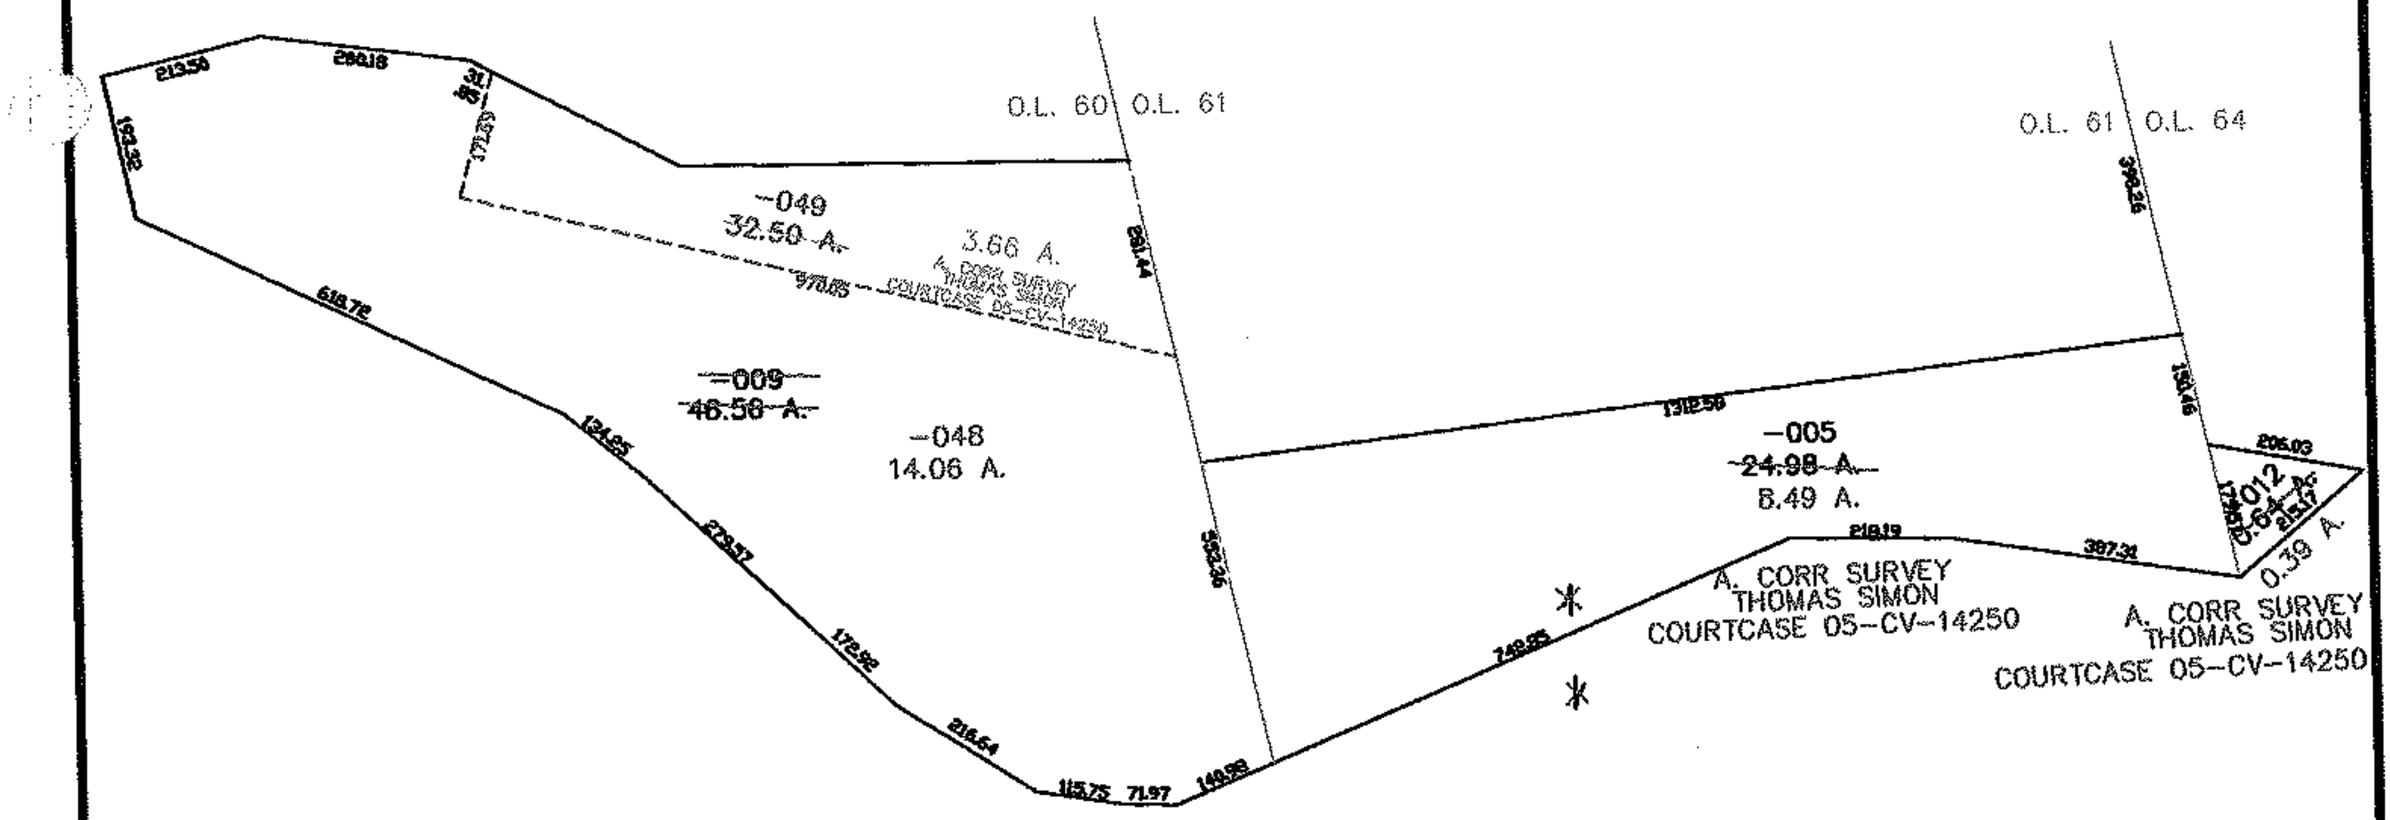

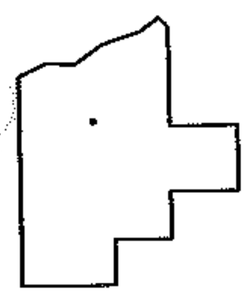

SPLITS/DEEDS PROCESSED

LORAIN COUNTY TAX MAP DEPARTMENT
226 MIDDLE AVE. ELYRIA, OHIO

SURVEYED BY: THOMAS SIMON

CLOSURE: 0.00 : 10,000

MAP PAGE(S): 03-00-061-B

APPROVED BY: JAH DATE: 8-12-05

SCALE: 1"= 400 PRIOR INSTRUMENT: CC 05CV14250