


PARENT PARCEL: 06-24-051-106-001

CHILD PARCEL: _____

STARTING POINT: XXXXXX

10-01994-C

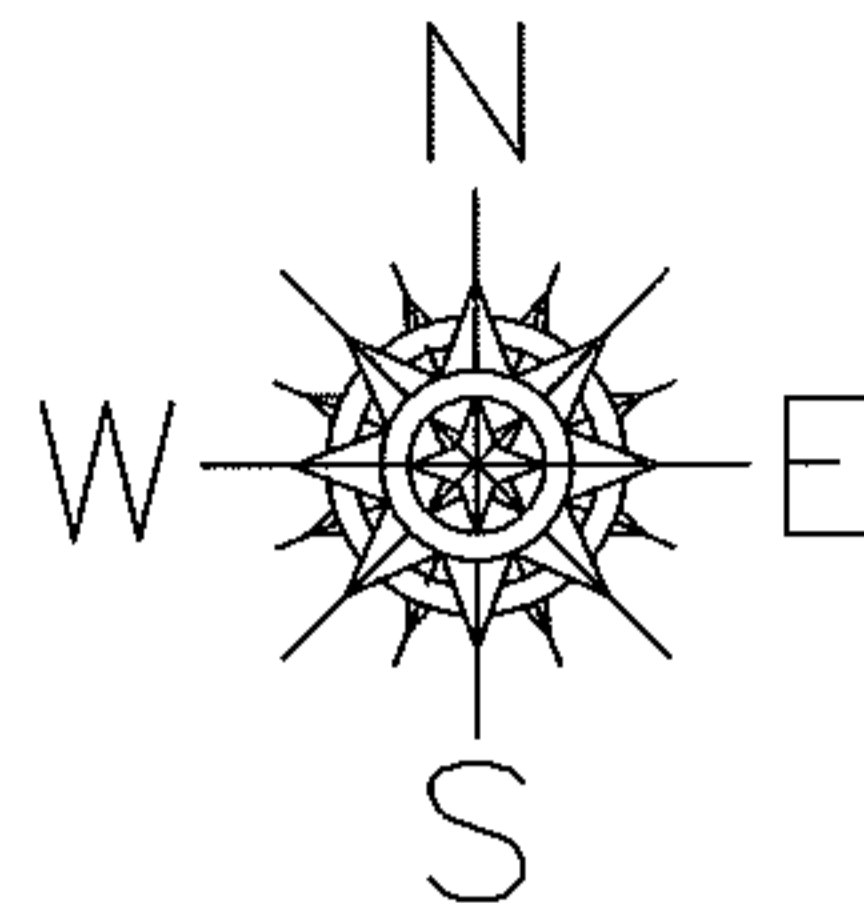


FRONTAGE CORRECTION

06-24-051-106-001

72.80 X -----

~~72.90 X -----~~

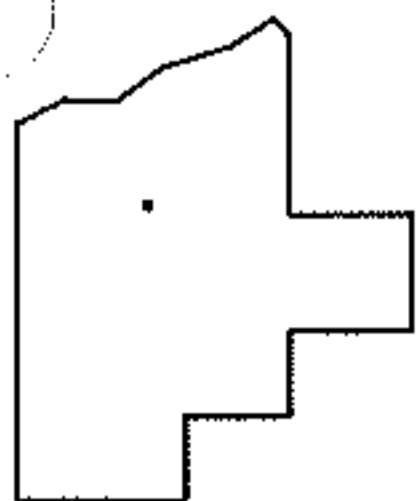

SPLITS/DEEDS PROCESSED

LORAIN COUNTY TAX MAP DEPARTMENT
226 MIDDLE AVE. ELYRIA, OHIO

SURVEYED BY: N/A

CLOSURE: N/A

MAP PAGE(S): 6-83

APPROVED BY: RRM DATE: 3-26-10

SCALE: 1"= 100 PRIOR INST.: 20050118878