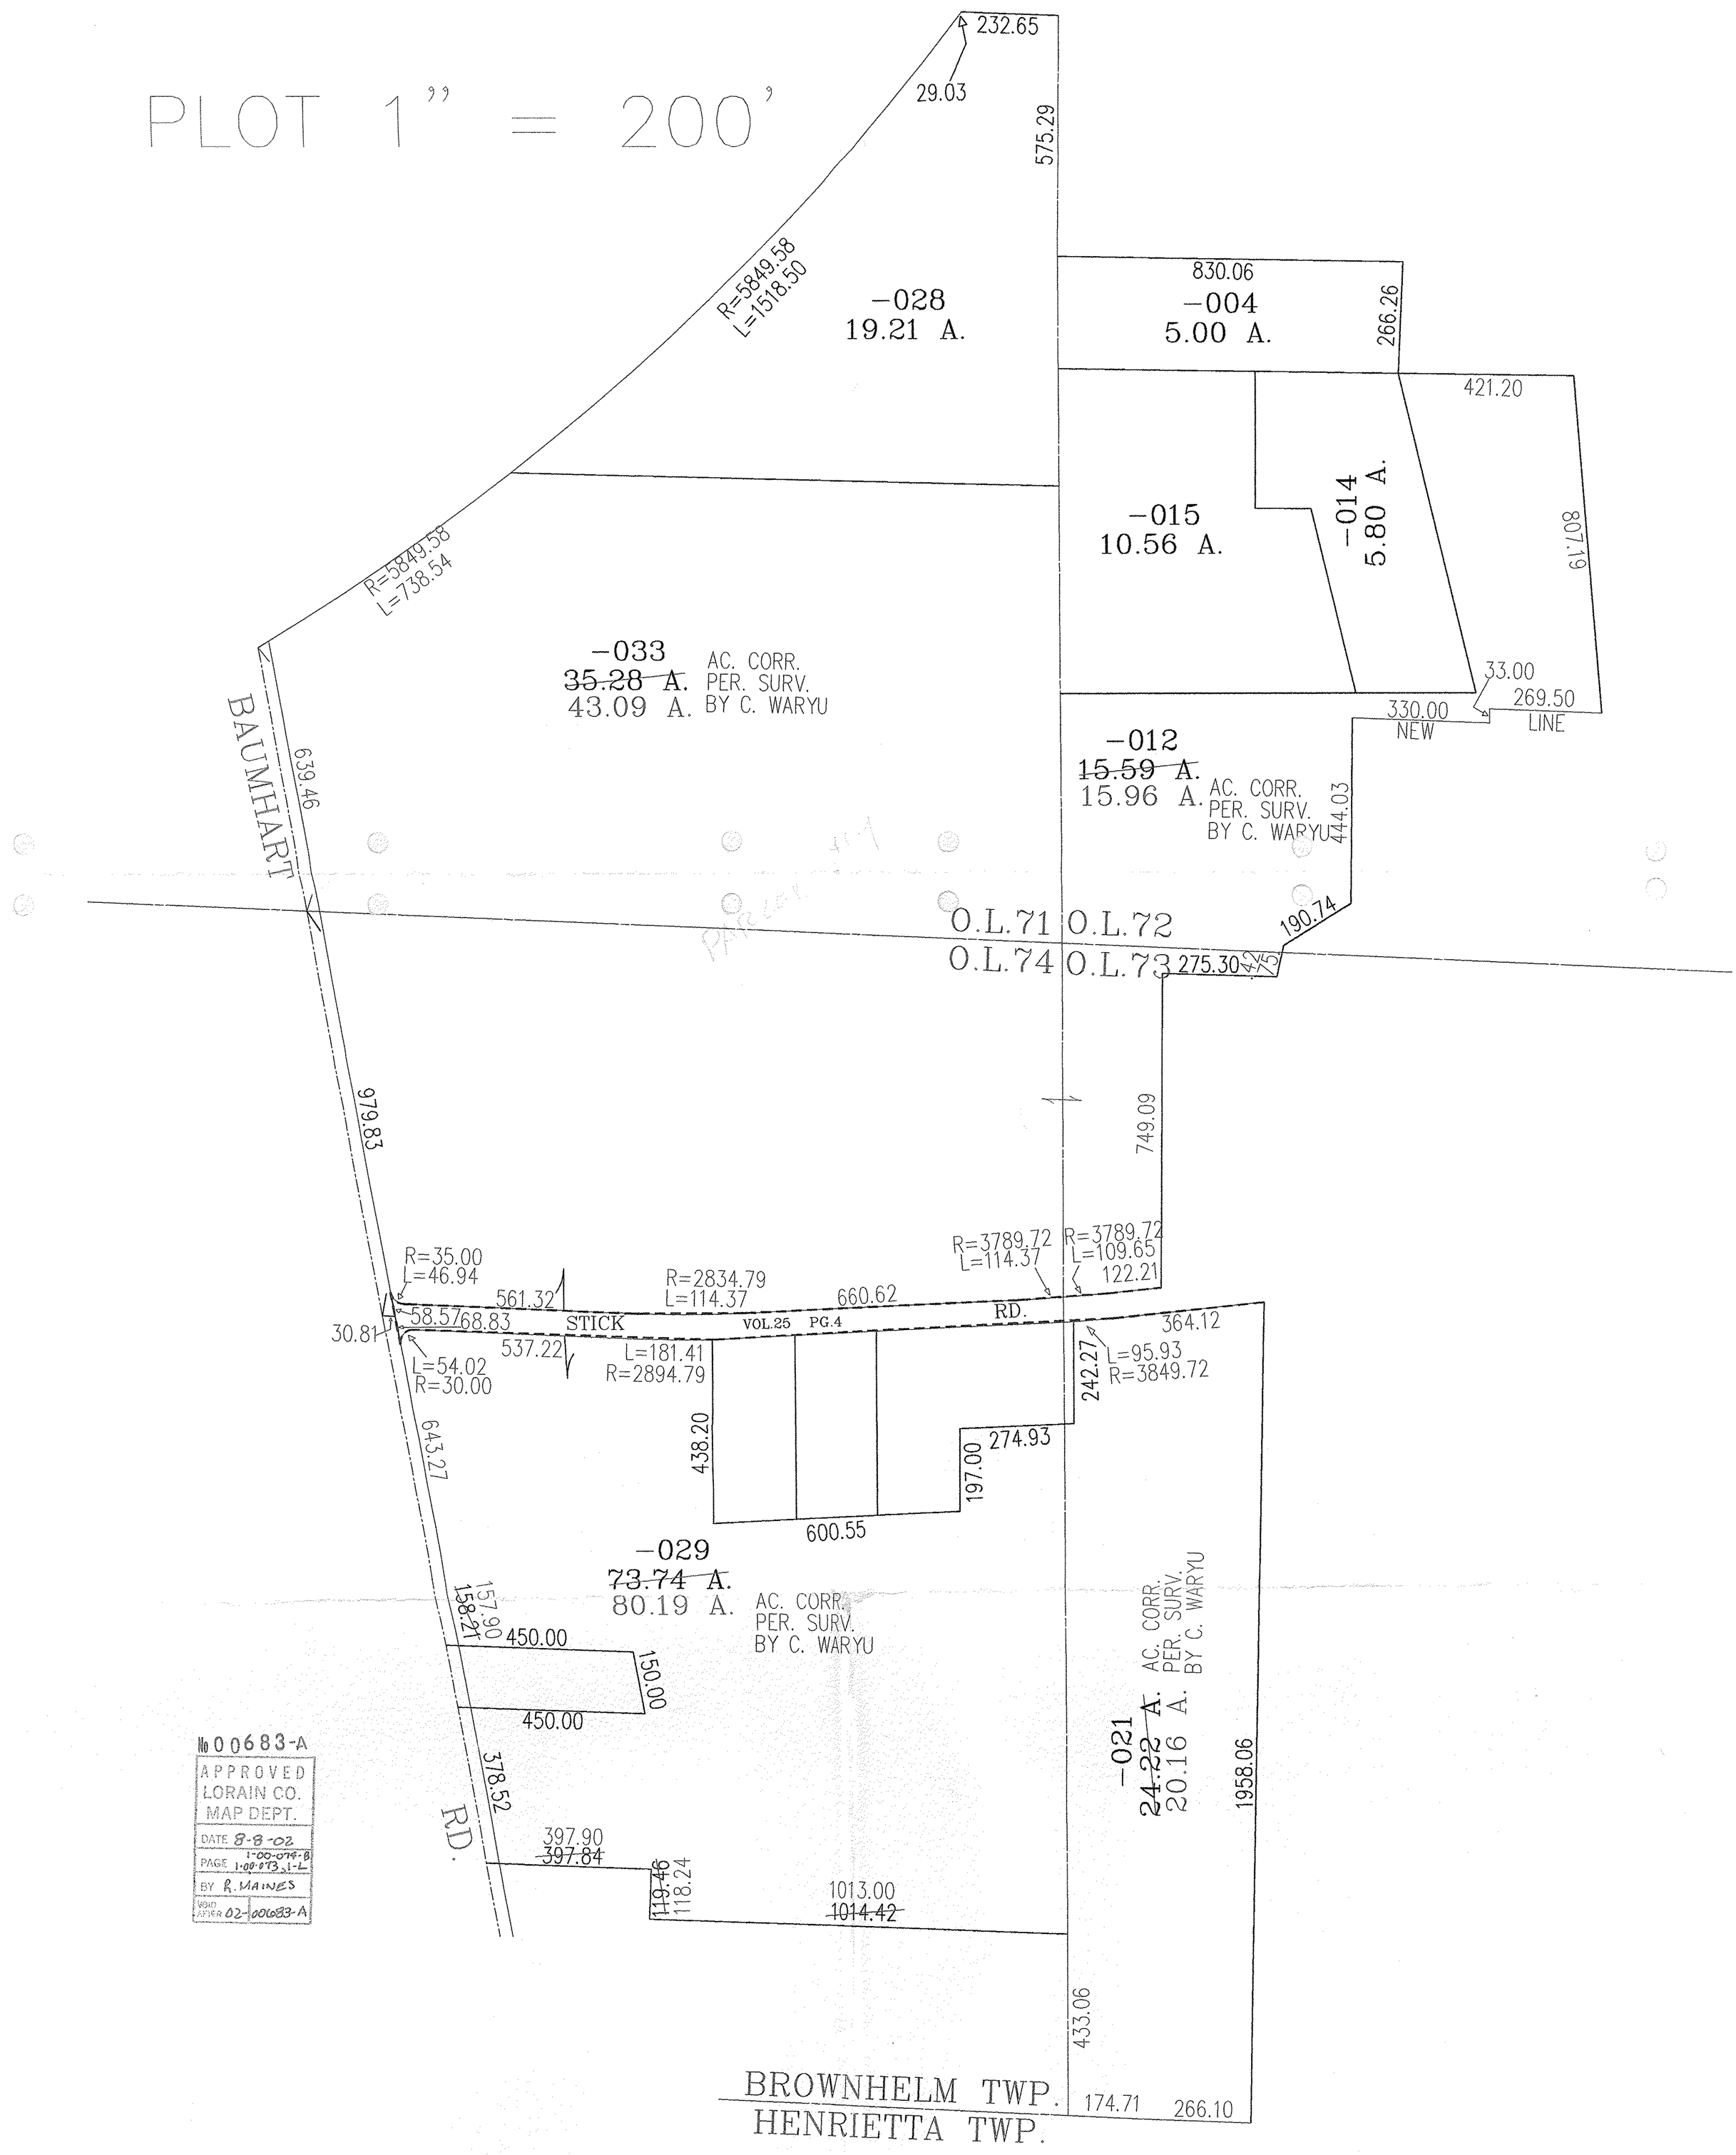

No 00683-A
APPROVED
LORAIN CO.
MAP DEPT.
DATE 8-8-02
PAGE 1-00-074-B 1-00-073, 1-L
BY R. MAINES
VOID AFTER 02-00683-A