RASTER

PARENT PARCEL: 15-00-031-000-057
CHILD PARCEL: 15-00-031-000-058, 15-00-032-000-017
STARTING POINT: MON. BOX, CENTERLINE OF INDIAN HOLLOW RD. & BIGGS RD.

NO. 00710-A

N
W E
S

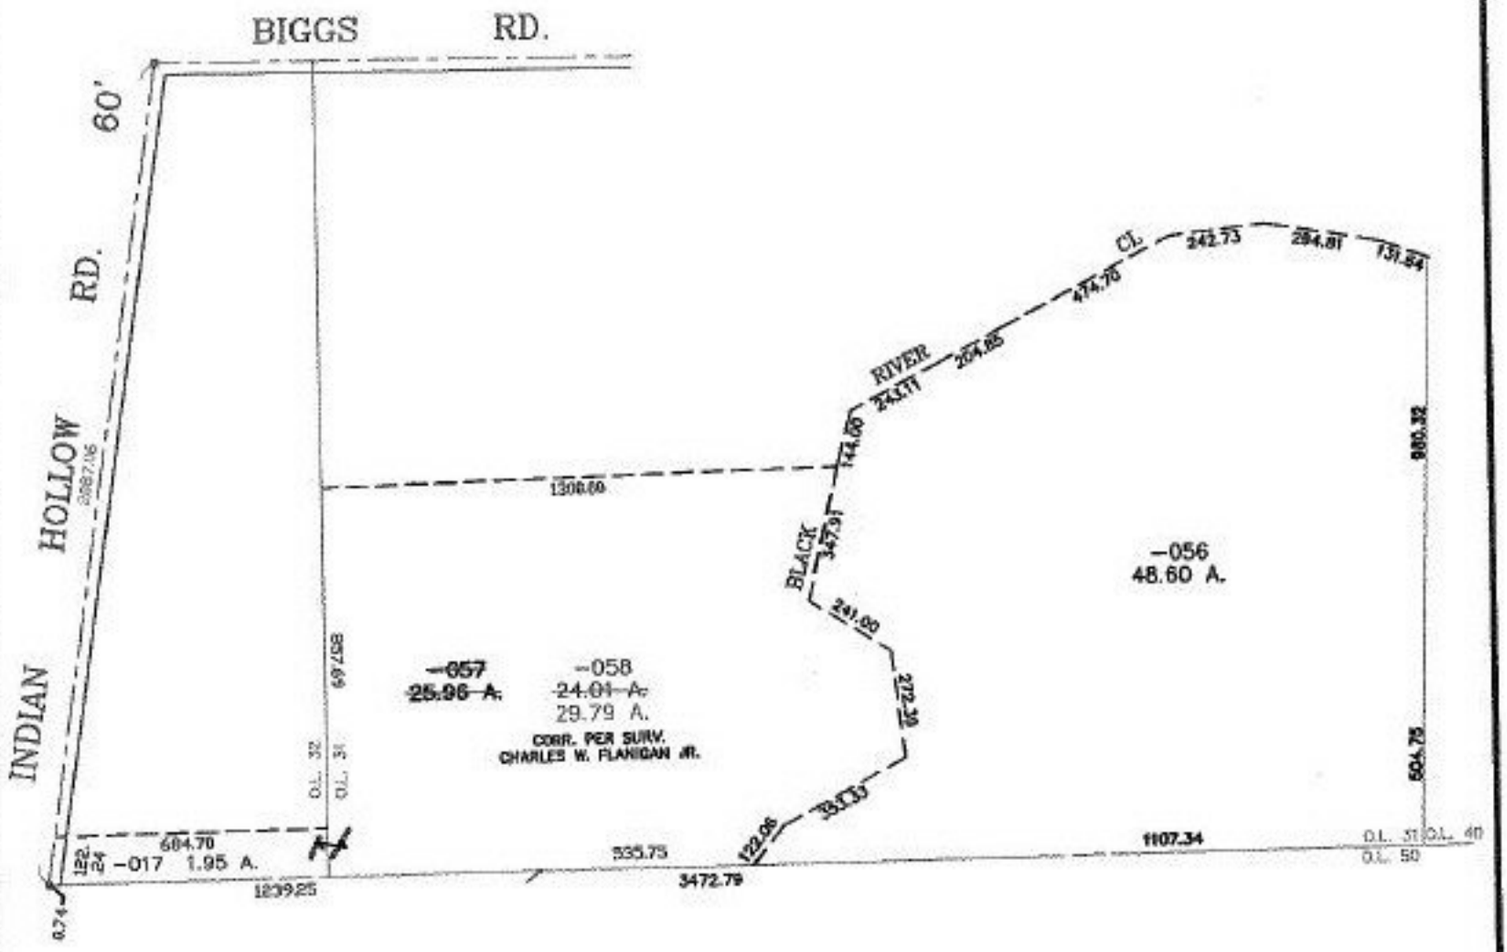

SPLITS/DEEDS PROCESSED

LORAIN COUNTY TAX MAP DEPARTMENT
226 MIDDLE AVE. ELYRIA, OHIO

SURVEYED BY: CHARLES FLANIGAN JR.
CLOSURE: 0.08 : 10,000
MAP PAGE(S): 15-D, 15-00-031-A
APPROVED BY: TJS DATE: 5/6/02
SCALE: 1"= 500 PRIOR INSTRUMENT: 199805649999